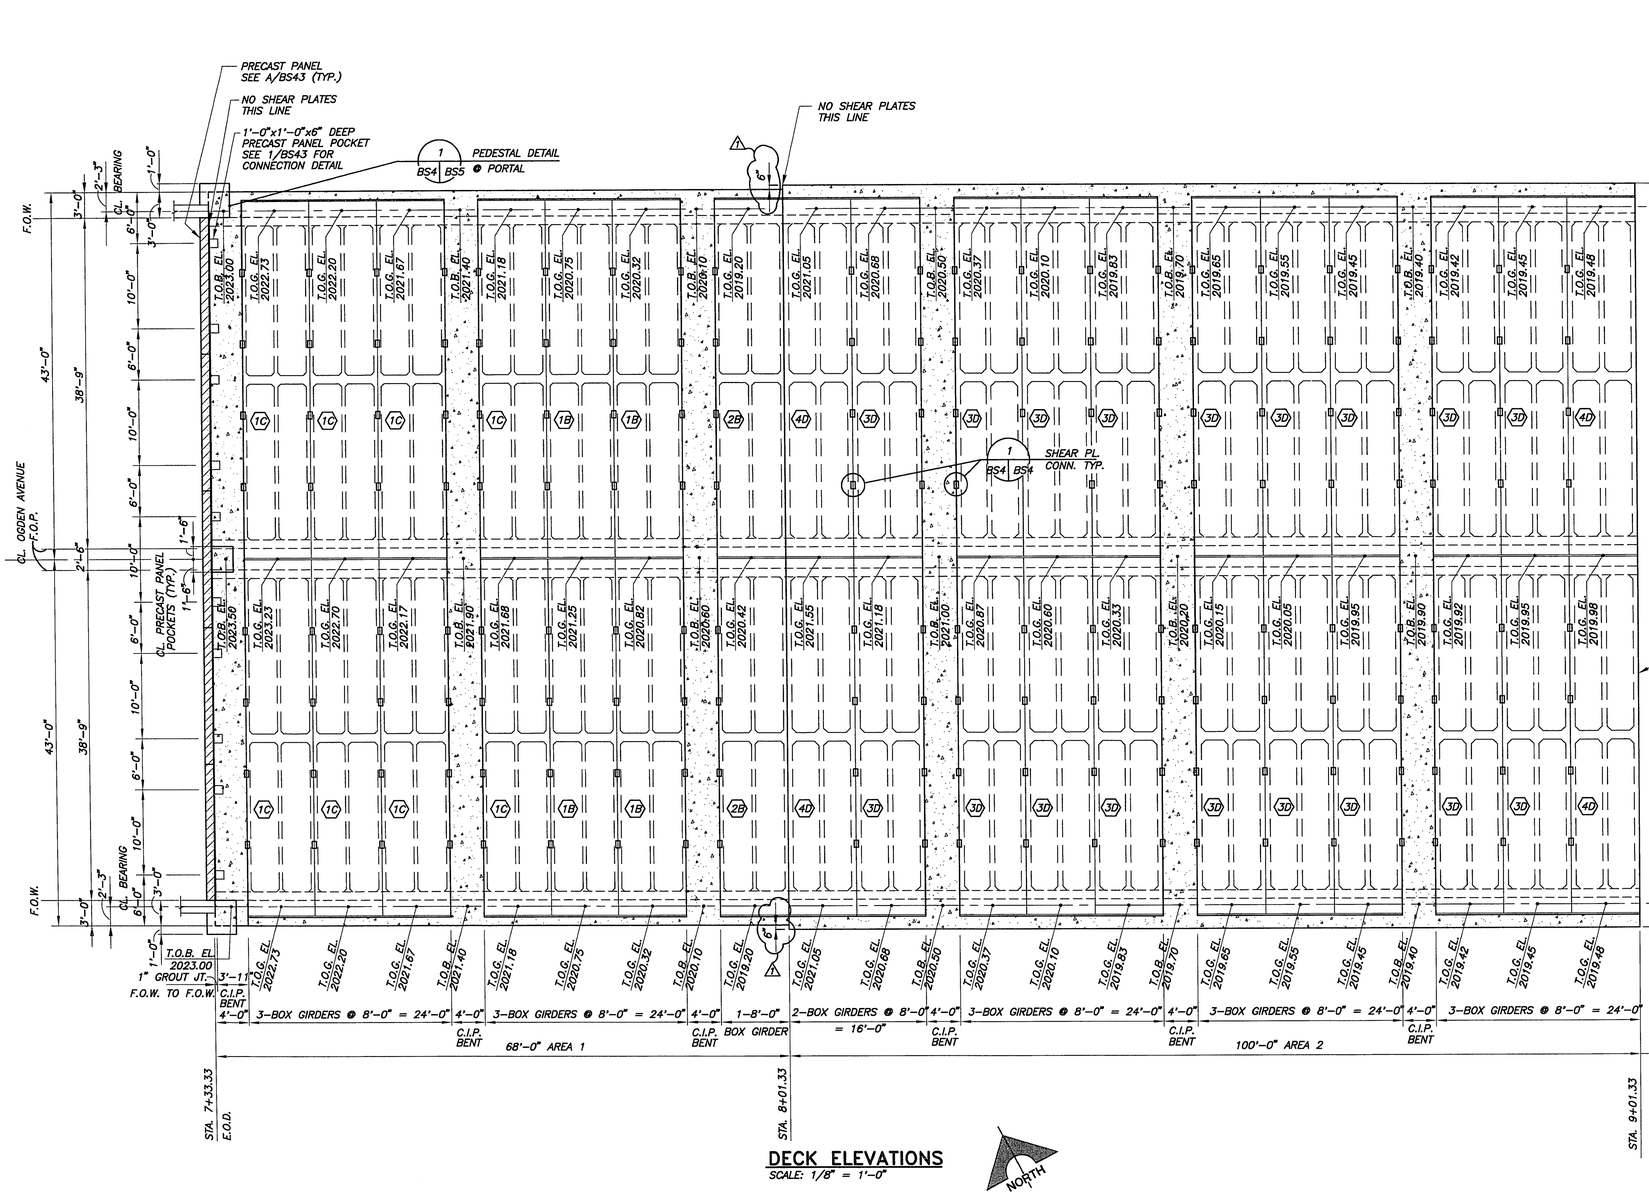

DECK ELEVATIONS

SCALE: 1/8" = 1'-0"

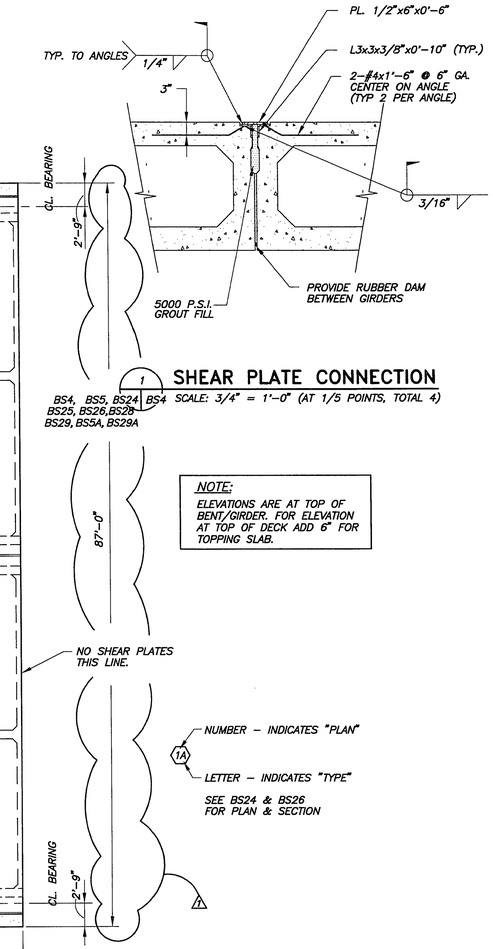

SHEAR PLATE CONNECTION

1 BS4 BS4 — BS4, BS5, BS24, BS25, BS26, BS28, BS29, BS5A, BS29A

SCALE: 3/4" = 1'-0" (AT 1/5 POINTS, TOTAL 4)

NOTE:
ELEVATIONS ARE AT TOP OF BENT/GIRDER. FOR ELEVATION AT TOP OF DECK ADD 6" FOR TOPPING SLAB.

RECORD DRAWINGS

CLV DRAWING No. 107-V2011

MARK	DATE	BY	REVISION
1	10/16/92	RBP	REVISION PER ADDENDUM NO. 1

DESIGNED: RBP
DRAWN: MWM
CHECKED: AHG/DJS

PROJECT ENGINEER — DATE
PROJECT MANAGER — DATE

Boyle Engineering Corporation
consulting engineers
Suite 300
1785 E. Sahara Ave
Las Vegas, NV 89104
(702) 731-3511

CITY OF LAS VEGAS
DEPARTMENT OF PUBLIC WORKS

OGDEN AVENUE UNDERPASS AND ROADWAY

GIRDER/FRAME LAYOUT & DECK ELEV.
AREA 1 & 2

DRAWING BS4
38 OF 125
BS-4

FILE SPECIFICATION D:\OGDEN\BS-04
PLOT SCALE 1=96
OPERATOR AL10/PLATT
PLOT DATE 09/14/92 10:52

C:\KENT\OGDEN\STRUC\BS-04 Wed Nov 2 15:41:01 1994

3-23