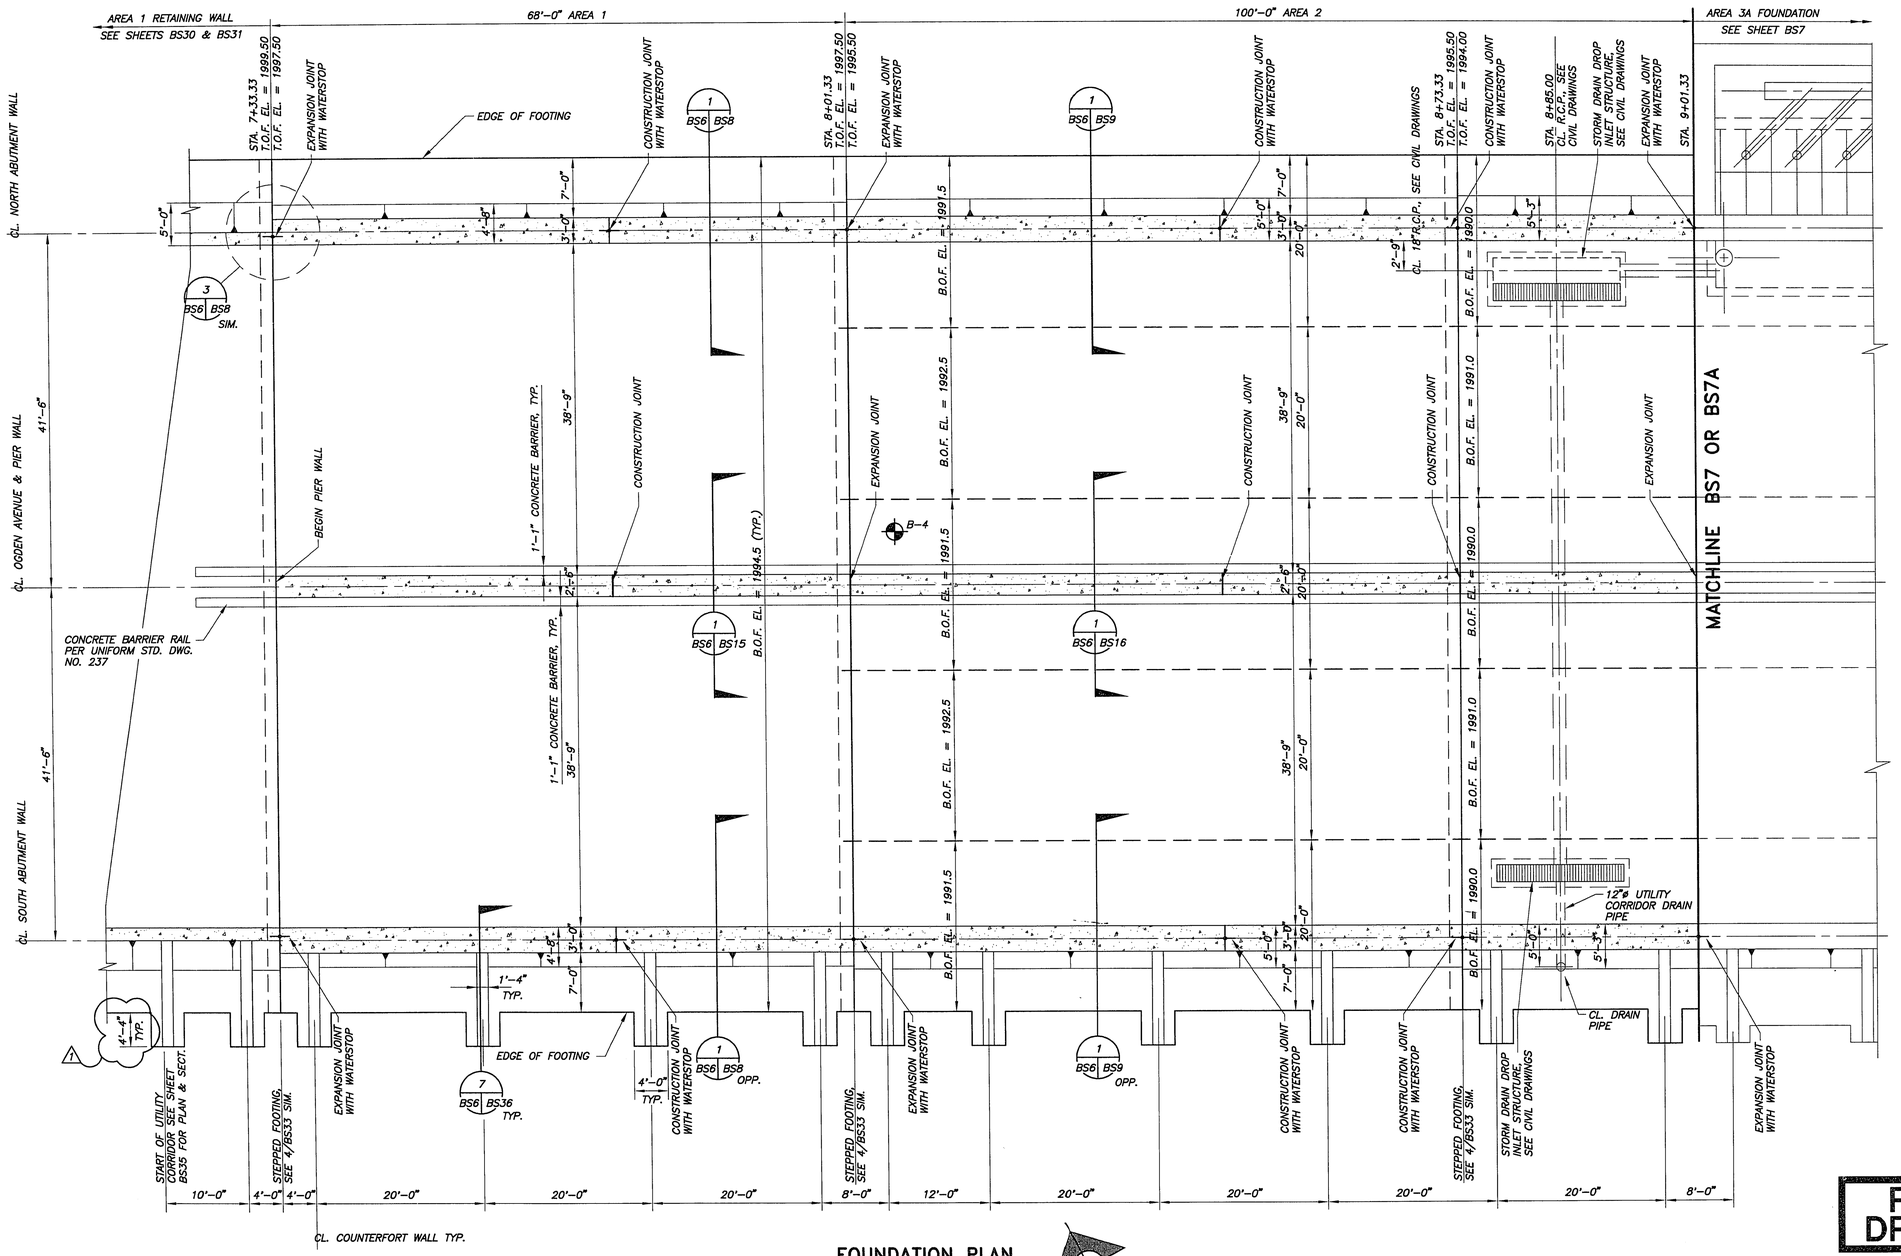

FOUNDATION PLAN

SCALE: 1/8" = 1'-0"

RECORD DRAWINGS

CLV DRAWING No. 107-V2011

REISSUED 10-16-92 WITHOUT REVISION

MARK	DATE	BY	REVISION
1	10/1/94	BE	RECORD DRAWINGS

DESIGNED: RBP
DRAWN: MWM
CHECKED: AHG/DJS

PROJECT ENGINEER — DATE
PROJECT MANAGER — DATE

Boyle Engineering Corporation
consulting engineers
Suite 300
1785 E. Sahara Ave
Las Vegas, NV 89104
(702) 731-5511

CITY OF LAS VEGAS
DEPARTMENT OF PUBLIC WORKS

OGDEN AVENUE UNDERPASS AND ROADWAY

FOUNDATION PLAN
AREA 1 & 2

DRAWING
BS6
40 OF 125
BS-6

FILE SPECIFICATION
D:\OGDEN\BS-06

PLOT SCALE 1=96
OPERATOR AL10/FLATT
PLOT DATE 09/14/92 11:16

C:\KENT\OGDEN\STRUCT\BS-06 Wed Nov 2 16:39:38 1994

32-46