



PAVEMENT SUPERELEVATION TRANSITION LOCATIONS

Avoid cutting underground utility lines. It's costly.
Call before you Dig.
 1-800-227-2600
 UNDERGROUND SERVICE ALERT USA

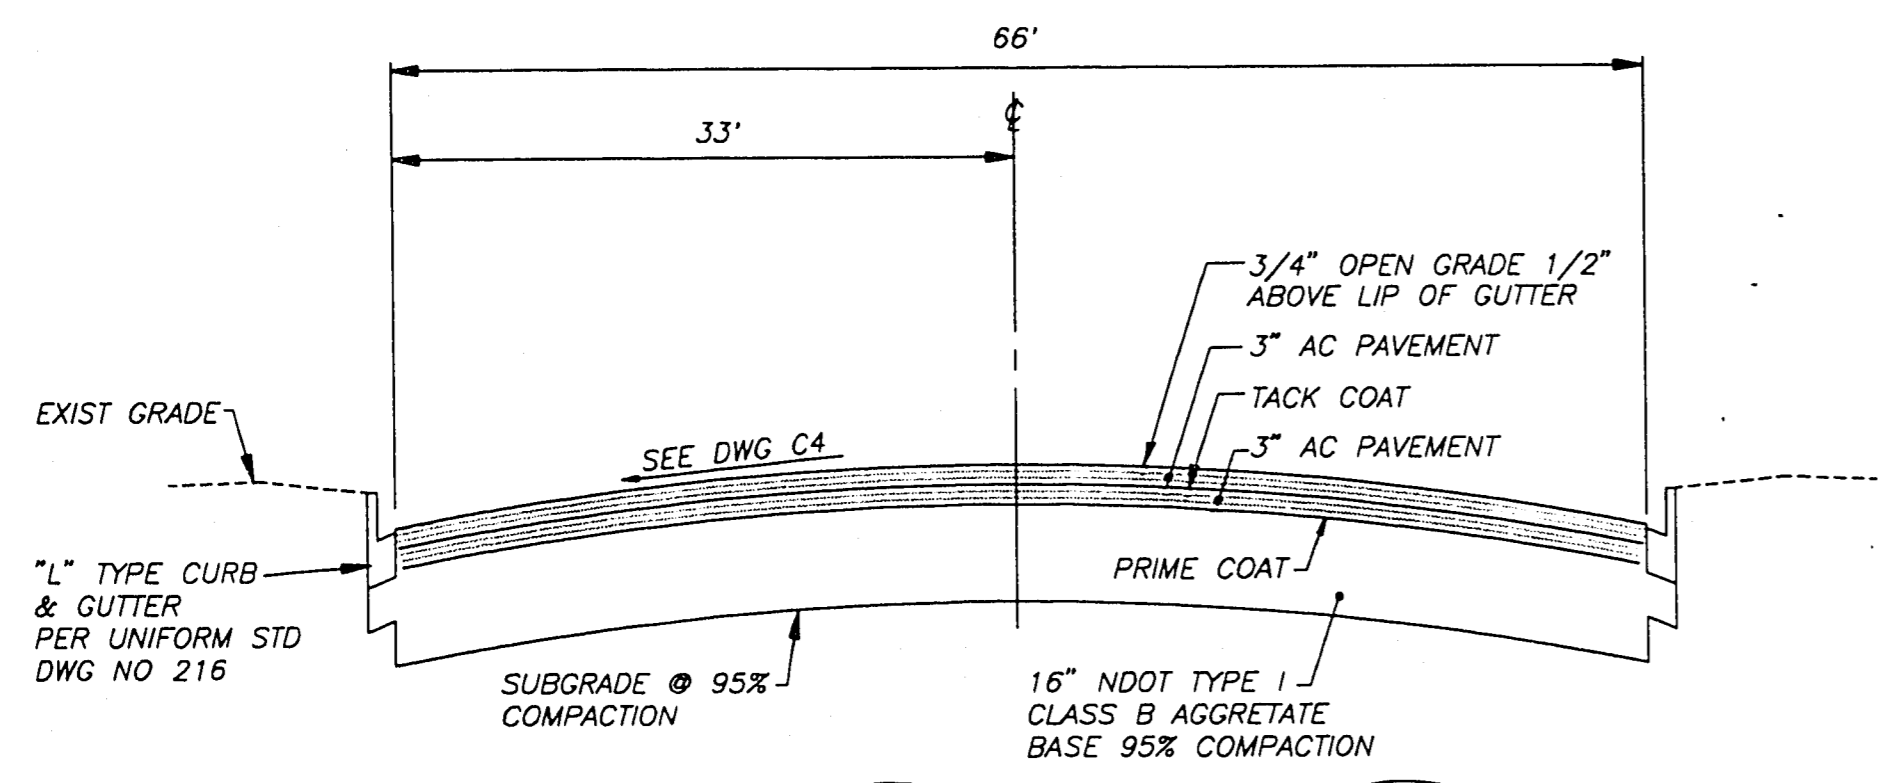


OGDEN AVE TYPICAL ROADWAY SECTION
 STA 1+68.17 TO 2+48.74
 NOT TO SCALE

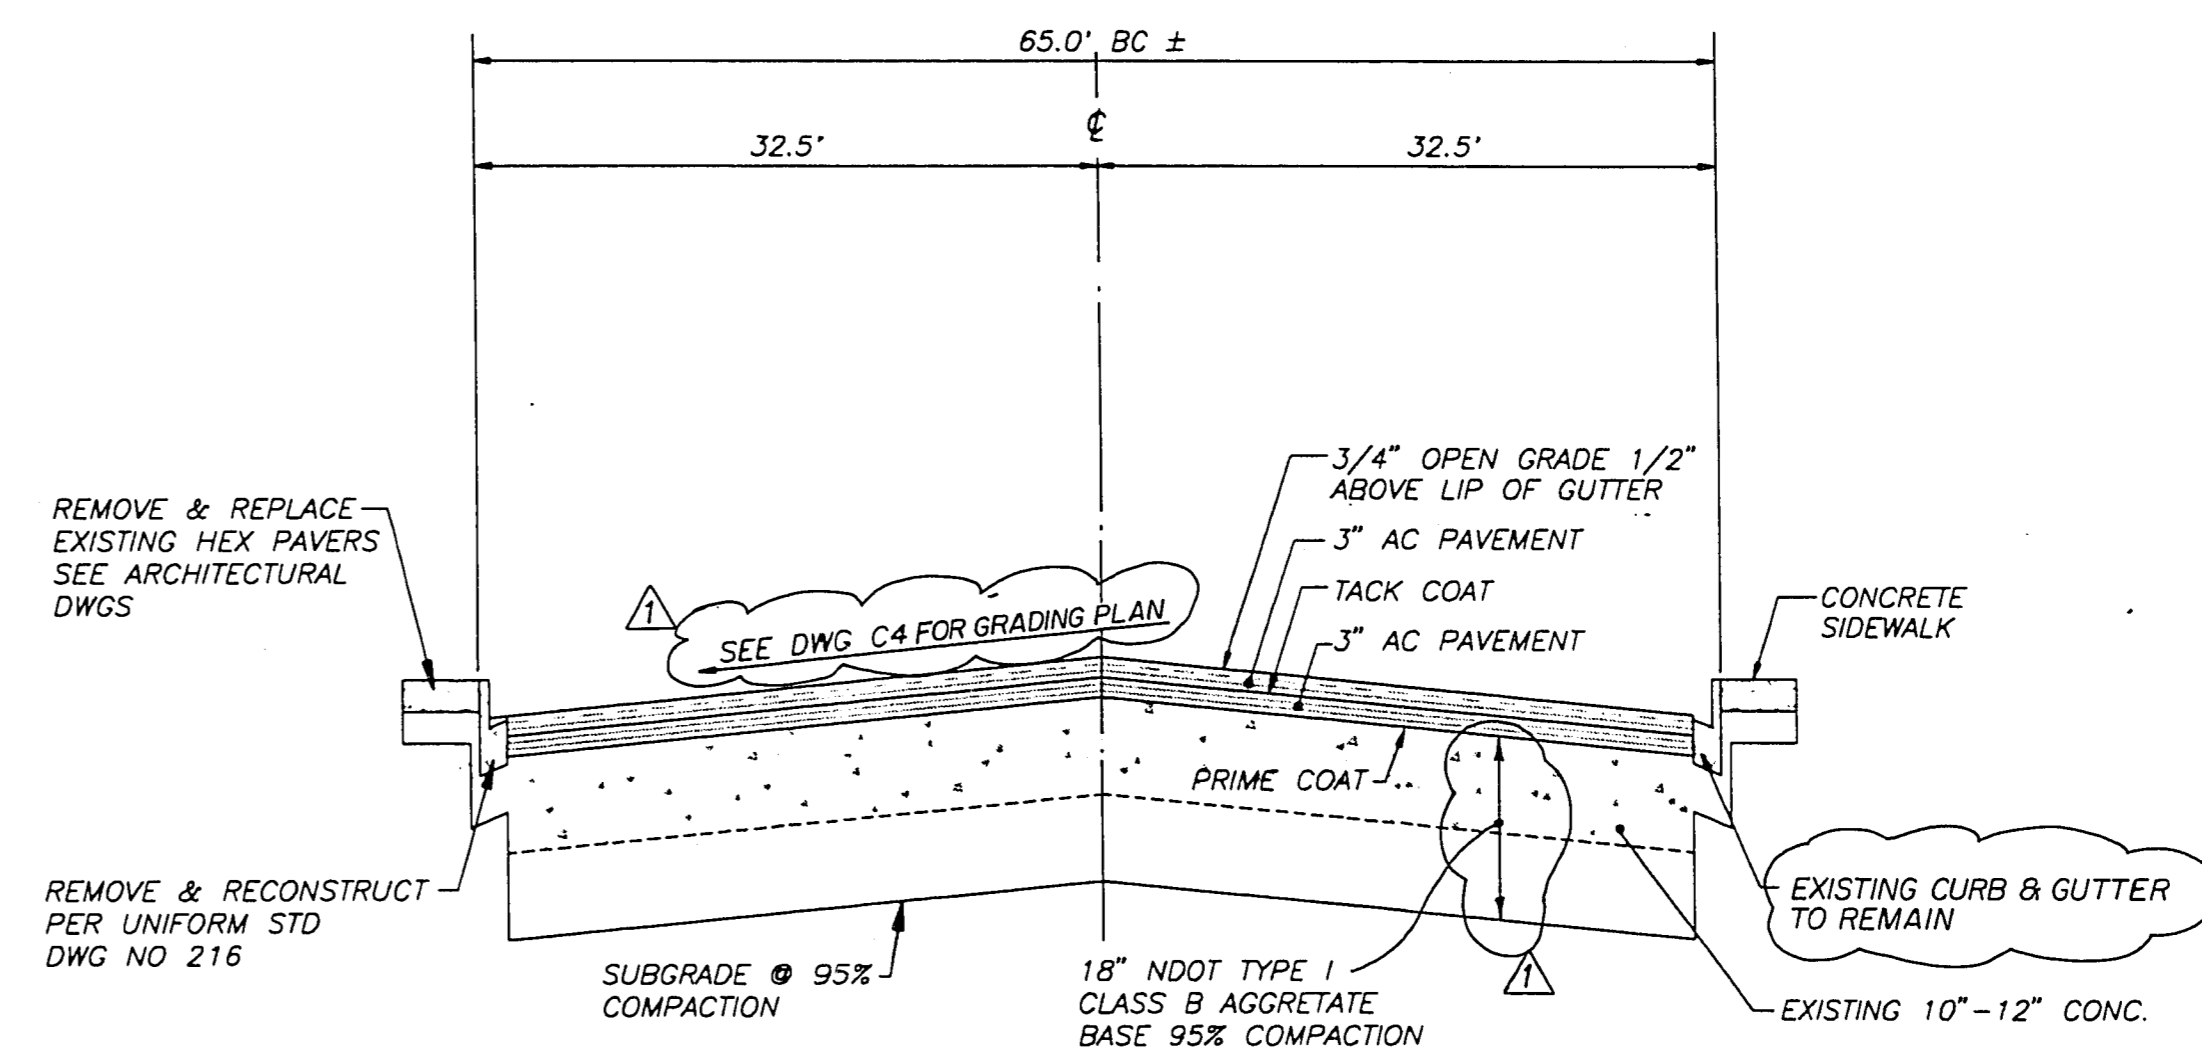


MAIN ST TYPICAL ROADWAY SECTION
 LOOKING NORTH
 NOT TO SCALE


NOTE:
 THESE TYPICAL ROADWAY SECTIONS ILLUSTRATE THE STRUCTURAL ROADWAY SECTIONS ONLY. THE CONTRACTOR SHALL USE DRAWING PROFILES AND SUPERELEVATION RATES AS INDICATED ON DRAWINGS TO CONSTRUCT ROADWAY CROSS SLOPES.

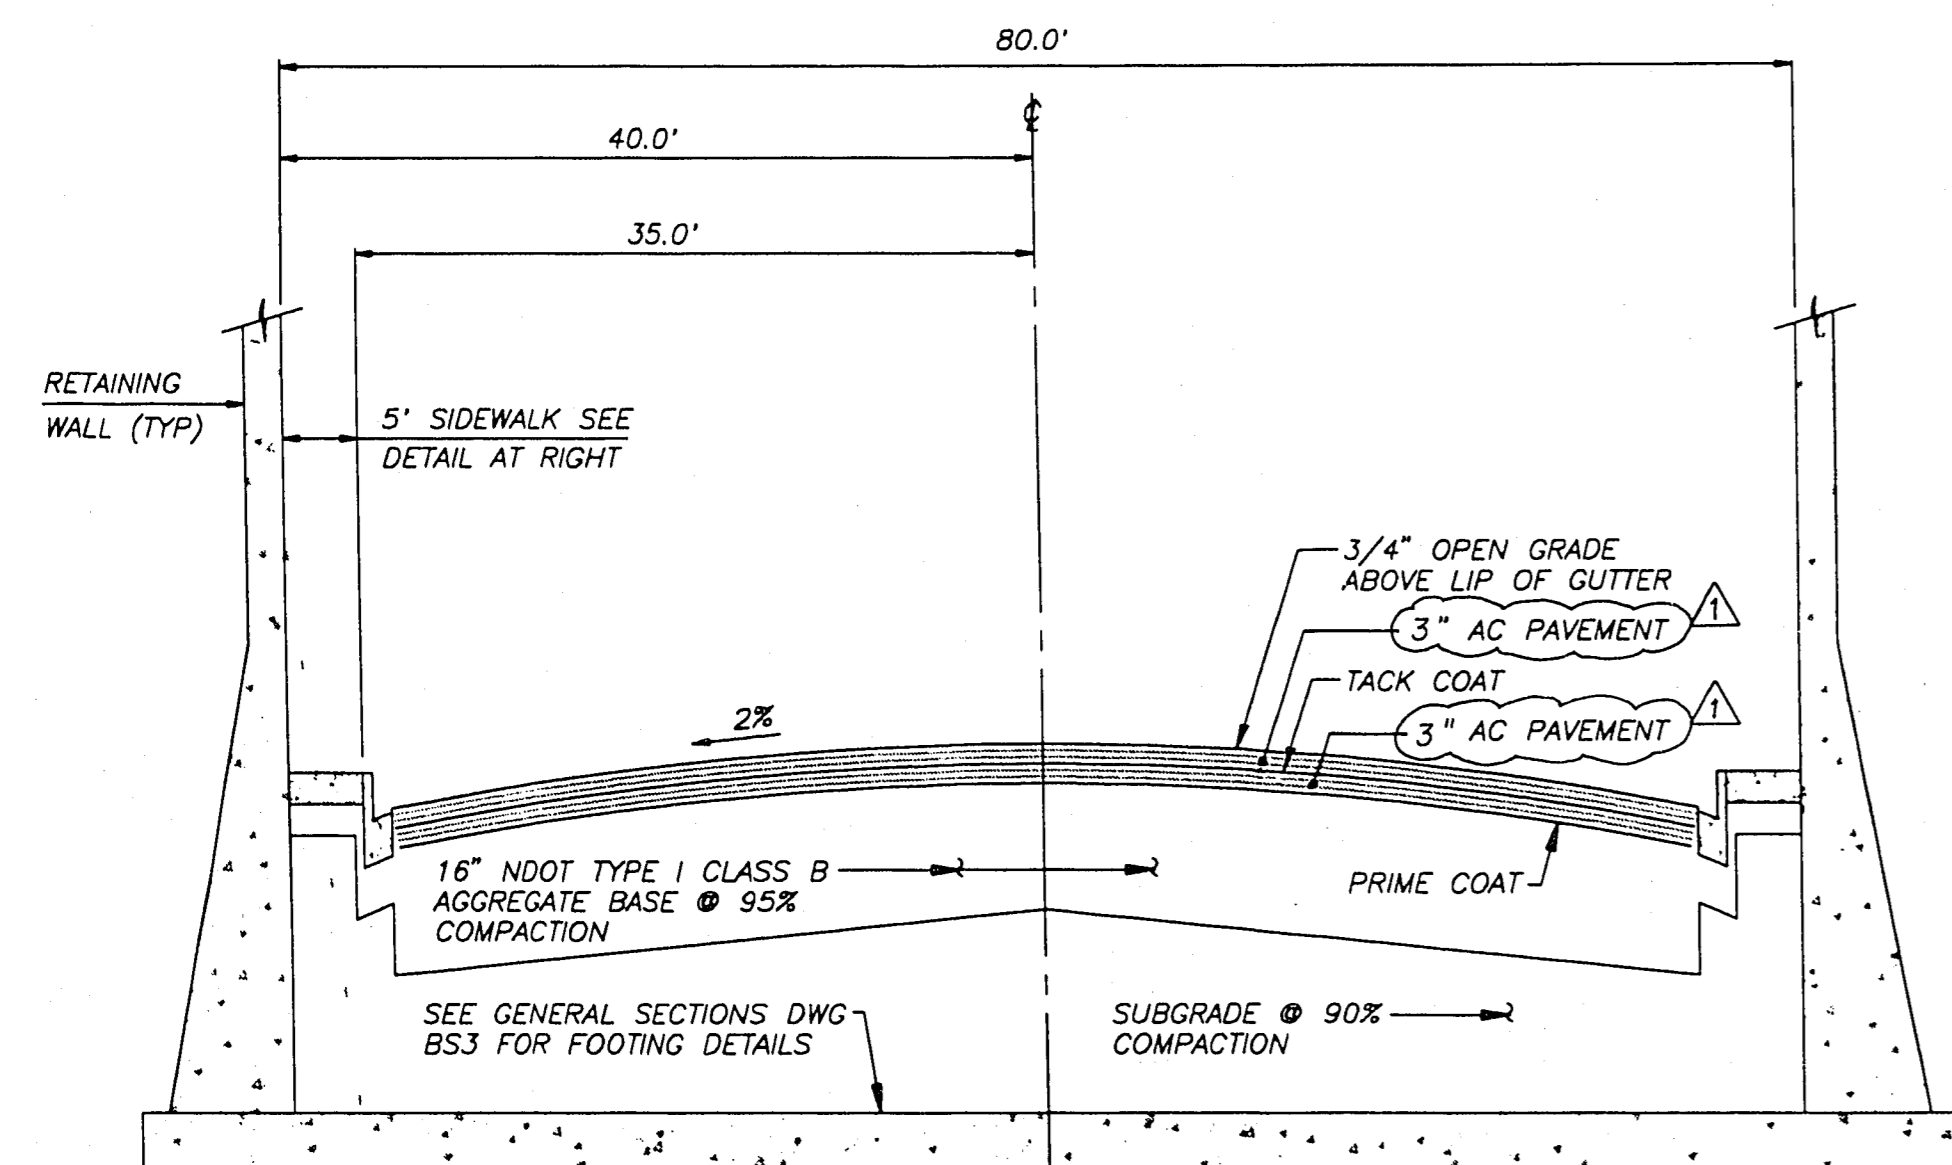


OGDEN AVE TYPICAL ROADWAY SECTION
 STA 2+48.74 TO 7+33.33 AND
 STA 10+45.33 TO 12+70.00
 (11+29.33 TO 12+70.00 ADDITIVE ALTERNATE)
 NOT TO SCALE

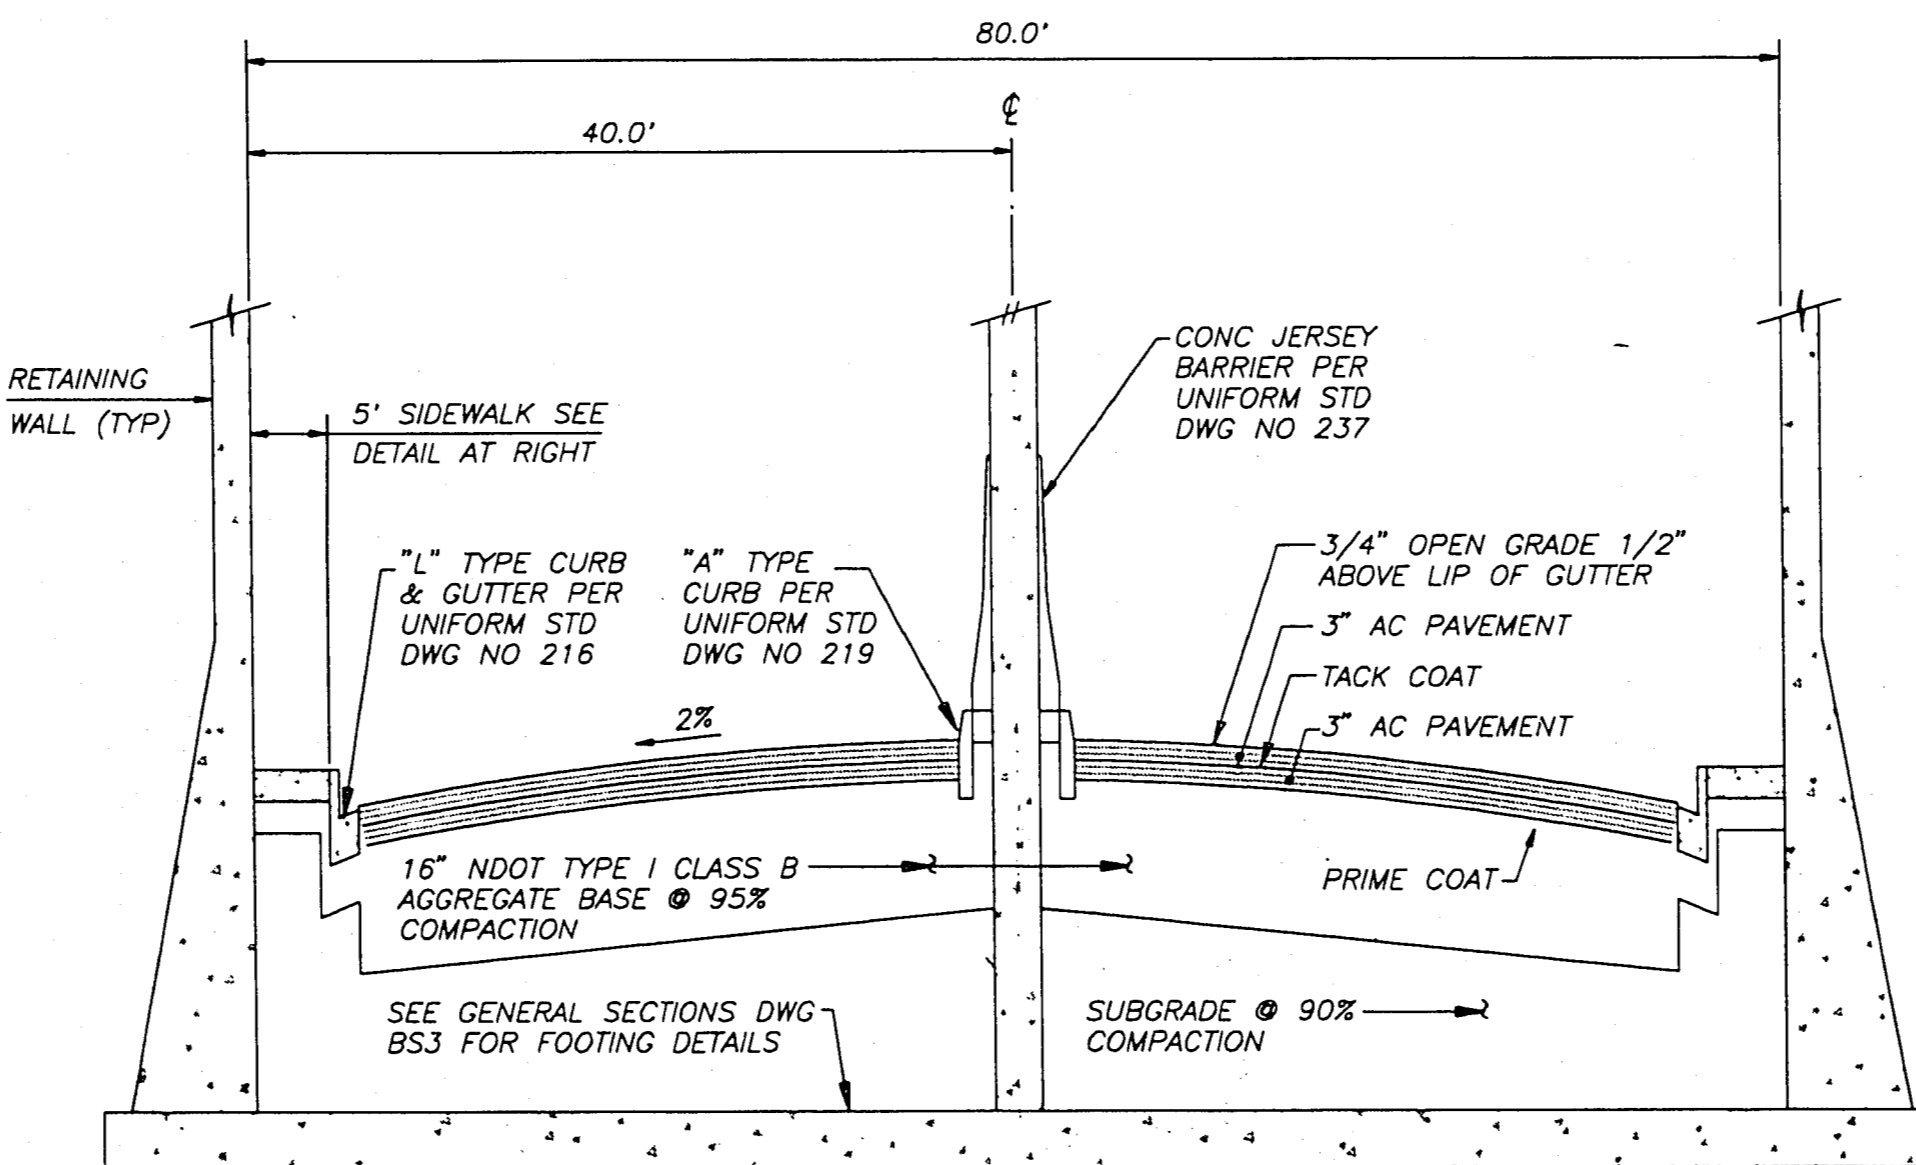

OGDEN AVE TYPICAL ROADWAY SECTION IN UNDERPASS
 STA 7+33.33 TO 10+45.33
 (7+33.33 TO 11+29.33 ADDITIVE ALTERNATE)
 NOT TO SCALE

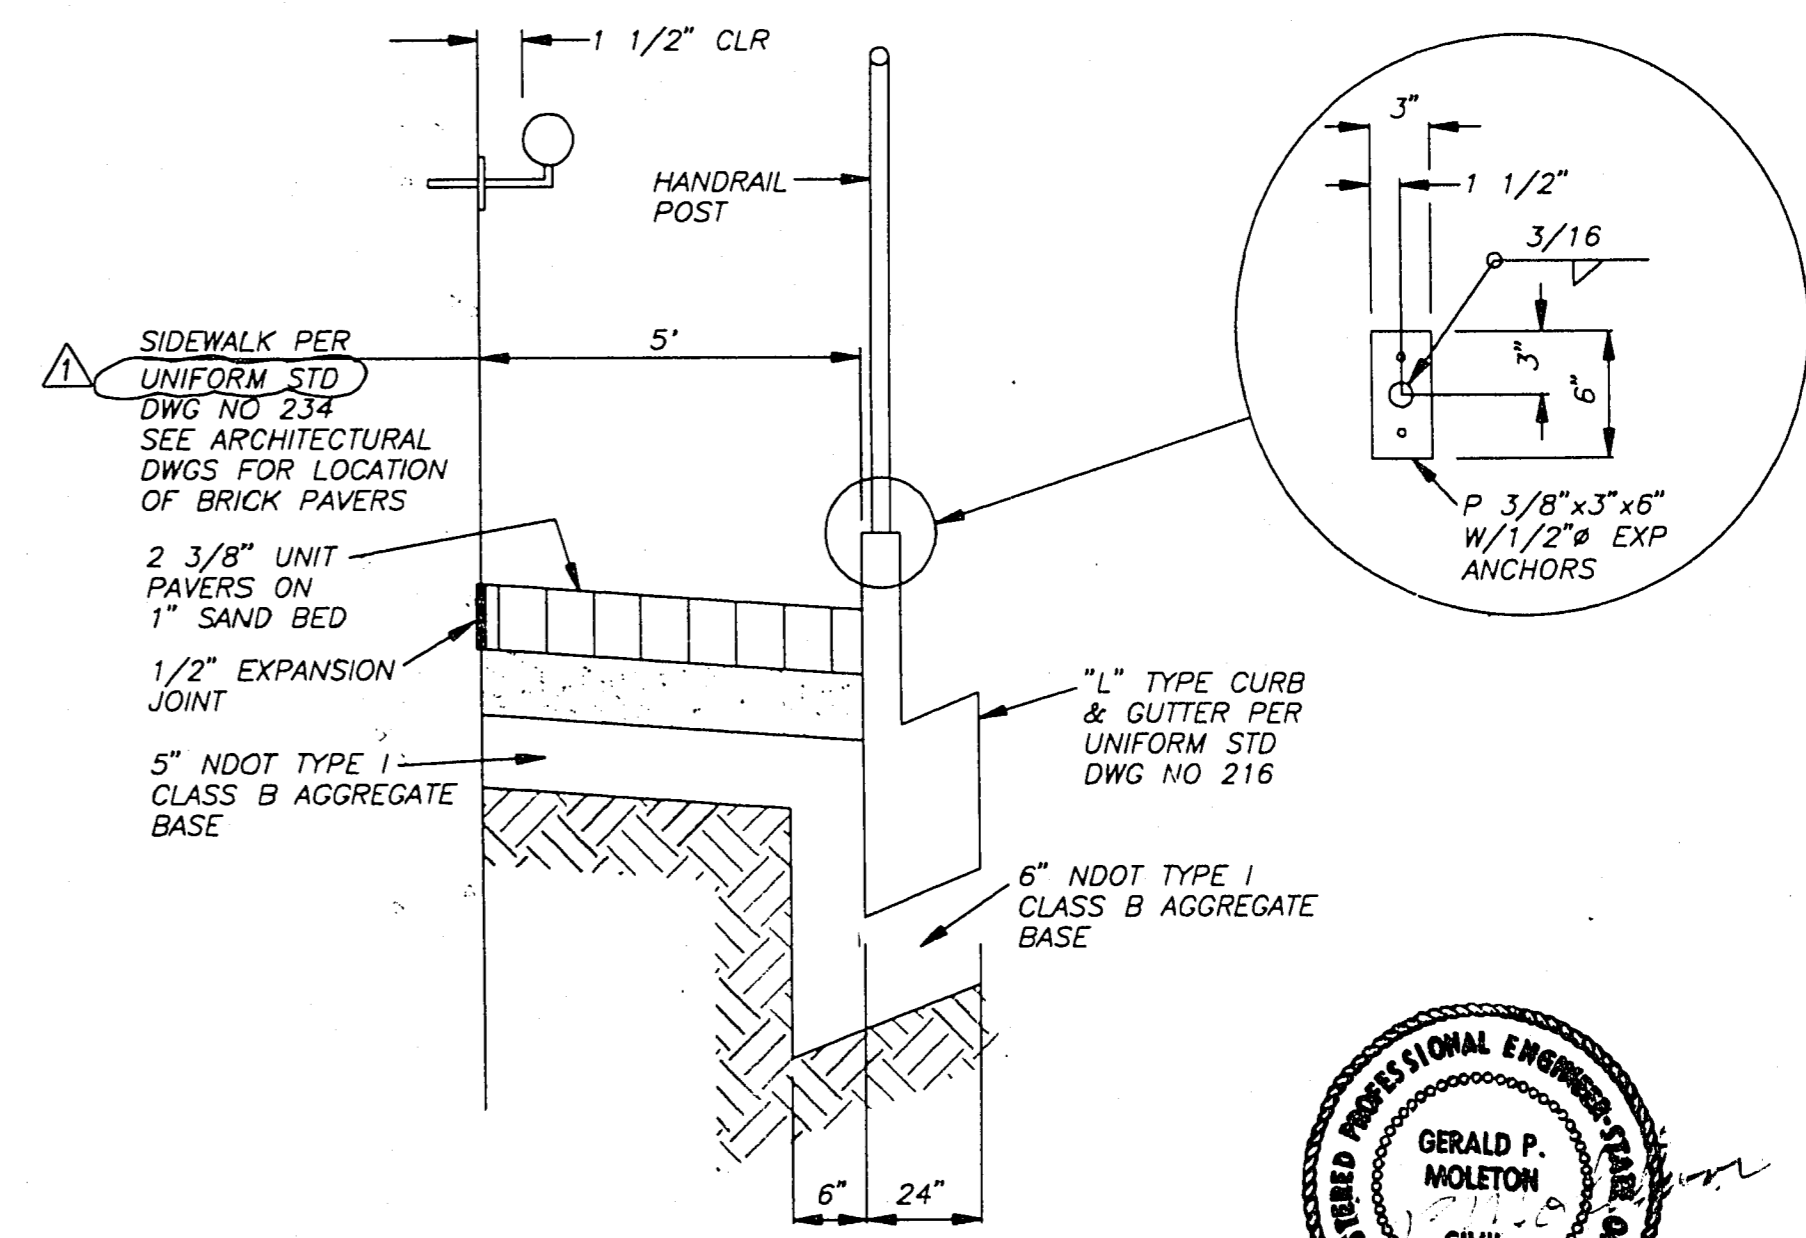


OGDEN AVE TYPICAL SIDEWALK SECTION
 NOT TO SCALE

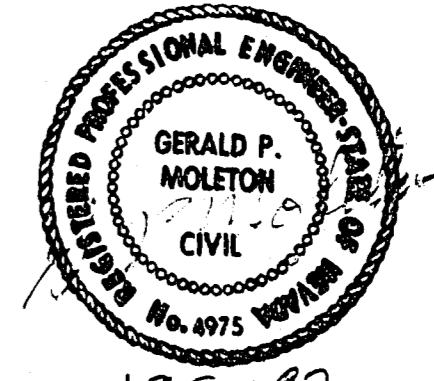

DESIGNED:	MSL
DRAWN:	JAM
CHECKED:	GPM
DATE:	10/15/92
BY:	GM
REVISION:	PER ADDENDUM NO. 1

DESIGNED: MSL
 DRAWN: JAM
 CHECKED: GPM
 DATE: 9-18-92
 PROJECT MANAGER: G.P. Moleton
 18 Sep 92

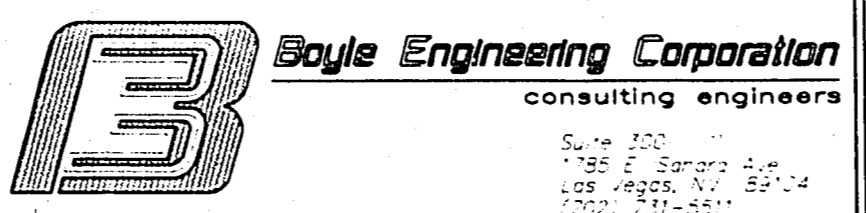

CITY OF LAS VEGAS
 DEPARTMENT OF PUBLIC WORKS

OGDEN AVENUE UNDERPASS AND ROADWAY
 TYPICAL ROADWAY SECTIONS
 AND KEY NOTES

DRAWING
3
 3 OF 125
 OGSHT003

2-2-3