

agency

approved date

Deputy City Manager
Director of Design & Development

City Engineer
Chief of Civil Engineering
Chief of Traffic Engineering
City Project Administrator
Chief of Project Control
Chief of Construction Services
Director of General Services
Chief of Maintenance

Director of Parks, Recreation & Senior Activities

Director of Public Services
Chief of Electrical Services

Director of Community Planning & Development

Director of Building & Safety

Regional Transportation Commission

Nevada State Department of Transportation

Central Telephone Company

Las Vegas Valley Water District

Nevada Power Company

Southwest Gas

Cable Television


City of Las Vegas

BOND ISSUE

index of sheets

- G1 COVER SHEET
- G2 ABBREVIATIONS & LEGENDS
- G3 SITE PLAN/LOCATION PLAN
- G4 SIDEWALK/COVERED PARKING PLAN & SECTIONS
- G5 COVERED PARKING ELEVATIONS & DETAILS
- G6 BORROW SITE PLAN/SEWAGE PIPING DETAILS
- G7 EARTHWORK SECTIONS & MISC. DETAILS
- A0 ARCHITECTURAL & STRUCTURAL GENERAL NOTES & ABBREVIATIONS
- A1 FLOOR PLAN
- A2 EXTERIOR ELEVATIONS
- A3 BUILDING SECTIONS
- A4 SCHEDULES & INTERIOR ELEVATIONS
- A5 ROOF & CEILING PLANS
- A6 WALL SECTIONS
- A7 DETAILS
- S1 FOUNDATION PLAN
- S2 ROOF FRAMING PLAN
- S3 FOUNDATION DETAILS
- S4 FRAMING DETAILS
- M1 HVAC PLAN & SECTIONS
- M2 HVAC SCHEMATIC & SCHEDULE
- M3 PLUMBING & DRAINAGE PLAN & SCHEMATIC
- E1 ELECTRICAL SYMBOLS & ABBREVIATIONS
- E2 ELECTRICAL POWER & LIGHTING PLAN
- E3 ELECTRICAL DETAILS
- E4 INTERCOMMUNICATION SYSTEM SITE PLAN
- E5 INTERCOMMUNICATION SYSTEM BLOCK DIAGRAM
- CPM-1 CRITICAL PATH METHOD-1
- CPM-2 CRITICAL PATH METHOD-2
- CPM-3 CRITICAL PATH METHOD-3

location map

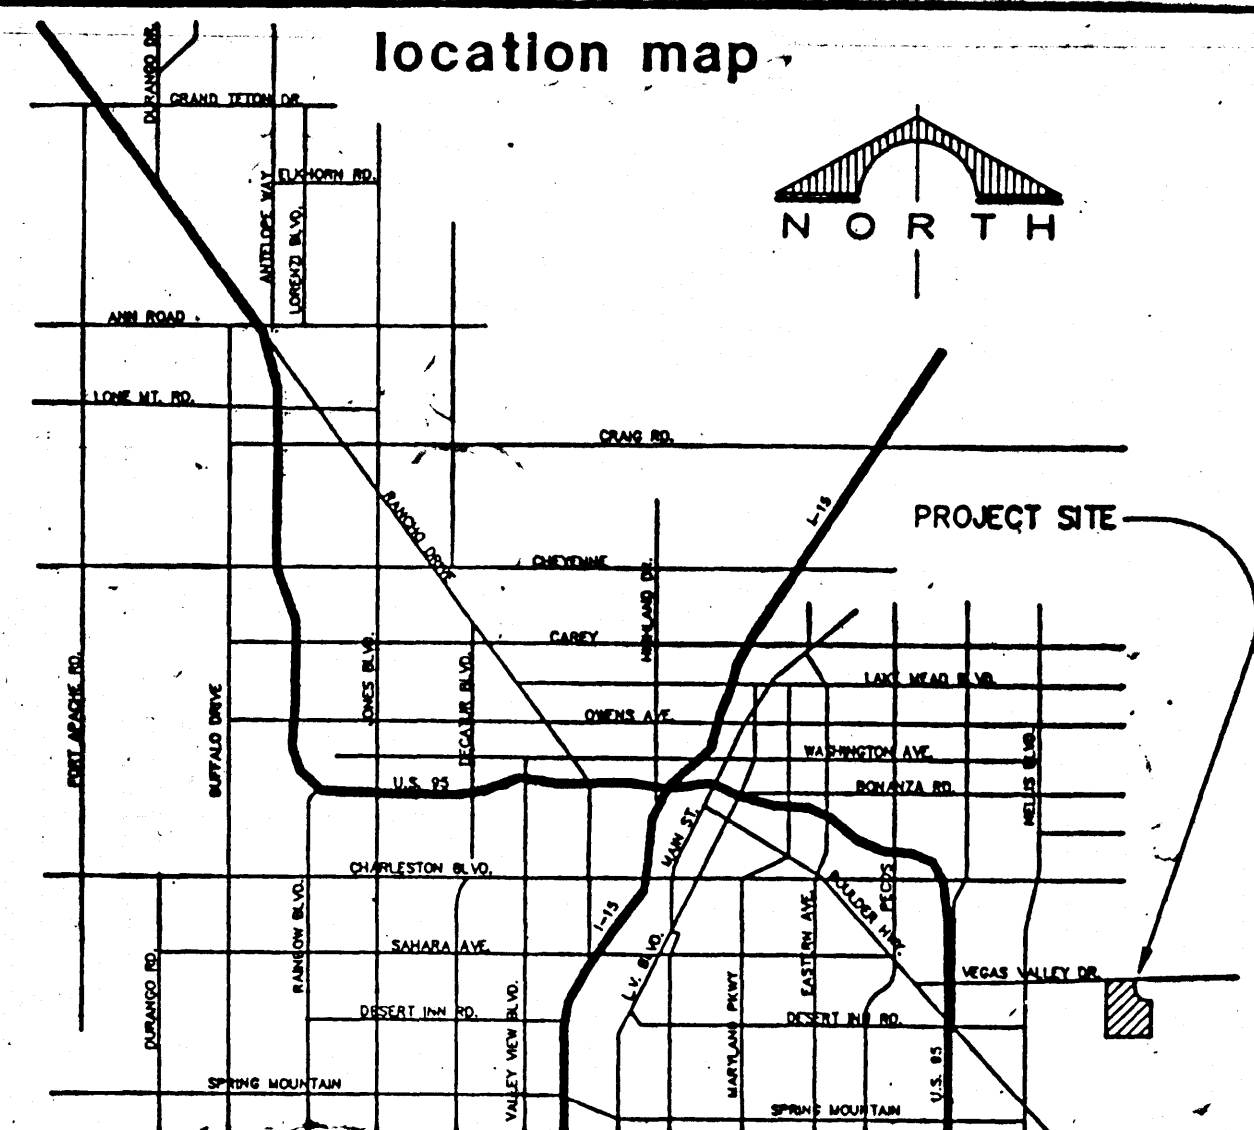

mayor:

Ron Lurie

councilmen:

Arnie Adamsen

W. Wayne Banker

Steve Miller

Bob Nolen


city manager:

Ashley

director of
public works:

Richard D. Goecke

CORRECTED ACCORDING TO CONSTRUCTION RECORDS MIB 4/1/91
INCORP'S F.O.*1 THRU 15 & C.O.*1 &*2

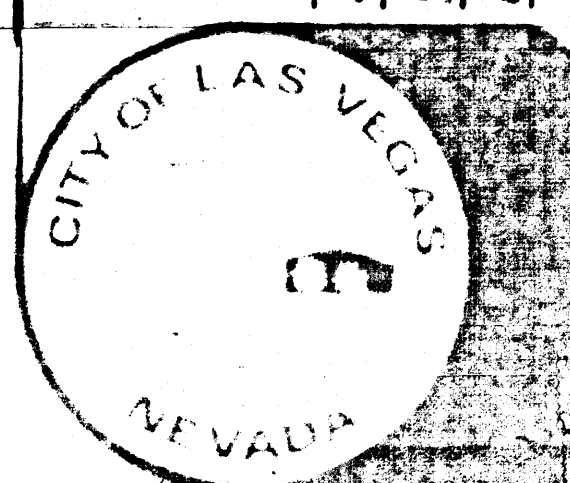

OPERATIONS BUILDING

CONTRACT X

BID NO.90.7254.10

G1

3/1/29