




Issue No.					
39122	RECORD DRAWING	7-31-01	TUY	BJ	BJ
	Description	Date	Drawn	Chkd.	Resp. Engr.

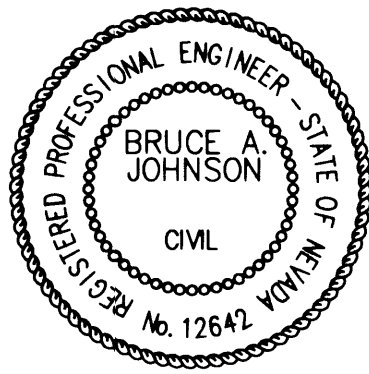

CH2MHILL
2000 E. FLAMINGO ROAD,
SUITE A
LAS VEGAS, NV 89119
702.369.6175

HDR
HDR Engineering, Inc.
5280 S. EASTERN AVE., D1
LAS VEGAS, NV 89119
702.256.4895

Project Manager	B JOHNSON
Designed	L STEEPS
Designed	J PARKER BJ
Checked	B JOHNSON
Drawn	C WORRALL

City of Las Vegas
**Water Pollution Control Facility
Plant Expansion**
Contract 20 - Odor Control

CIVIL
AREA G119
SITE PLAN

Date	Project No.	Scale	Drawing No.	Sheet No.
SEPTEMBER 1998	00120-154-141	1"=30'	G119	311.48 17 of 76