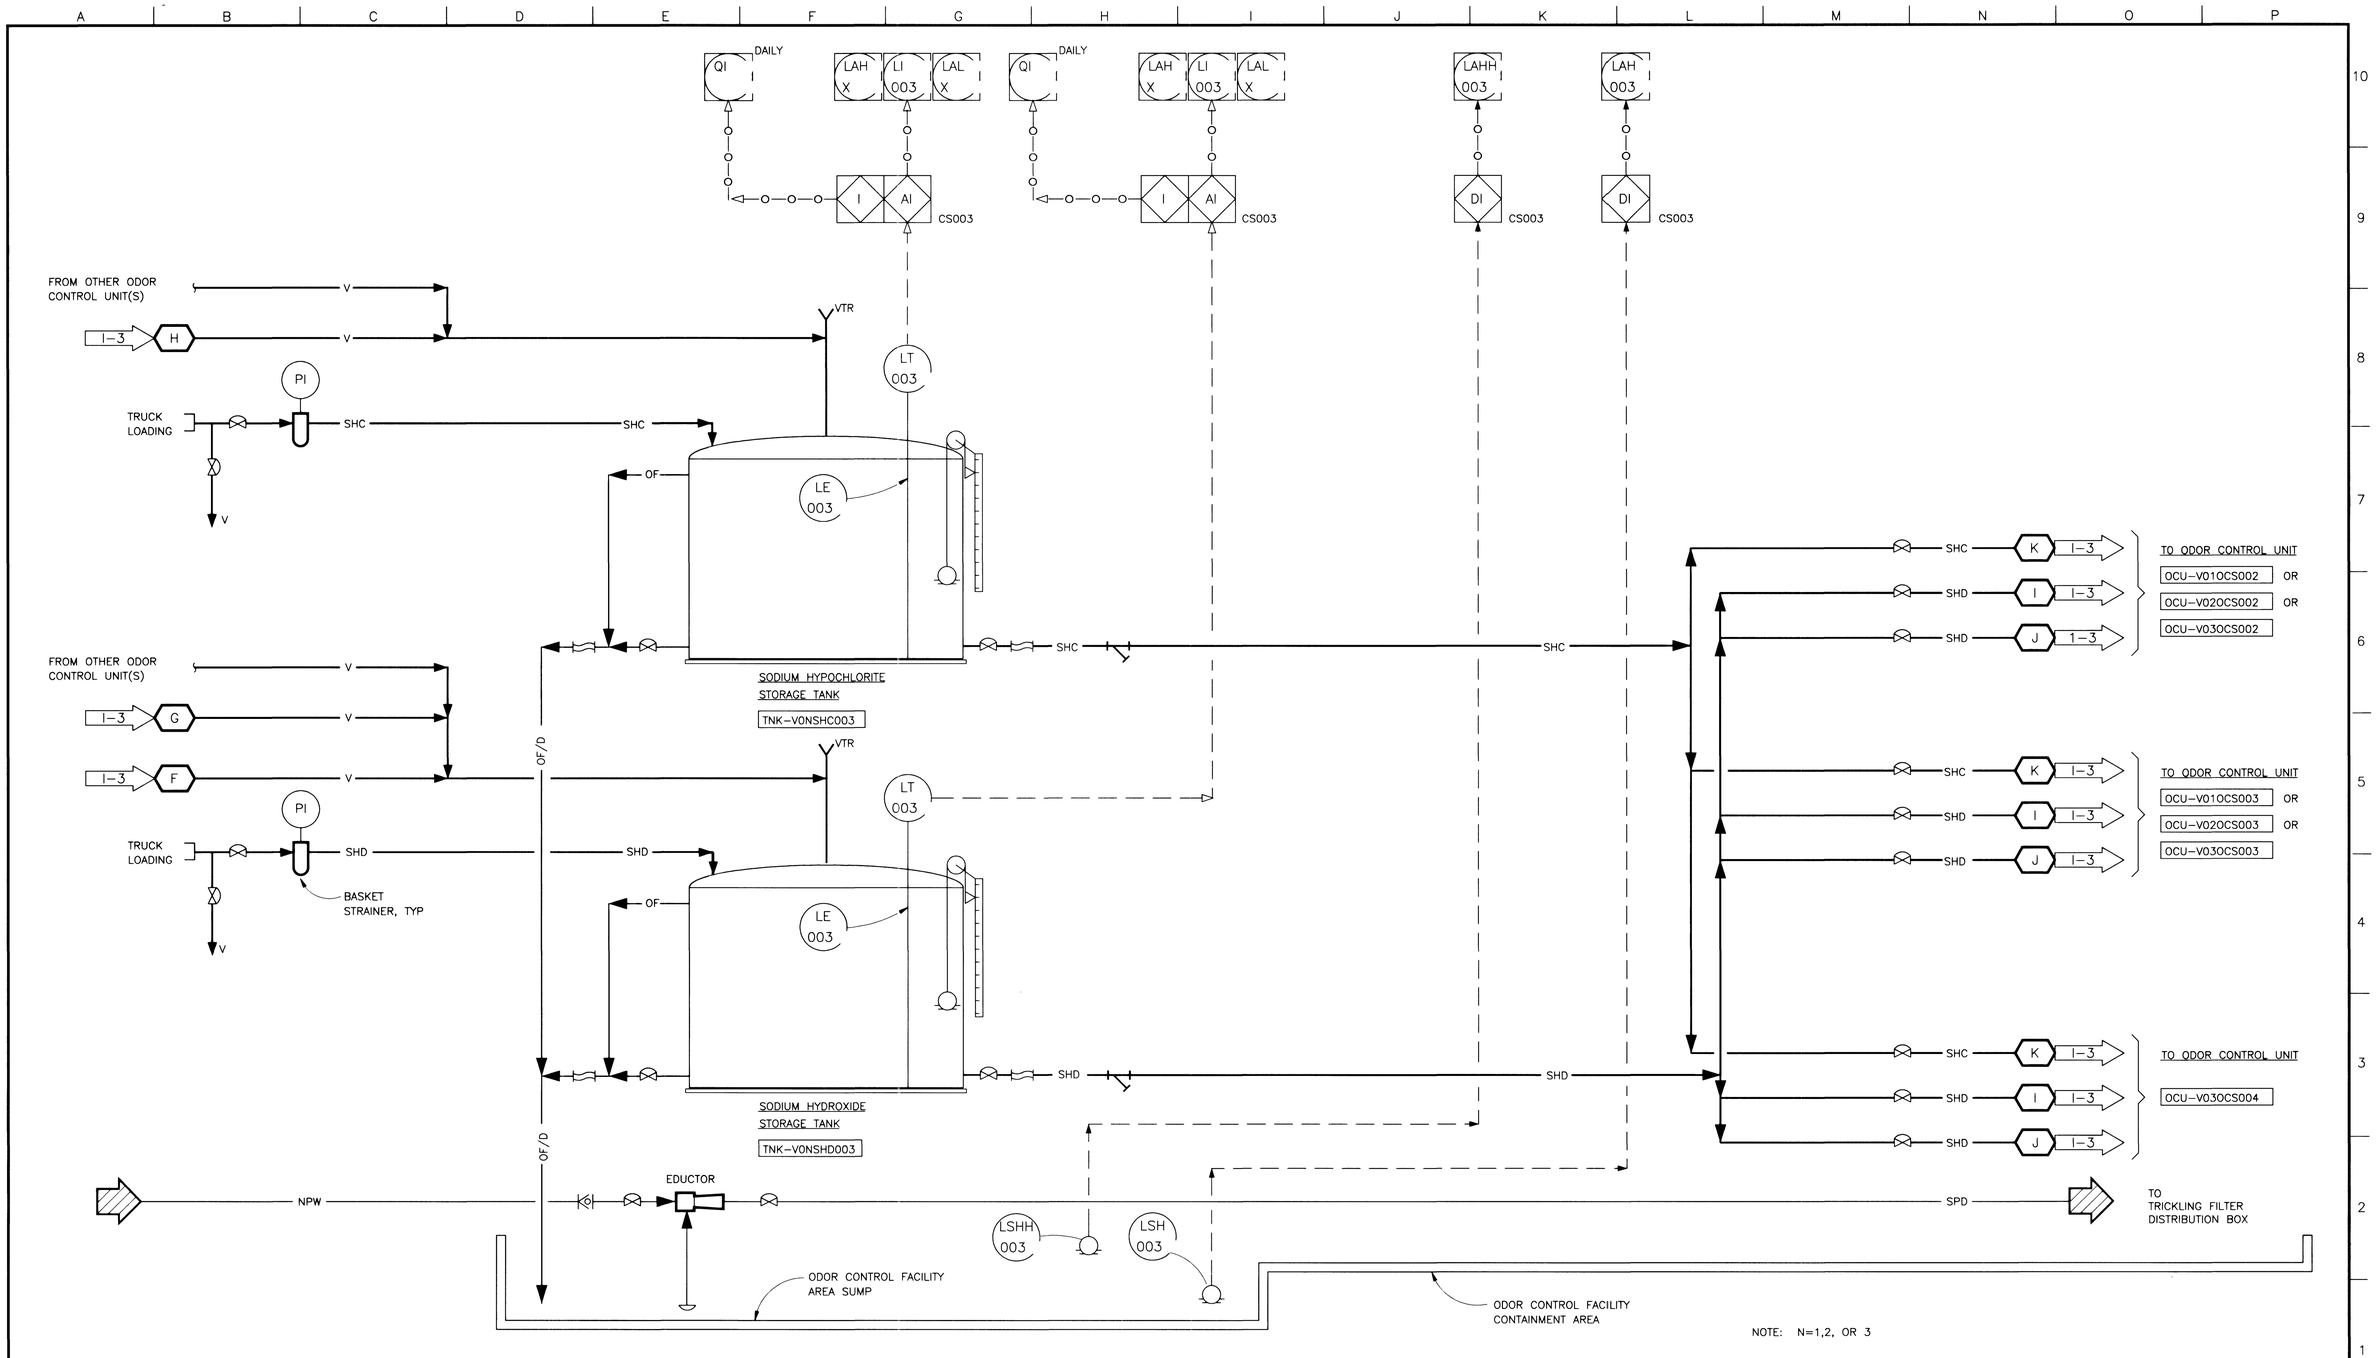

NOTE: N=1,2, OR 3

Issue No.	Description	Date	Drwn.	Chkd.	Resp. Engr.	Proj. Mgr.
	RECORD DRAWING	2-22-02	VND	MK		BJ
	RECORD DRAWING	7-31-01	TUY	BJ		BJ
	39157					

REGISTERED PROFESSIONAL ENGINEER - STATE OF NEVADA
WAYNE F. PEARSON
CIVIL
No. 9152

CH2MHILL
2000 E. FLAMINGO ROAD, SUITE A
LAS VEGAS, NV 89119
702.369.6175

HDR Engineering, Inc.
5280 S. EASTERN AVE., D1
LAS VEGAS, NV 89119
702.256.4895

BAR LENGTH ON ORIGINAL DRAWING EQUALS ONE INCH. ADJUST SCALE ACCORDINGLY.

Project Manager: B JOHNSON
Designed: W PEARSON
Designed: BJ
Checked: E VOLLRATH
Drawn: J PEPPEL

City of Las Vegas
Water Pollution Control Facility Plant Expansion
Contract 20 – Odor Control

PROCESS INSTRUMENTATION AND CONTROLS
TYPICAL CHEMICAL STORAGE AND DISTRIBUTION

311.48

Date	Project No.	Scale	Drawing No.	Sheet No.
SEPTEMBER 1998	00120-154-141	NOT TO SCALE	I-4	52 of 76

C20-I004.DWG 02-25-02

C:\Projects\C20-I004.dwg Mon Mar 04 15:18:03 2002