


R:\00120\Contract 19 - Demolition and Flood Control\p-h\c19-c112.dwg
01-29-02 JDOHNSO 14:33:43

39272

Issue No.	Description
1	"AS RECORDED"

Date	Drawn	Chkd.	Resp. Engr.	Proj. Mgr.
01/01	D.G.R.			

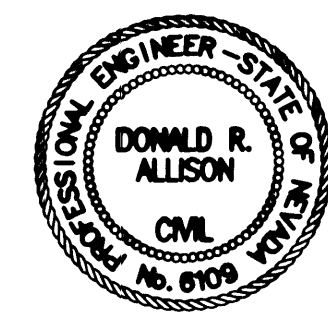

Berryman Henegar
4840 W. University Ave., Suite A-1
Las Vegas, NV 89103
(702) 252-7866
(702) 252-7890 fax

HDR
HDR Engineering, Inc.
770 E. Warm Springs Road
Suite 360
Las Vegas, NV 89119
702-938-6000
ONE LINEN ON ORIGIN.
DRAWING EQUALS ONE INCH.
ADJUST SCALE ACCORDINGLY.

Project Manager	DANIEL GRABER
Designed	D. ROSENKOETTER
Designed	
Checked	D. ALLISON
Drawn	D. ROSENKOETTER

City of Las Vegas
**Water Pollution Control Facility
Plant Expansion**
Contract 19 - Demolition/Flood Control

CROSS SECTIONS NEW BERM				
Date	Project No.	Scale	Drawing No.	Sheet No.
DECEMBER 1999	00120-154-141	1"=20'	C112	24 of 45

- NOTE:**
1. REFERENCE SHEET C102 FOR DETAIL OF TYPICAL BERM SECTION
2. ALL SECTIONS CUT LOOKING UP-STATION.

