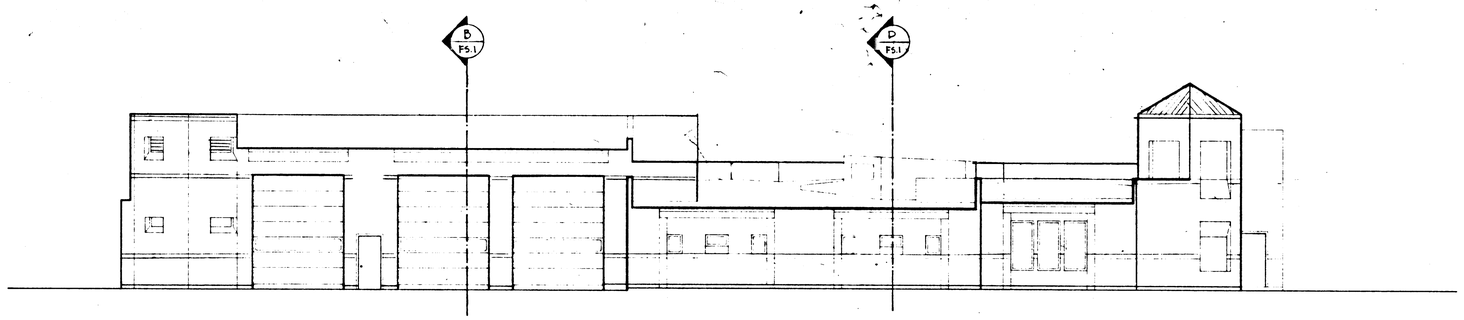

C REAR ELEVATION (SOUTH)

SCALE: 1/8" = 1'-0"

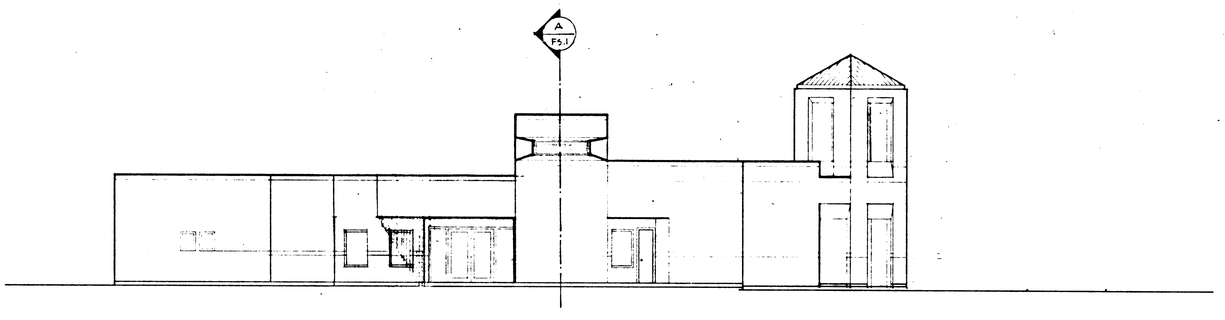

B LEFT SIDE ELEVATION (EAST)

SCALE: 1/8" = 1'-0"

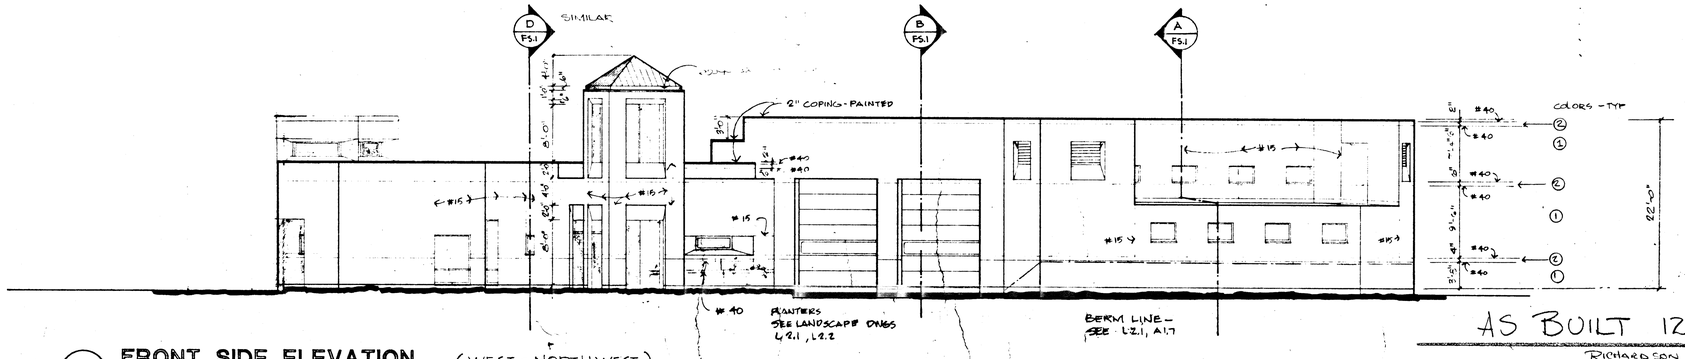

A FRONT SIDE ELEVATION (WEST - NORTHWEST)

SCALE: 1/8" = 1'-0"

① CM 8432
② CM 8501
③ 2M48E
④

SINCLAIR

AS BUILT 12-15-89

RICHARDSON CONST. INC.

2 BAY STATION EXTERIOR ELEVATIONS

REV. | DATE | DR.

RECOMMENDED

R.A. NO. | DATE

JOB 412.515
DATE 11-17-89
DRAWN
CHECK'D BCD

G.C. WALL Engineering, Inc.
Architecture - 4555 South Rainbow Blvd., Las Vegas, Nevada 89103

LAS VEGAS FIRE DEPARTMENT
CITY OF LAS VEGAS, NEVADA
EXTERIOR ELEVATIONS

SHEET 40
A2.7
OF 112 SHEETS

3977

630 - 81