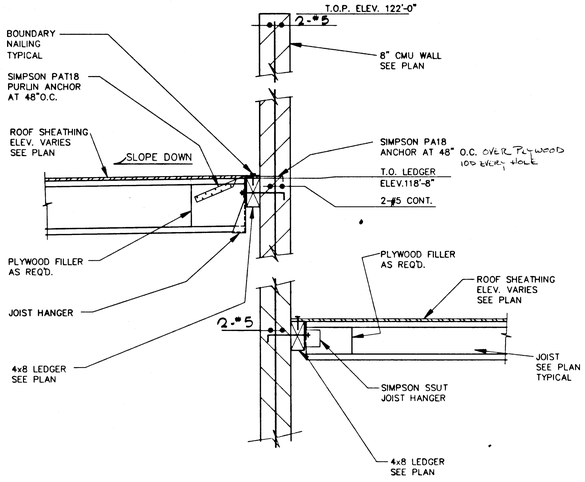

3/4"=1'-0"

SECTION

1 / S-1.4

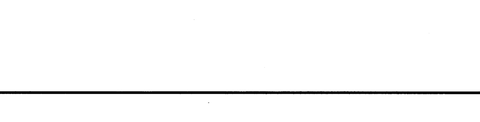

NOTE: FOR STIFF PLATES, GROUT, REINF. WELDING ETC. SEE DETAIL 11/S13

3/4"=1'-0"

PLAN SECTION

5 / S-1.4

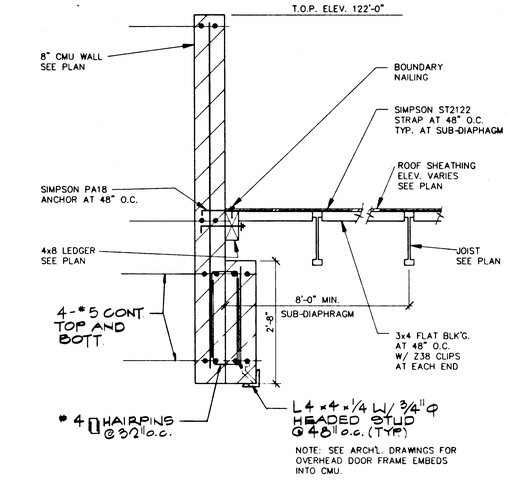

NOTE: SEE ARCH'L. DRAWINGS FOR OVERHEAD DOOR FRAME EMBEDS INTO CMU.

3/4"=1'-0"

SECTION

2 / S-1.4

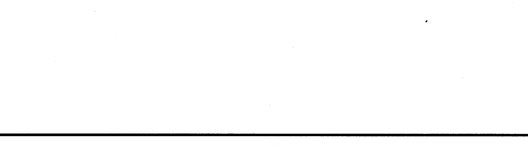

NOTE: FOR STIFF PLATES, GROUT, REINF. WELDING ETC. SEE DETAIL 11/S13

3/4"=1'-0"

PLAN SECTION

6 / S-1.4

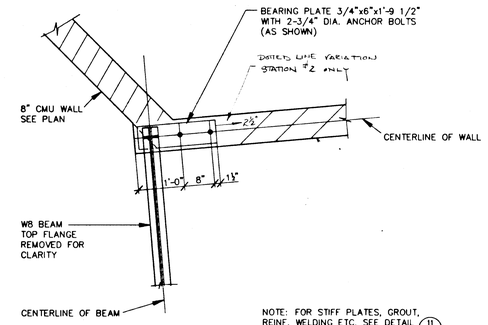

NOTE: FOR STIFF PLATES, GROUT, REINF. WELDING ETC. SEE DETAIL 11/S13

3/4"=1'-0"

PLAN SECTION

3 / S-1.4

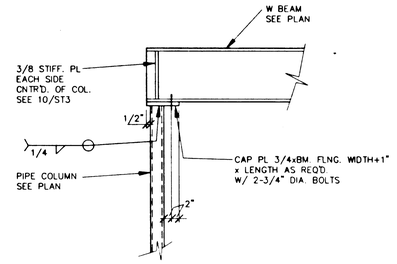

3/4"=1'-0"

SECTION

7 / S-1.4

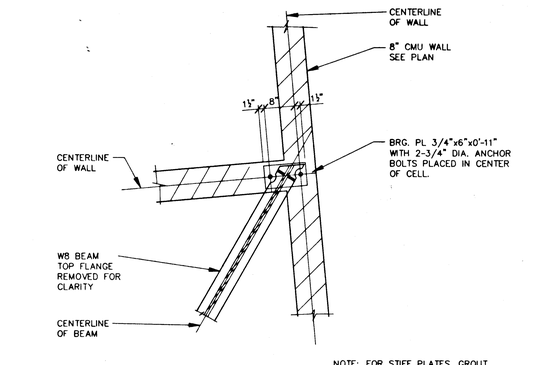

NOTE: FOR STIFF PLATES, GROUT, REINF. WELDING ETC. SEE DETAIL 11/S13

3/4"=1'-0"

PLAN SECTION

4 / S-1.4

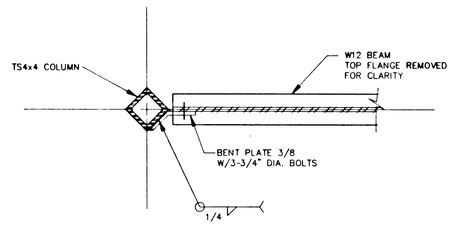

1½"=1'-0"

PLAN SECTION

8 / S-1.4

AS BUILT 12-15-89 RECORD DRAWING
RICHARDSON CONSTRUCTION INC.

REV	DATE	DESCRIPTION

RECOMMENDED R.A. NO. DATE

JOB 412.3.5 DATE 11-30-88 DRAWN R. WOOD CHECK RRK

MARTIN, PELTYN & ASSOCIATES
STRUCTURAL ENGINEERS
1001 RANCHO DRIVE SOUTH
LAS VEGAS, NEVADA 89106
(702)385-5300 JOB NO. 1968

G.C. WALLACE, INC.
Engineering/Architecture 1555 SOUTH RAINBOW BLVD./LAS VEGAS, NEVADA 89102

FIRE STATIONS
CITY OF LAS VEGAS, NEVADA

SECTIONS AND DETAILS

SHEET 72 OF 112 SHEETS
S4.4

4009 2894