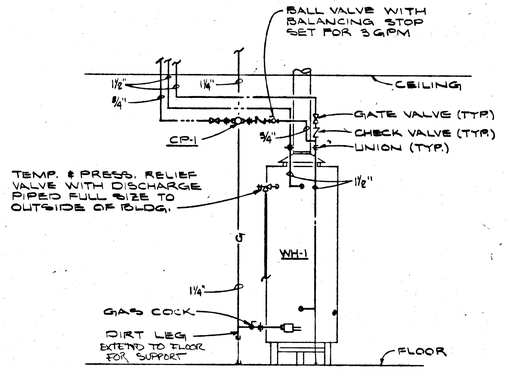

WATER HEATER DETAIL

NO SCALE

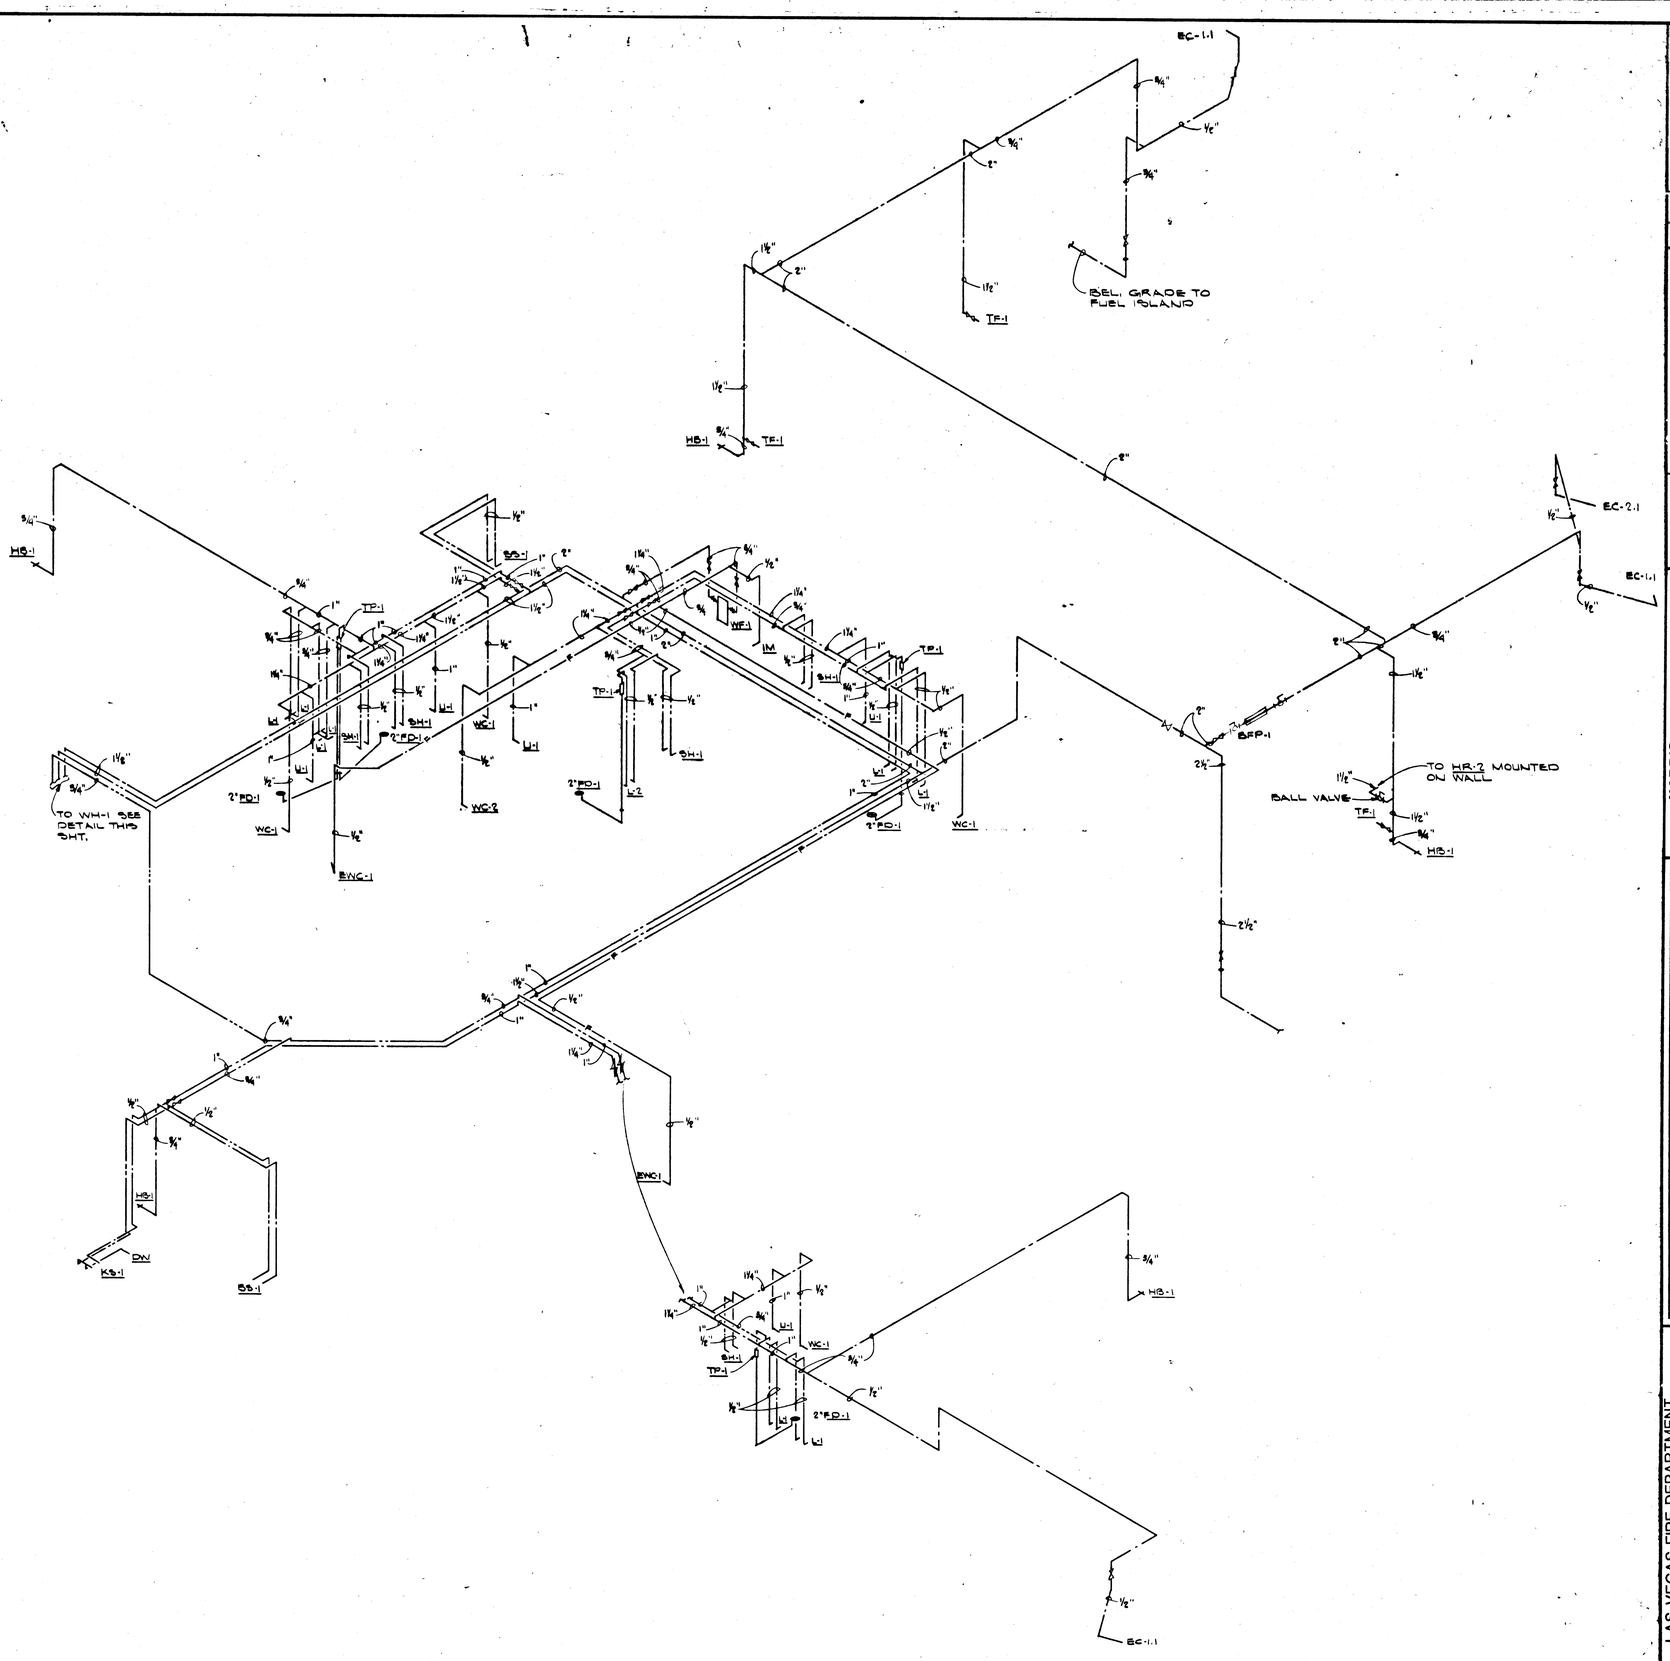

H & CW PIPING DIAGRAM

NO SCALE

AS-BUILT 12-15-89
RICHARDSON CONST. INC

HARRIS ENGINEERS, INC.
MECHANICAL/ELECTRICAL CONSULTANTS
3785 East Flamingo Road, Suite 5B
Las Vegas, Nevada 89121
702/798-9298

G.C. WALLACE, INC.
Engineering/Architecture
1555 SOUTH RAINBOW BLVD LAS VEGAS, NEVADA 89102

LAS VEGAS FIRE DEPARTMENT
CITY OF LAS VEGAS, NEVADA
PLUMBING PIPING DIAGRAMS & DETAILS
FIRE STATION NUMBER 4

SHEET 77 OF 112 SHEETS
P1.4

4014 POSTED