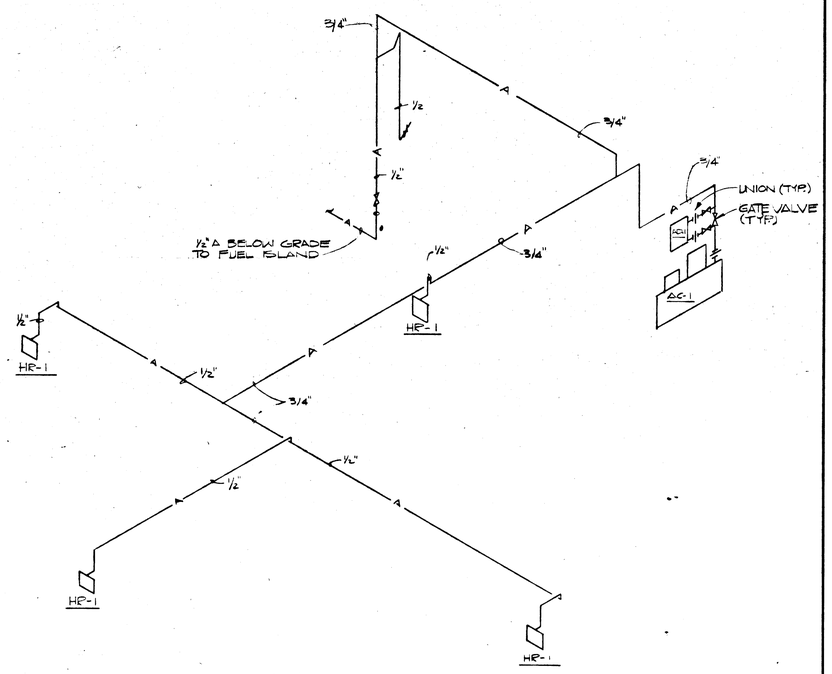

AIR PIPING DIAGRAM

NO SCALE:

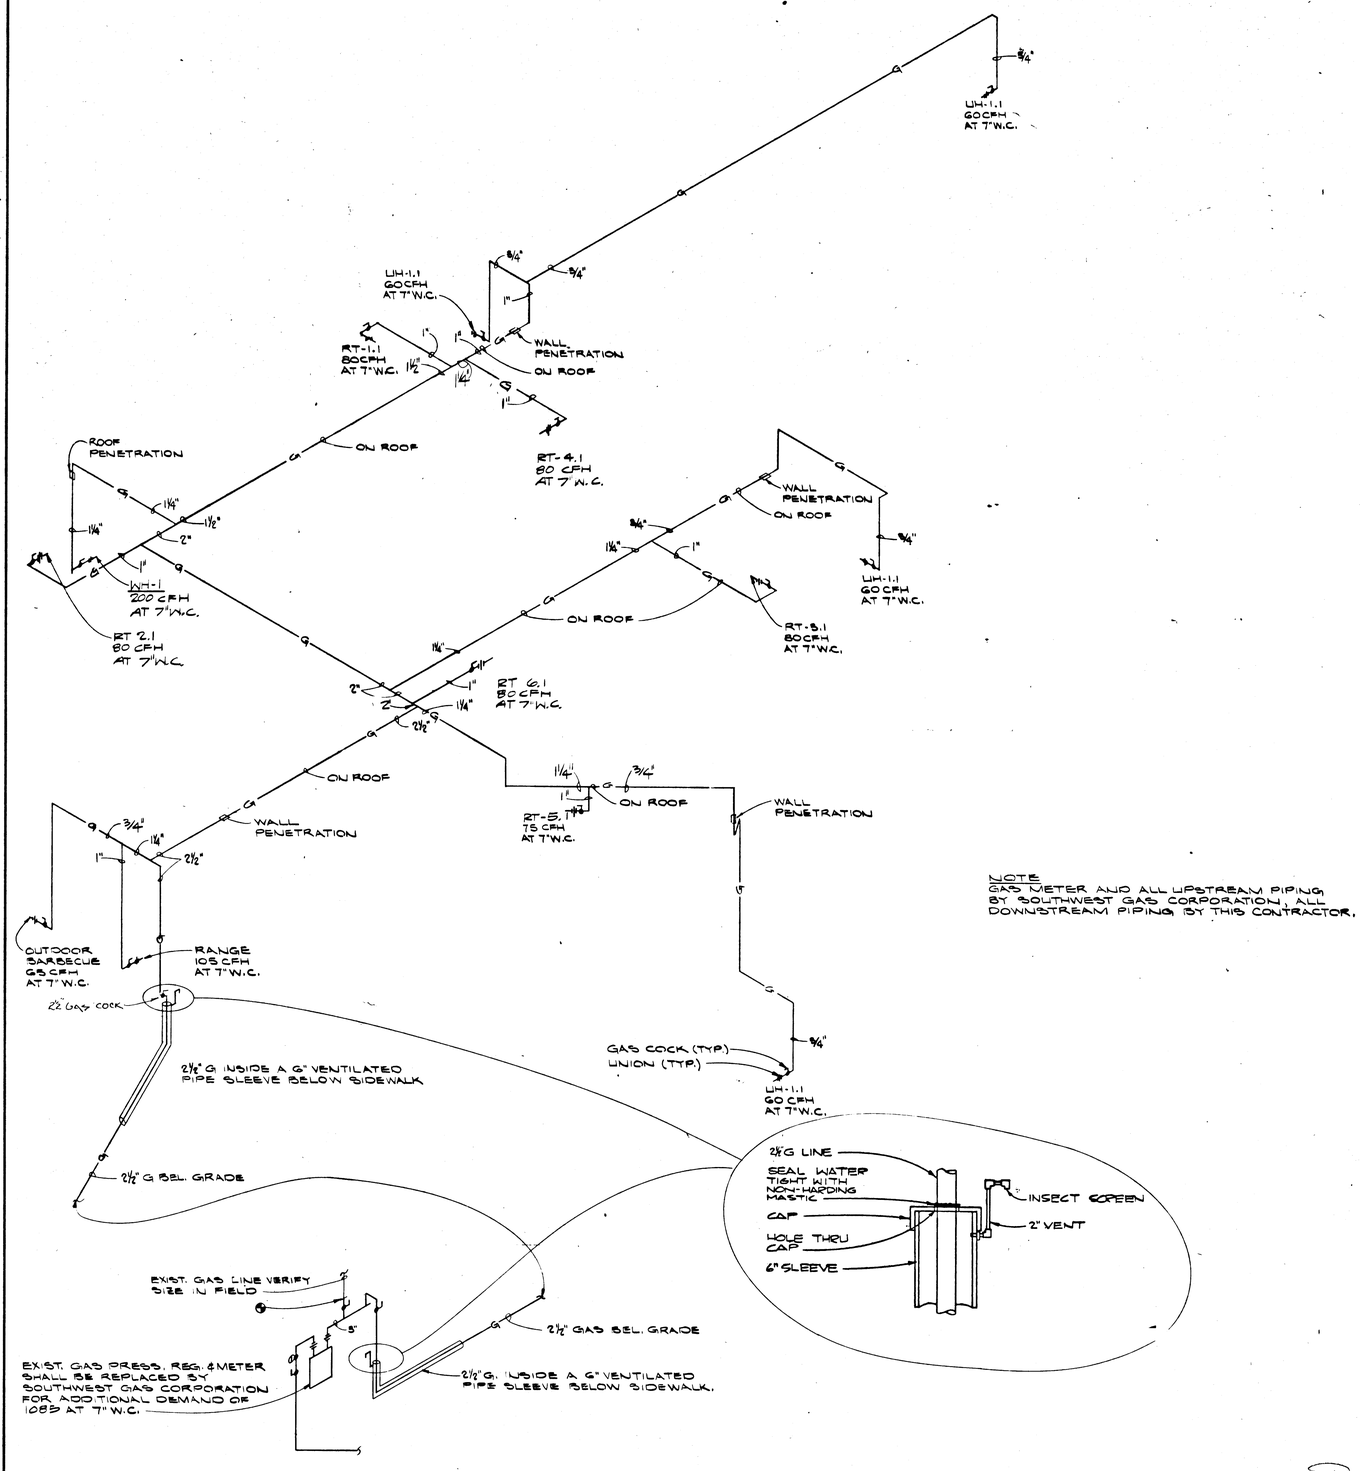

NOTE
GAS METER AND ALL UPSTREAM PIPING BY SOUTHWEST GAS CORPORATION, ALL DOWNSTREAM PIPING BY THIS CONTRACTOR.

GAS PIPING DIAGRAM

NO SCALE

RECORD DRAWING

AS-BUILT 12-15-89
RICHARDSON CONST. INC

REV	DATE	DESCRIPTION

RECOMMENDED

P.E. NO. DATE

JOB
DATE 11-17-88
DRAWN ADJCM
CHECK FTH

HARRIS ENGINEERS, INC.
MECHANICAL/ELECTRICAL CONSULTANTS
2765 East Desert Inn Road, Suite 260
Las Vegas, Nevada 89121
702/736-0120

G.C. WALLACE, INC.
Engineering/Architecture
1555 SOUTH RAINBOW BLVD./LAS VEGAS, NEVADA 89102

LAS VEGAS FIRE DEPARTMENT
CITY OF LAS VEGAS, NEVADA
PLUMBING PIPING DIAGRAMS & DETAILS
FIRE STATION NUMBER 4

SHEET 78
P.1.5
OF 112 SHEETS

4015

630 – 81