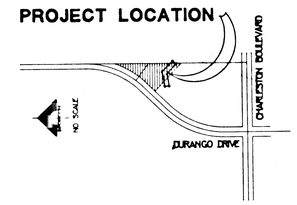

VICINITY MAP
PROPOSED FIRE STATION # 2

(1) PECCOLE RANCH AREA

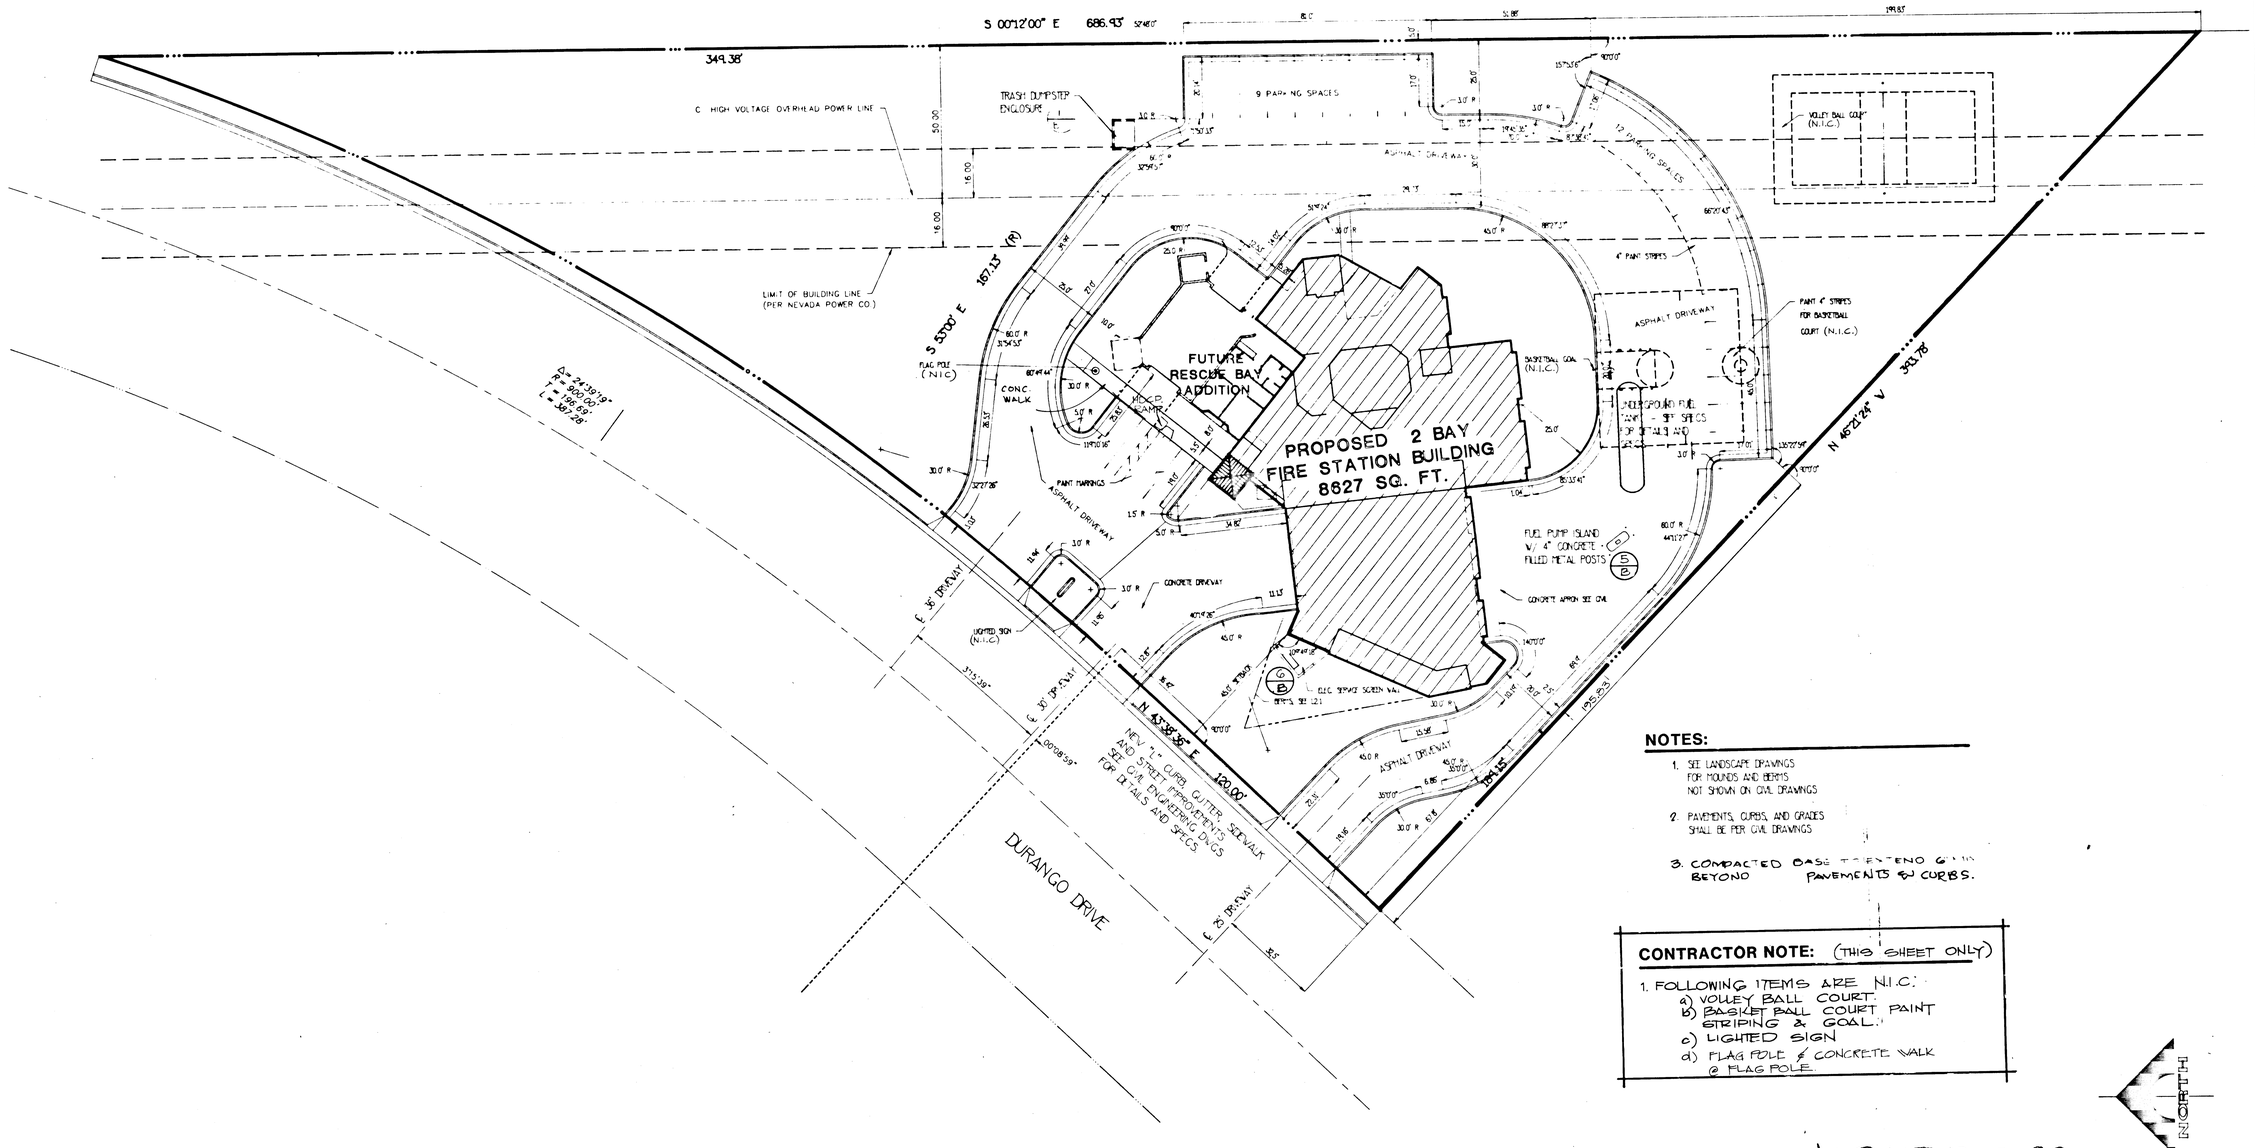

NOTES:

1. SEE LANDSCAPE DRAWINGS FOR MOUNDS AND BERMS NOT SHOWN ON CIVIL DRAWINGS
2. PAVEMENTS, CURBS, AND GRADES SHALL BE PER CIVIL DRAWINGS
3. COMPACTED BASE TO EXTEND 6" IN BEYOND PAVEMENTS & CURBS.

CONTRACTOR NOTE: (THIS SHEET ONLY)

1. FOLLOWING ITEMS ARE N.I.C.:
   a) VOLLEY BALL COURT
   b) BASKET BALL COURT PAINT STRIPING & GOAL.
   c) LIGHTED SIGN
   d) FLAG POLE & CONCRETE WALK @ FLAG POLE.

(A) **SITE PLAN - STATION NUMBER 2**

SCALE: 1" = 20'

AS-BUILT 12-15-89
RICHARDSON CONST. INC.

DESCRIPTION	REV	DATE

RECOMMENDED: R.E. NO. DATE

JOB DATE 11-30-88 DRAWN CHECK

G.C. WALLACE, INC.
Engineering/Architecture
5555 SOUTH BANDOW BLVD / LAS VEGAS, NEVADA 89102

LAS VEGAS FIRE DEPARTMENT
CITY OF LAS VEGAS, NEVADA
SITE PLAN FIRE STATION # 2

SHEET NO. 4 A.2.1 OF 112 SHEETS

JOB NO.

3941

630 - 81