


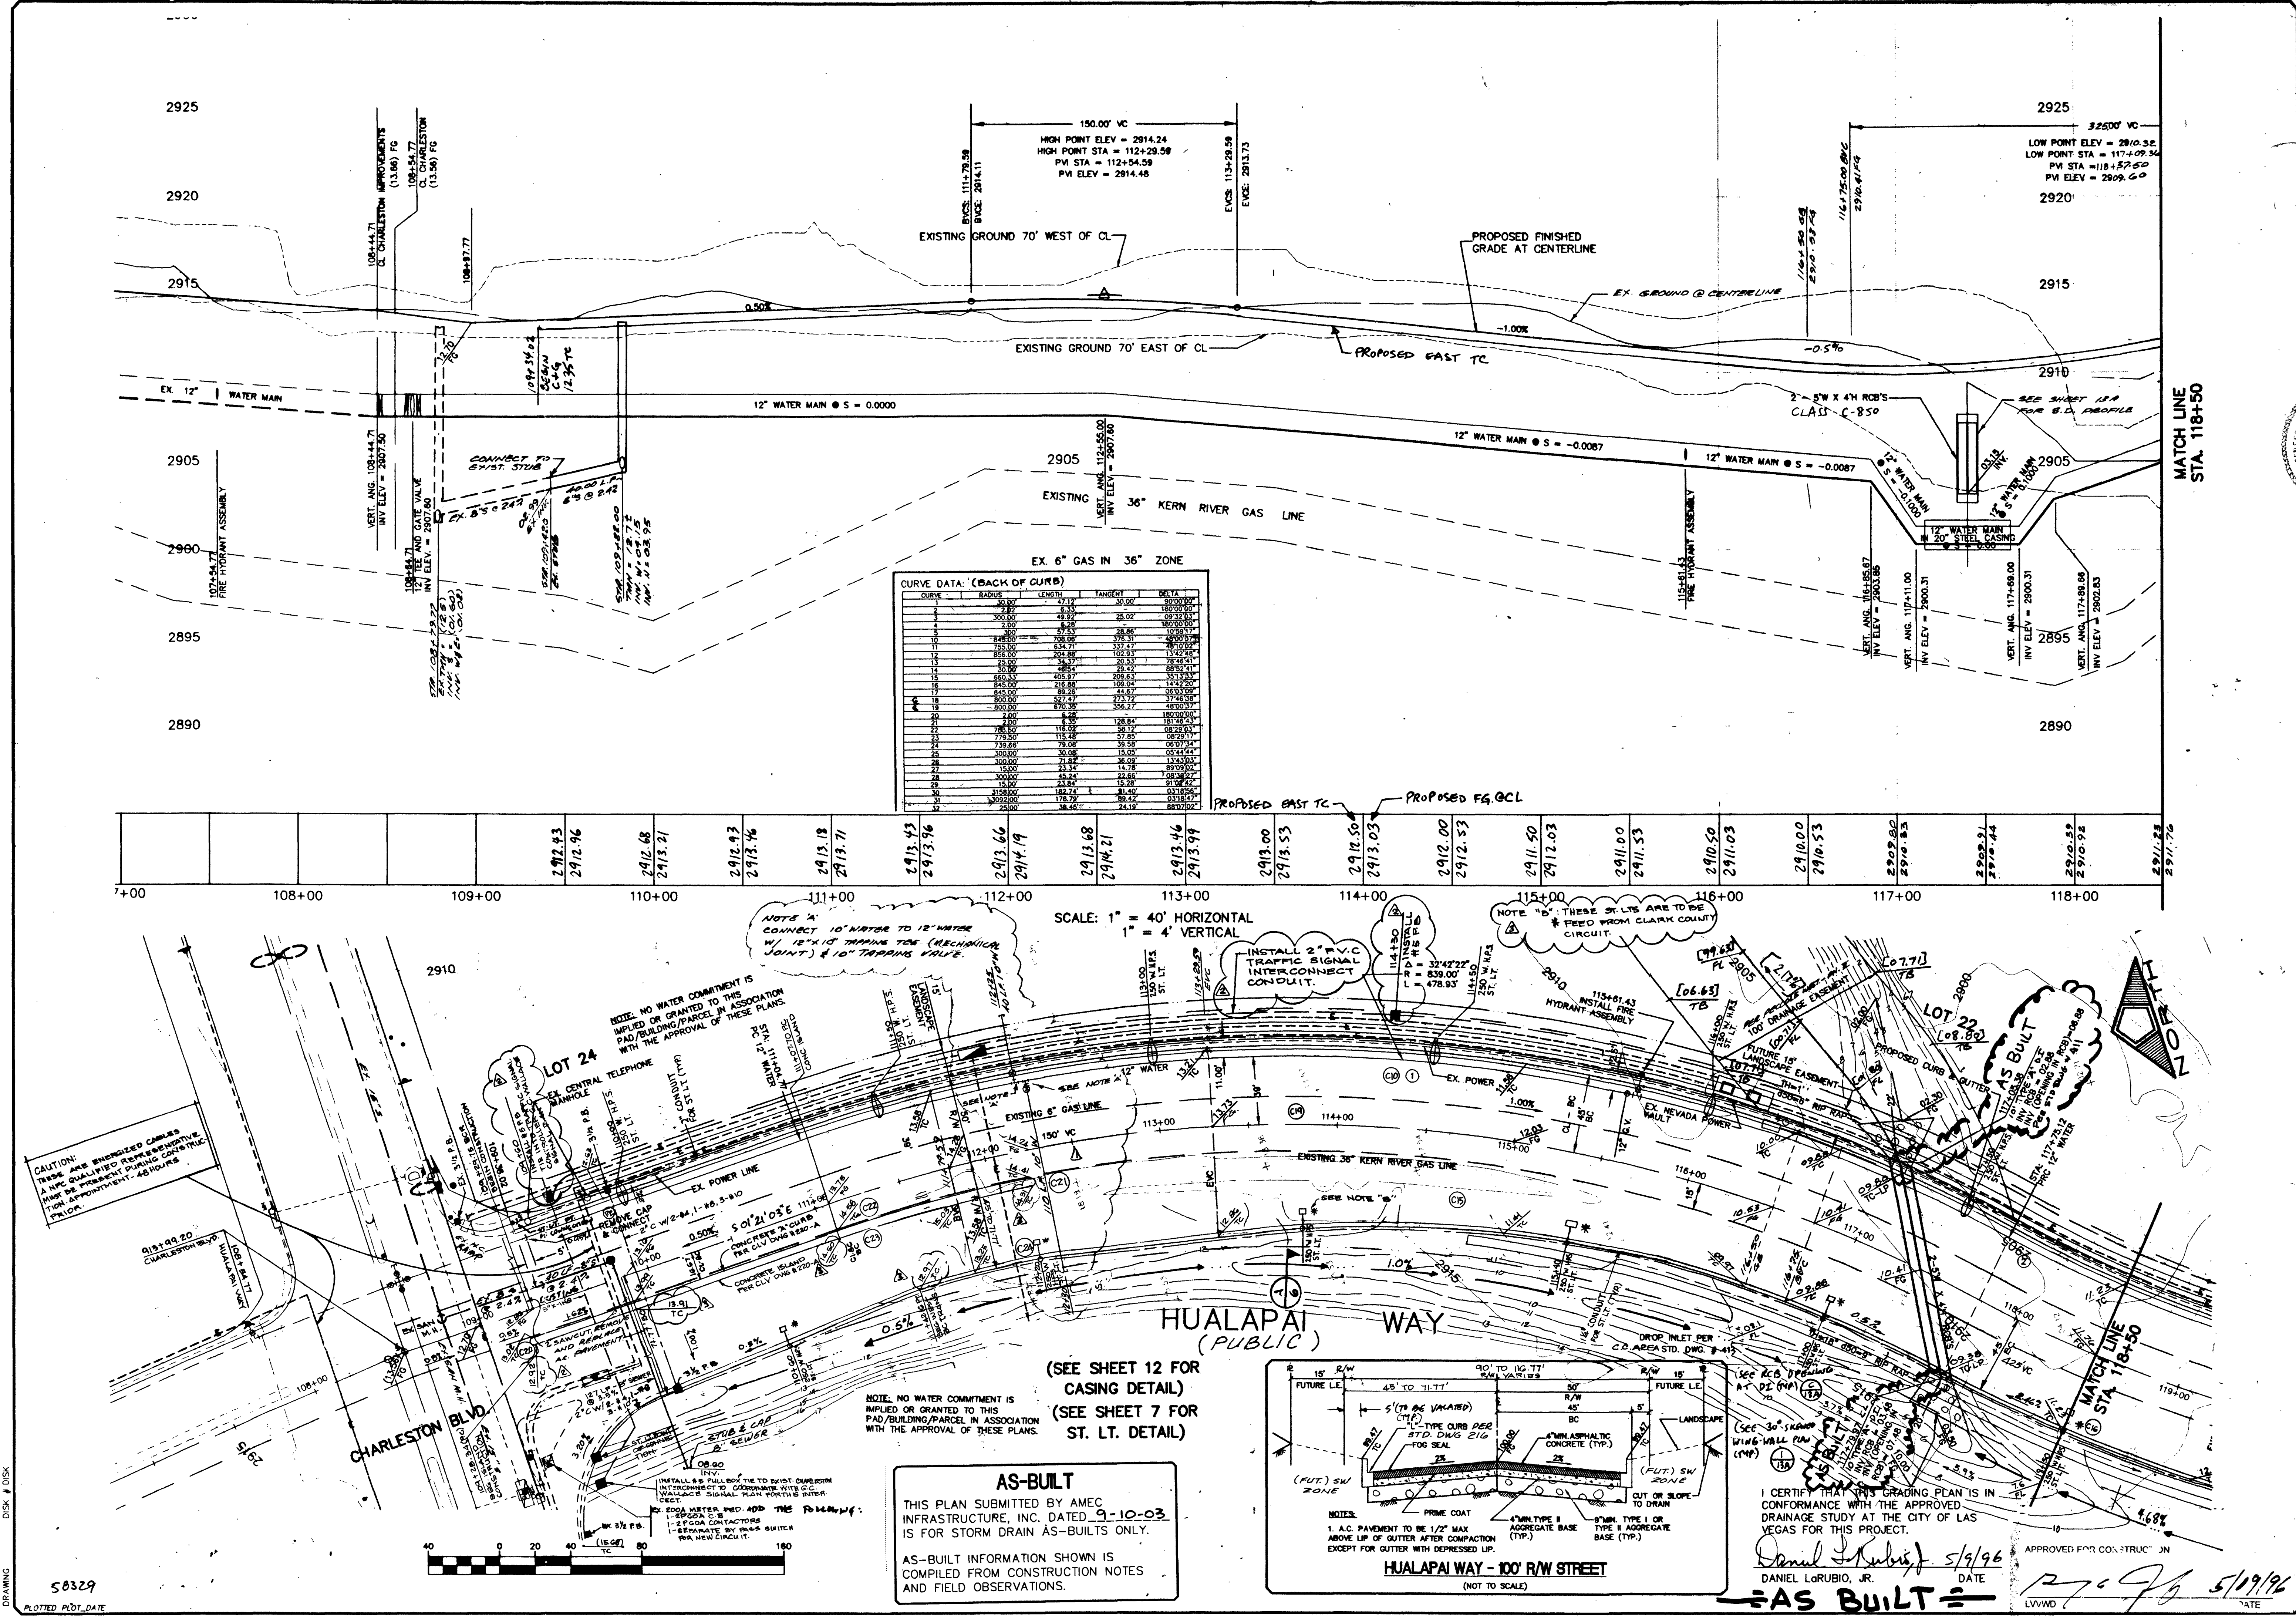

REVISIONS

NO.	DESCRIPTION	DATE
1	REVISED ST. LYS.	5/19/96
2	REVISED INTERSECTION LANE DIVISIONS	5/19/96
3	ADD 2' TO WATER MAINS	5/19/96

DATE

03/19/96

DRAWN BY

DANIEL LORUBIO, JR.

CHECKED BY

DANIEL LORUBIO, JR.

DESIGNED BY

DANIEL LORUBIO, JR.

JOB NO.

0145.0023

SCALE

AS SHOWN

PENTACORE

CIVIL ENGINEERING AND SURVEYING - PLANNING
CONSTRUCTION MANAGEMENT CONSULTING
6783 WEST CHARLESTON BOULEVARD
LAS VEGAS, NEVADA 89102 (702)258-0115

PECCOLE NEVADA CORP.

PECCOLE WEST PHASE II

PLAN AND PROFILE - HUALAPAI WAY
STA. 107+00 TO 118+50

SHEET

4

OF 15