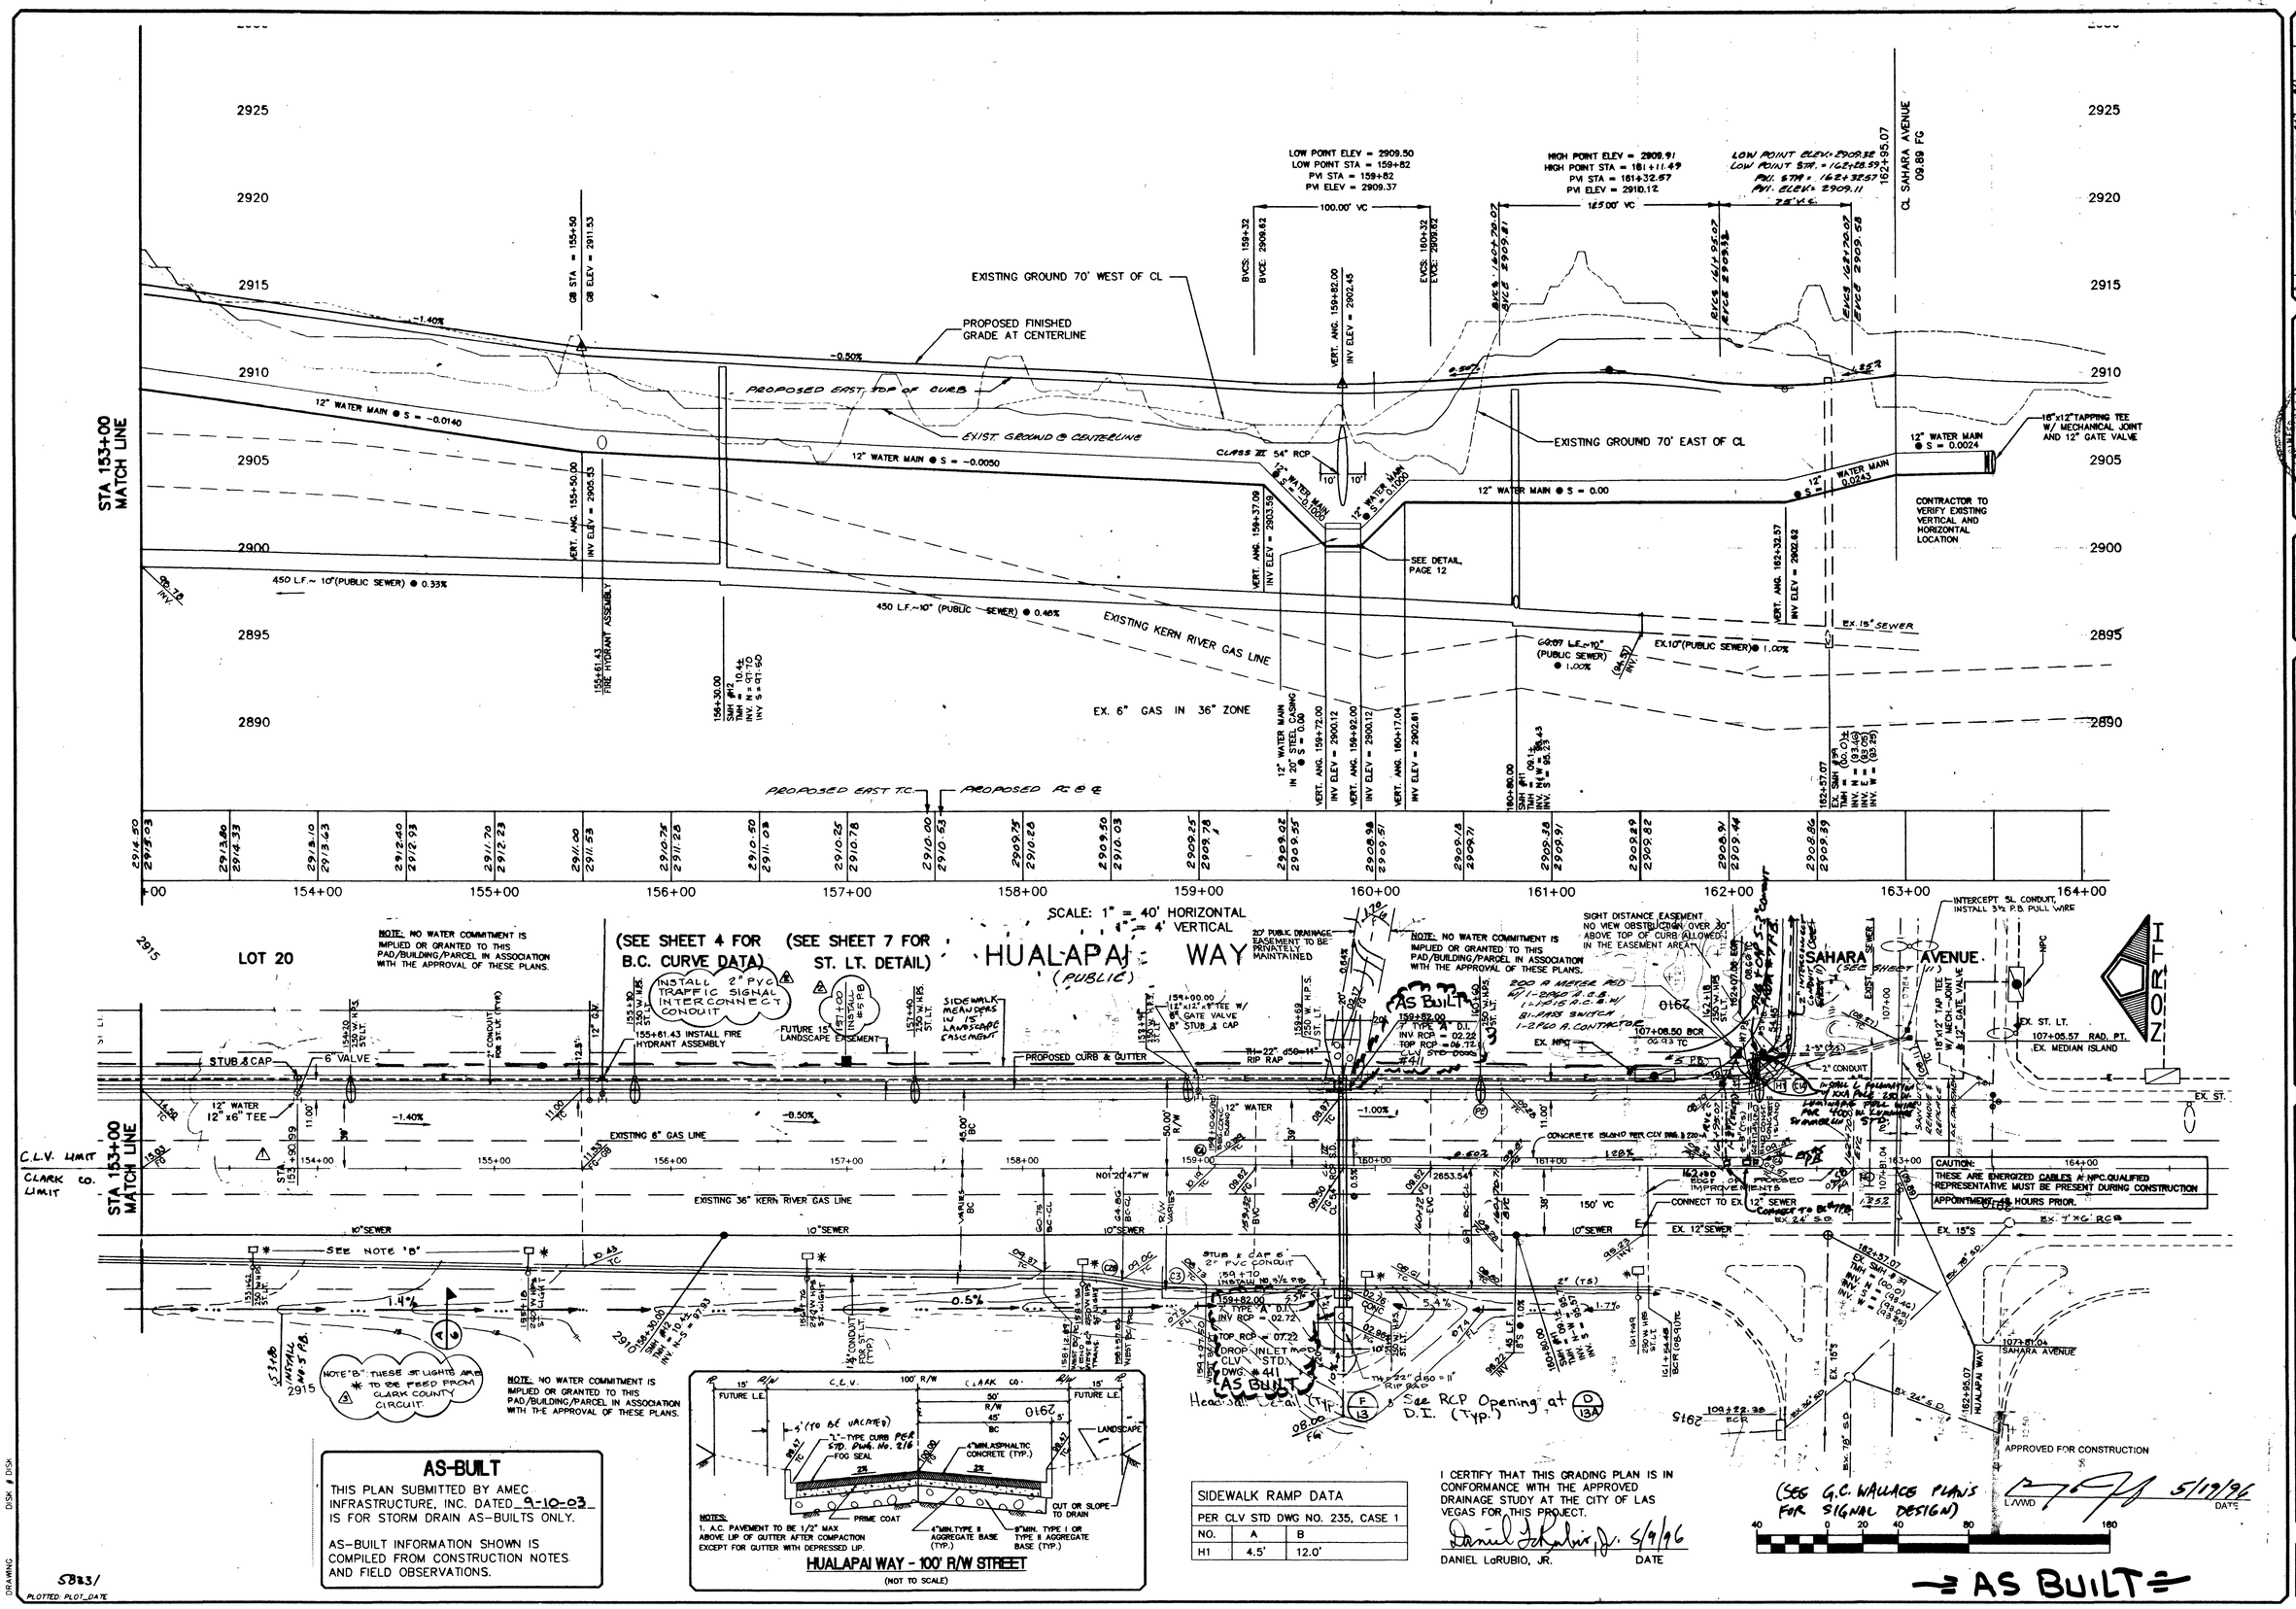

AS-BUILT

THIS PLAN SUBMITTED BY AMEC INFRASTRUCTURE, INC. DATED 9-10-03 IS FOR STORM DRAIN AS-BUILTS ONLY.

AS-BUILT INFORMATION SHOWN IS COMPILED FROM CONSTRUCTION NOTES AND FIELD OBSERVATIONS.

HUALAPAI WAY - 100' R/W STREET

(NOT TO SCALE)

NOTES:
1. A.C. PAVEMENT TO BE 1/2" MAX ABOVE LIP OF GUTTER AFTER COMPACTION EXCEPT FOR GUTTER WITH DEPRESSED LIP.

SIDEWALK RAMP DATA		
PER CLV STD DWG NO. 235, CASE 1		
NO.	A	B
H1	4.5'	12.0'

I CERTIFY THAT THIS GRADING PLAN IS IN CONFORMANCE WITH THE APPROVED DRAINAGE STUDY AT THE CITY OF LAS VEGAS FOR THIS PROJECT.

DANIEL LaRUBIO, JR. DATE 5/9/96

NO.	DESCRIPTION	DATE	APP'D
1	REVISE STUB LOCATION	5/21/96	
2	PG&E-INTERCONN. CONDUIT & MISC. REVISIONS, plus PG	5/14/96	
3	REVISED ST. LIGHTS/TRAFFIC SIGNAL	5/14/96	

RECORD DRAWING 5/19/96 DANIEL LARUBIO, JR. P. E. 8625

DATE: 03/18/96
DRAWN BY: JM
DESIGNED BY:
CHECKED BY:
JOB NO.: 0145.0025
SCALE: AS SHOWN

PENTACORE
CIVIL ENGINEERING • LAND SURVEYING • PLANNING
CONSTRUCTION MANAGEMENT • ADA CONSULTING
5795 W. SAHARA AVENUE, SUITE 200
LAS VEGAS, NEVADA 89102 (702)258-0115

PECCOLE NEVADA CORP.
PECCOLE WEST PHASE II
PLAN AND PROFILE – HUALAPAI WAY STA. 153+00 TO 163+50

SHEET 8 OF 15

5823/
PLOTTED PLOT_DATE
DRAWING
DISK # DISK