


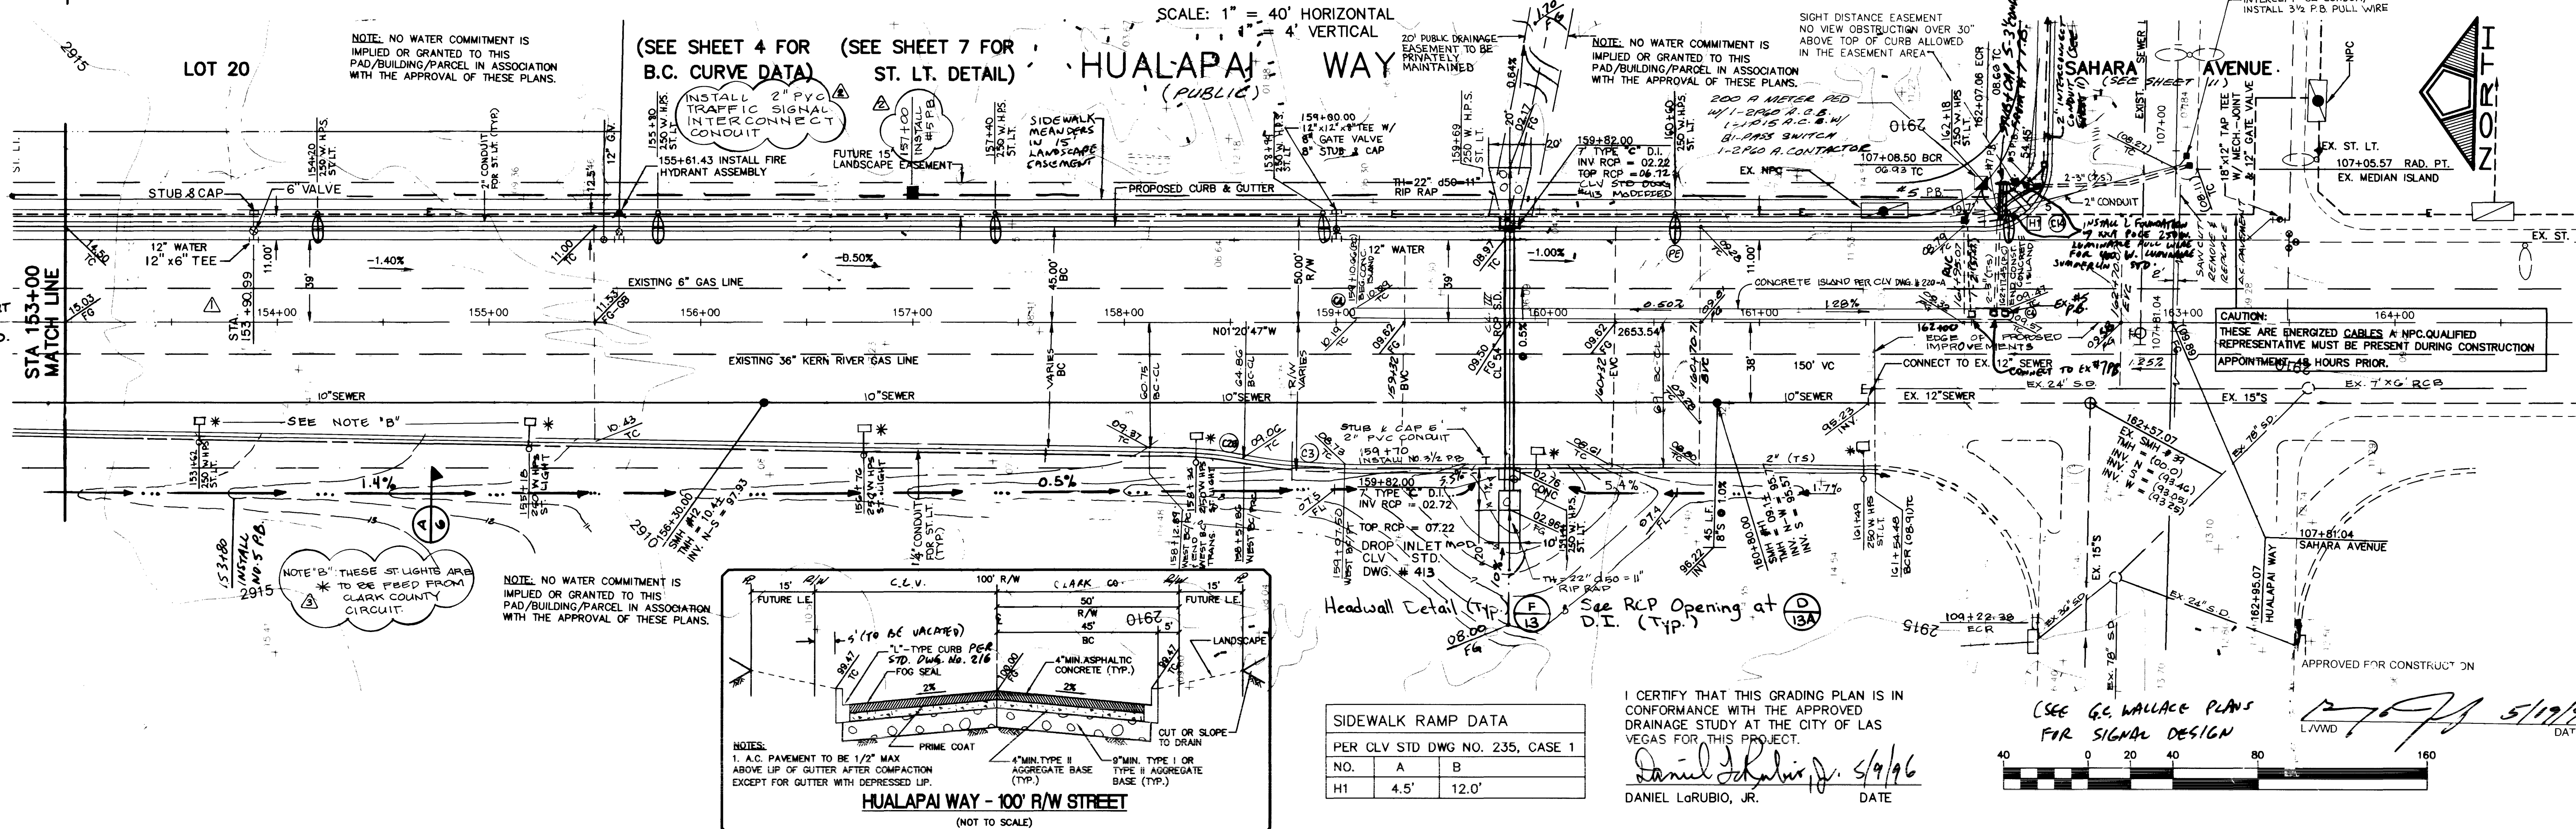

SHEET
8