

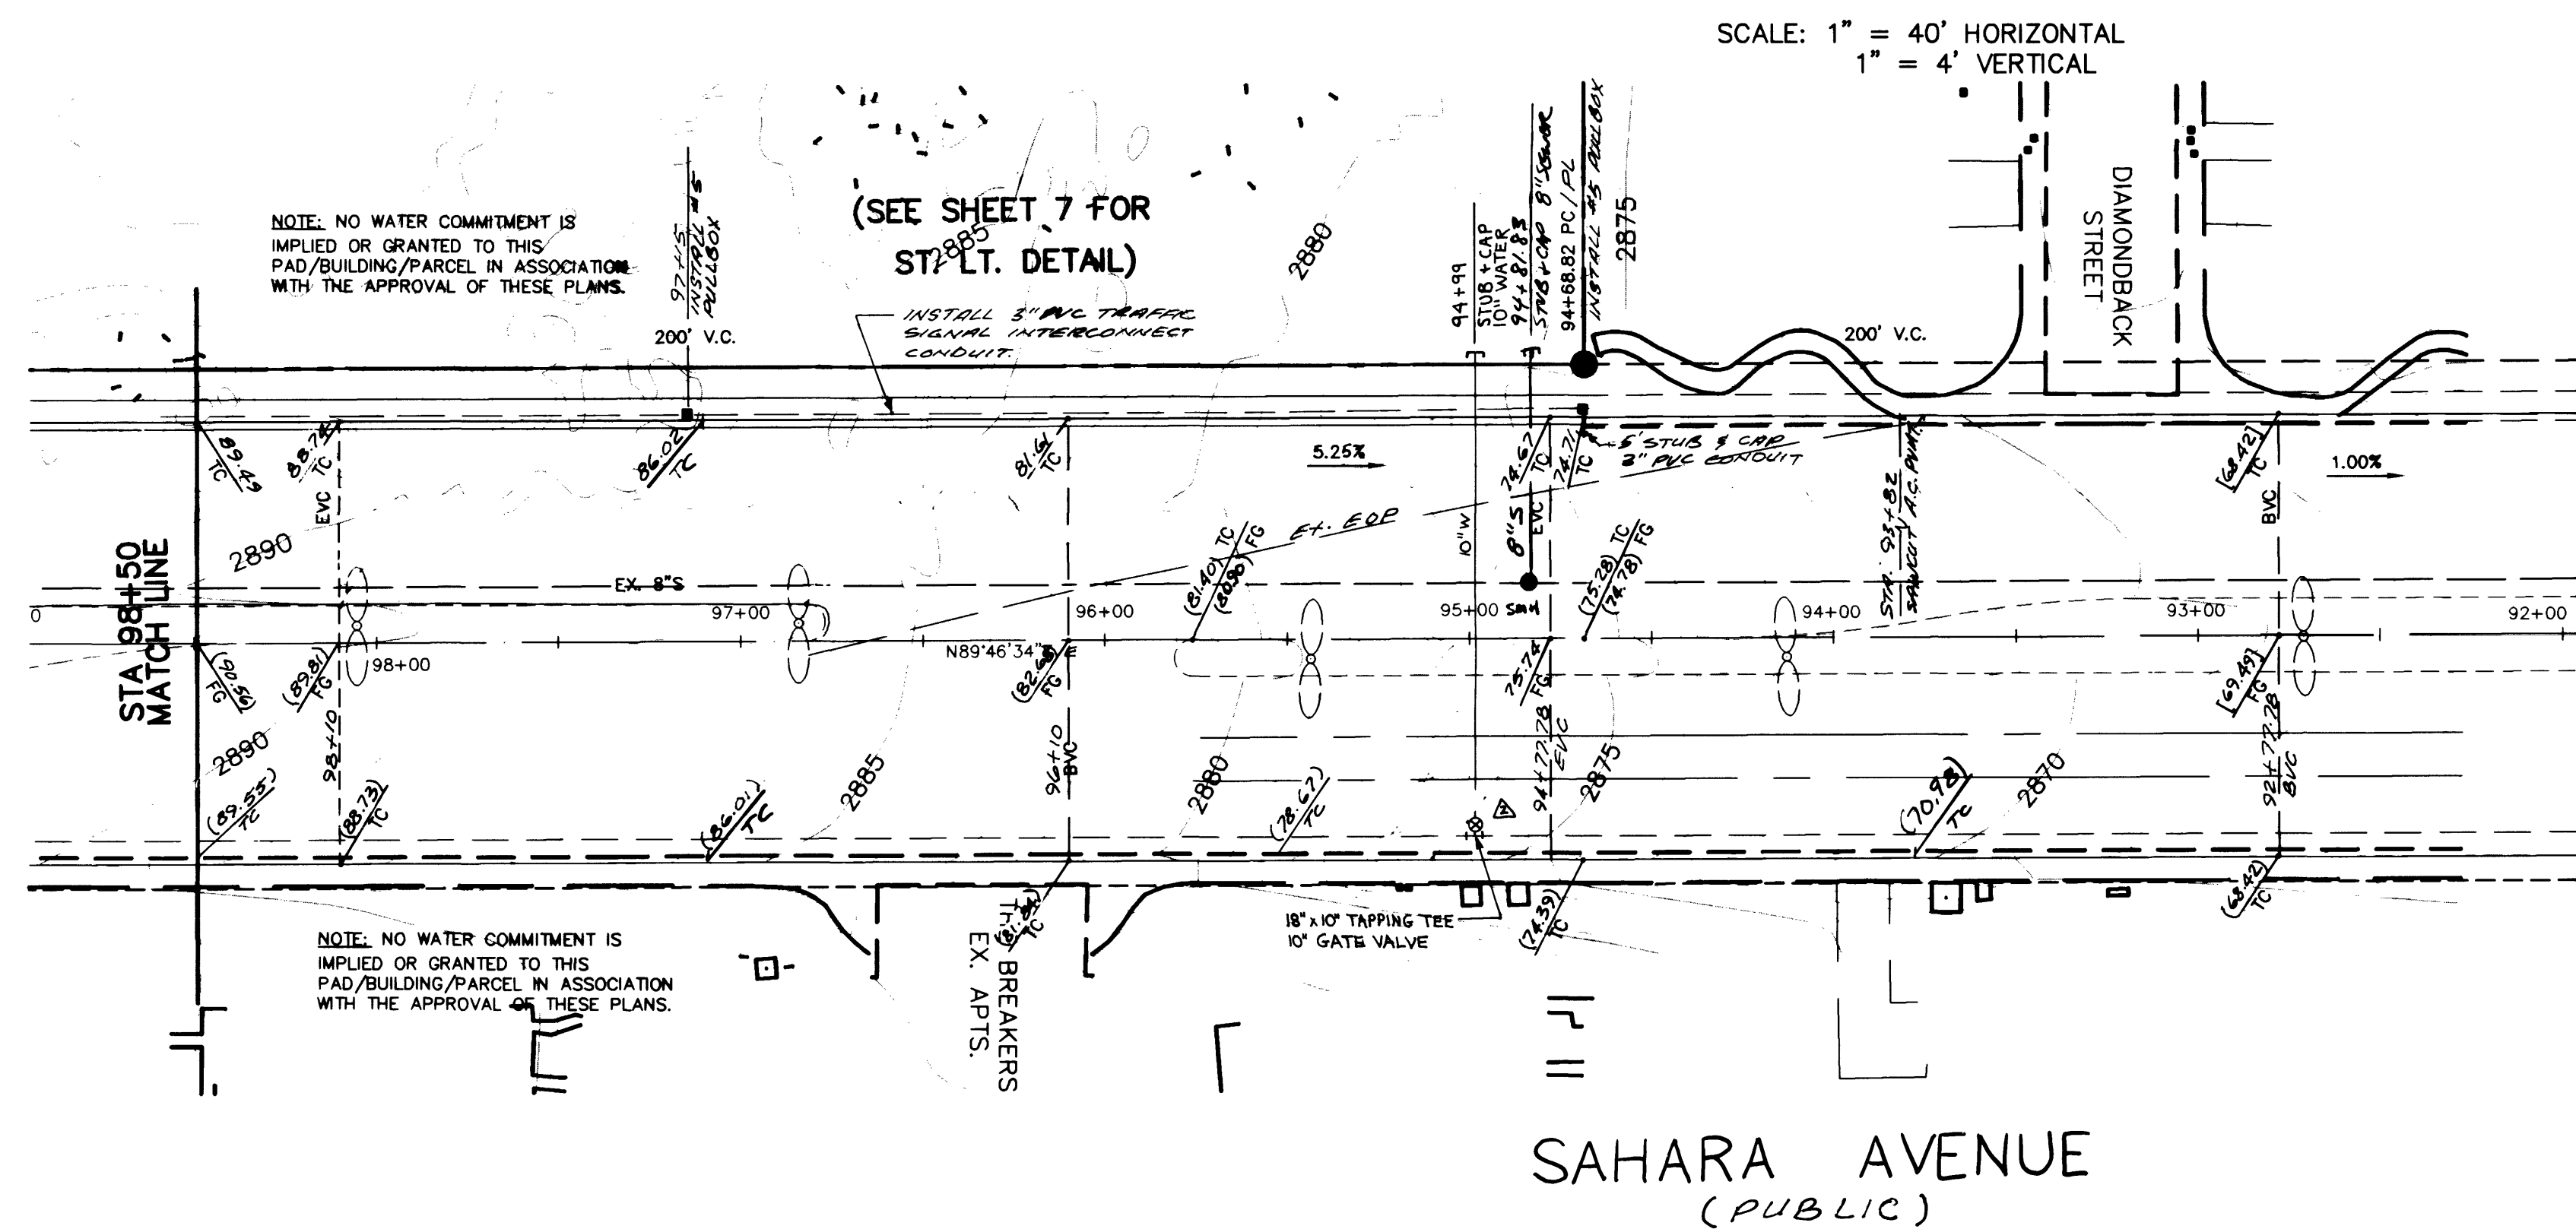
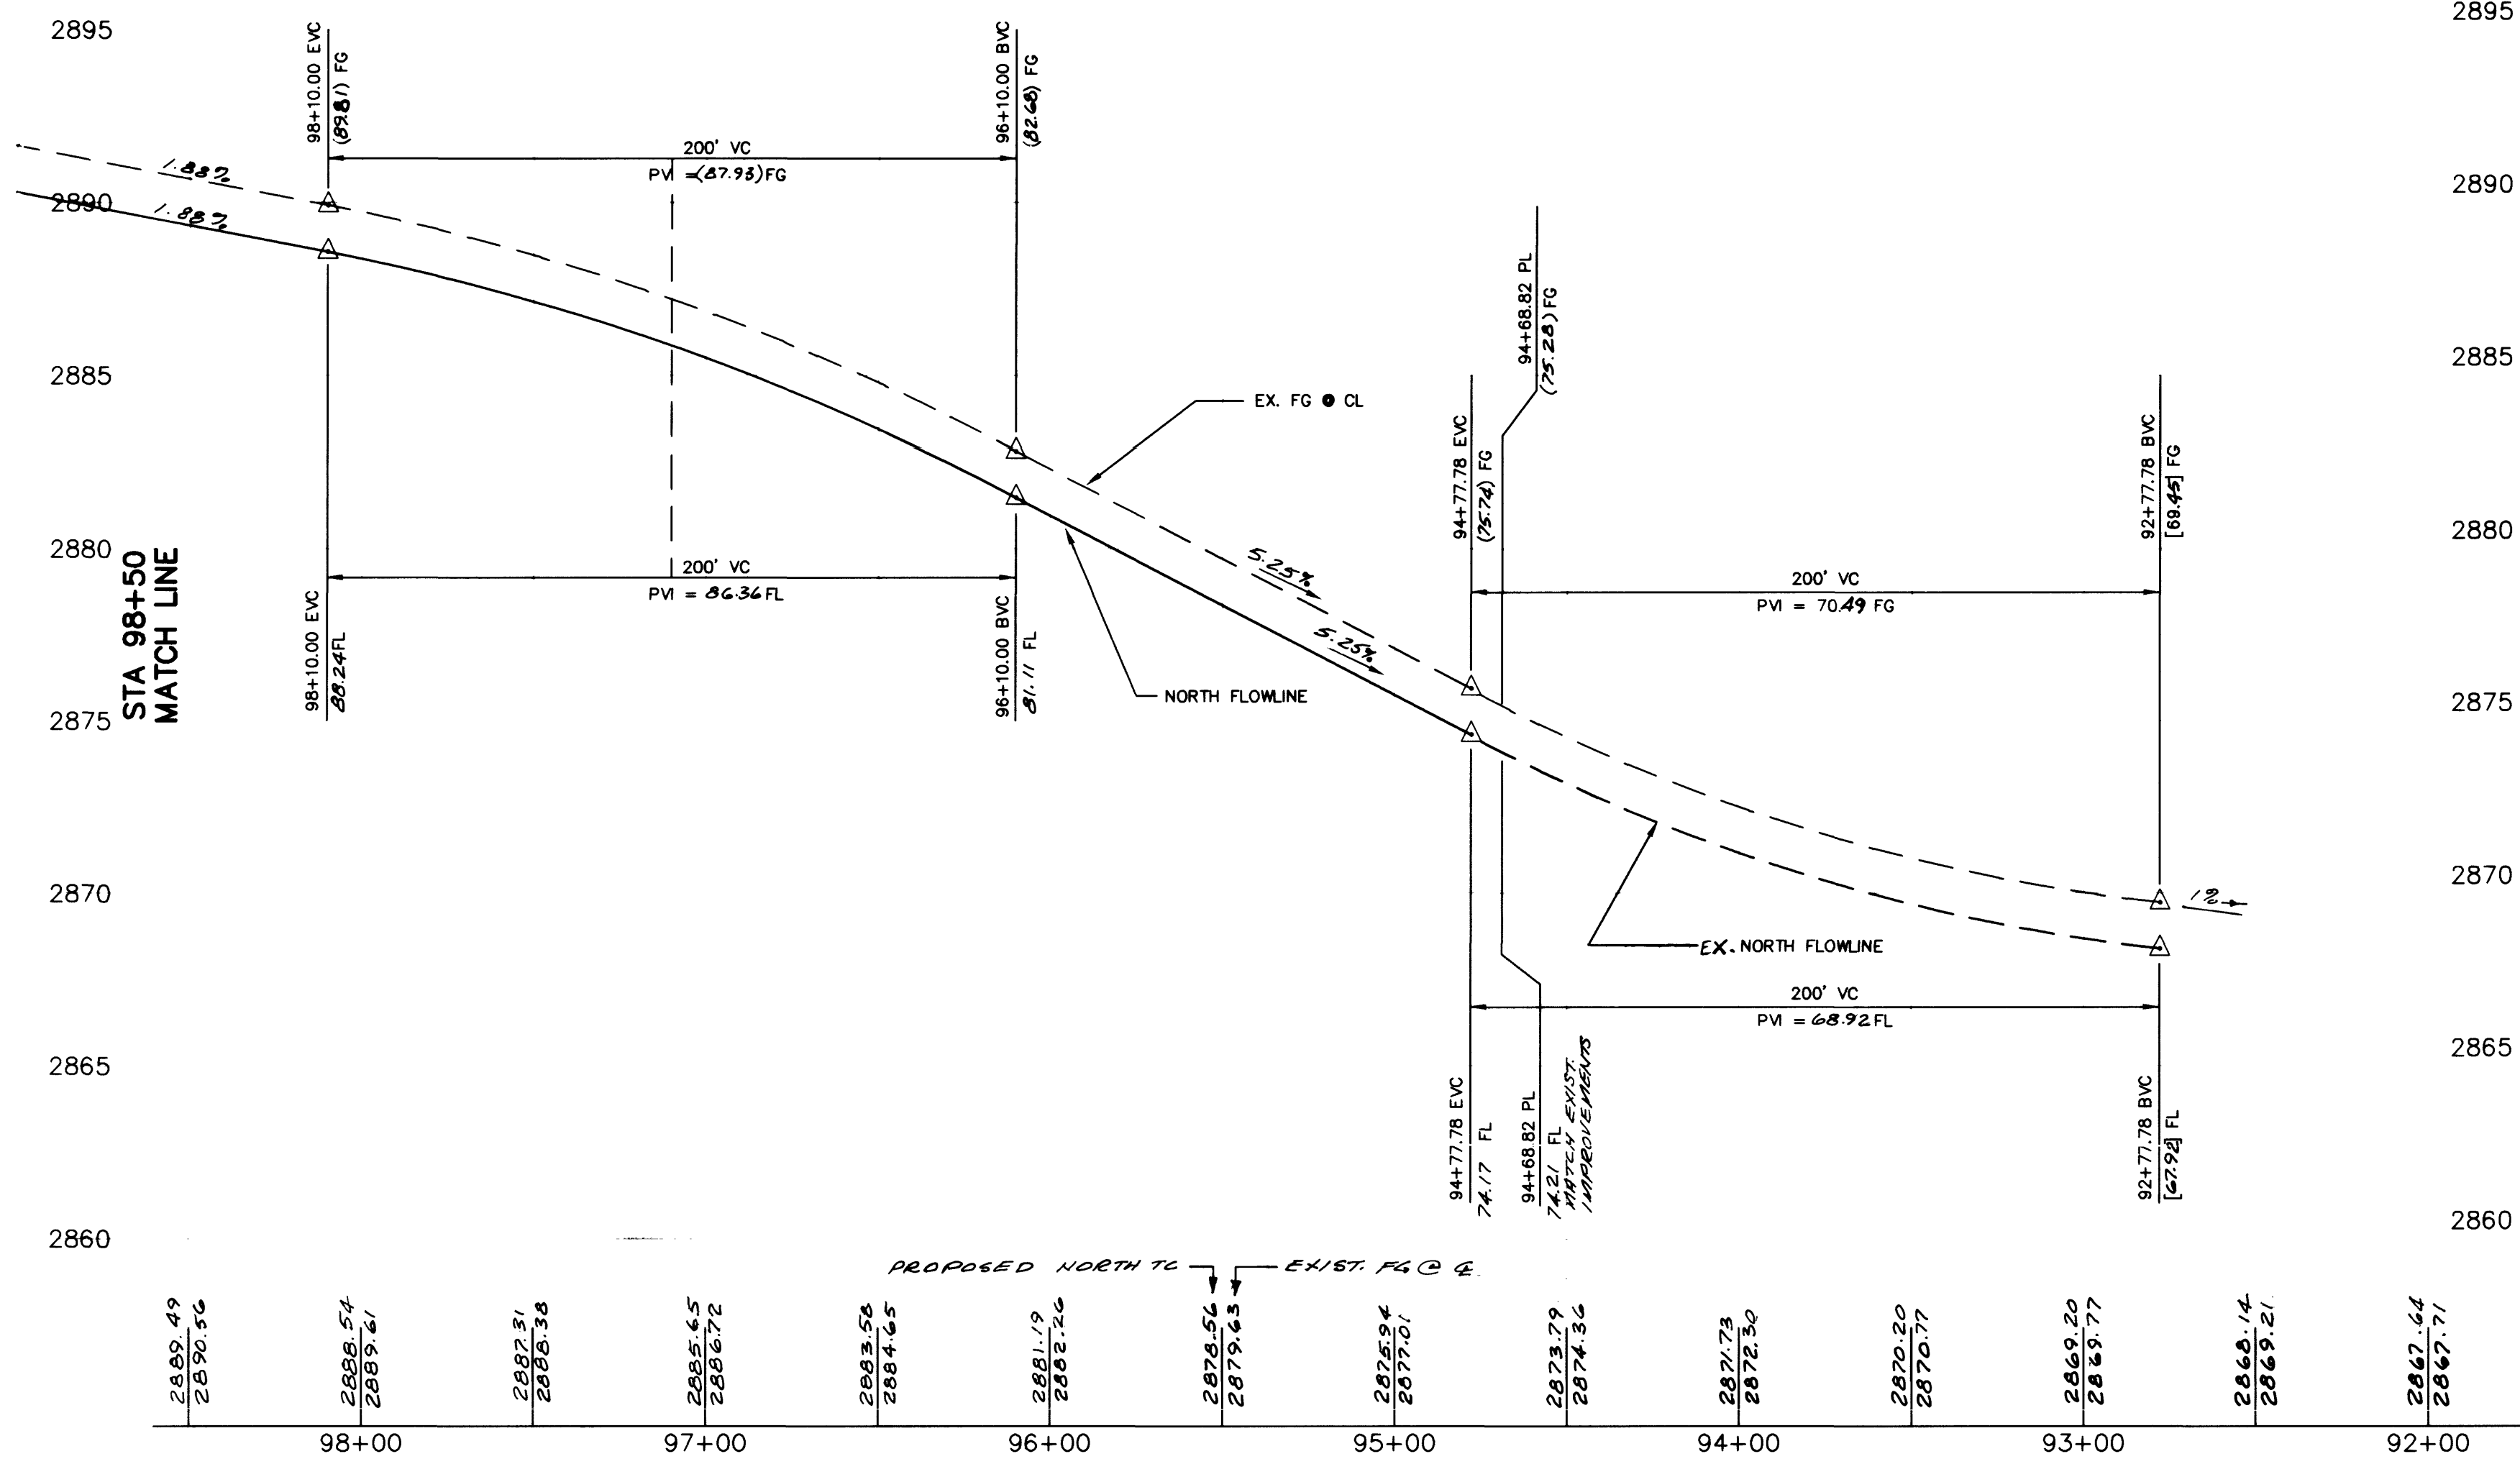
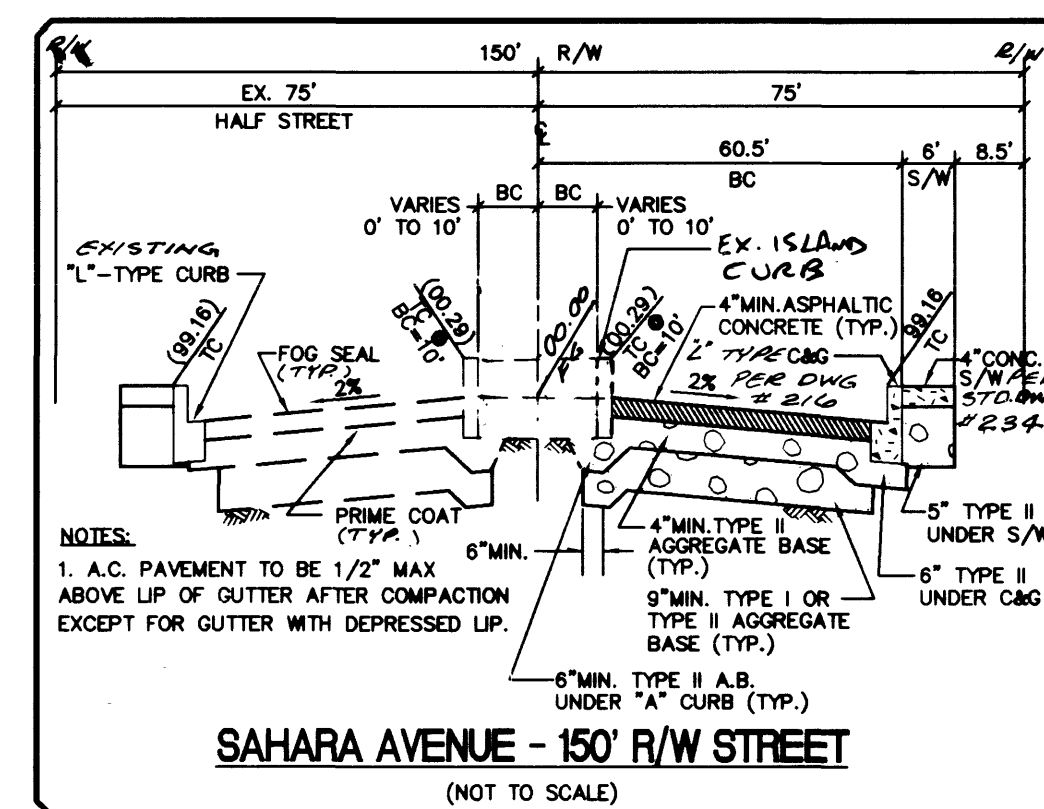


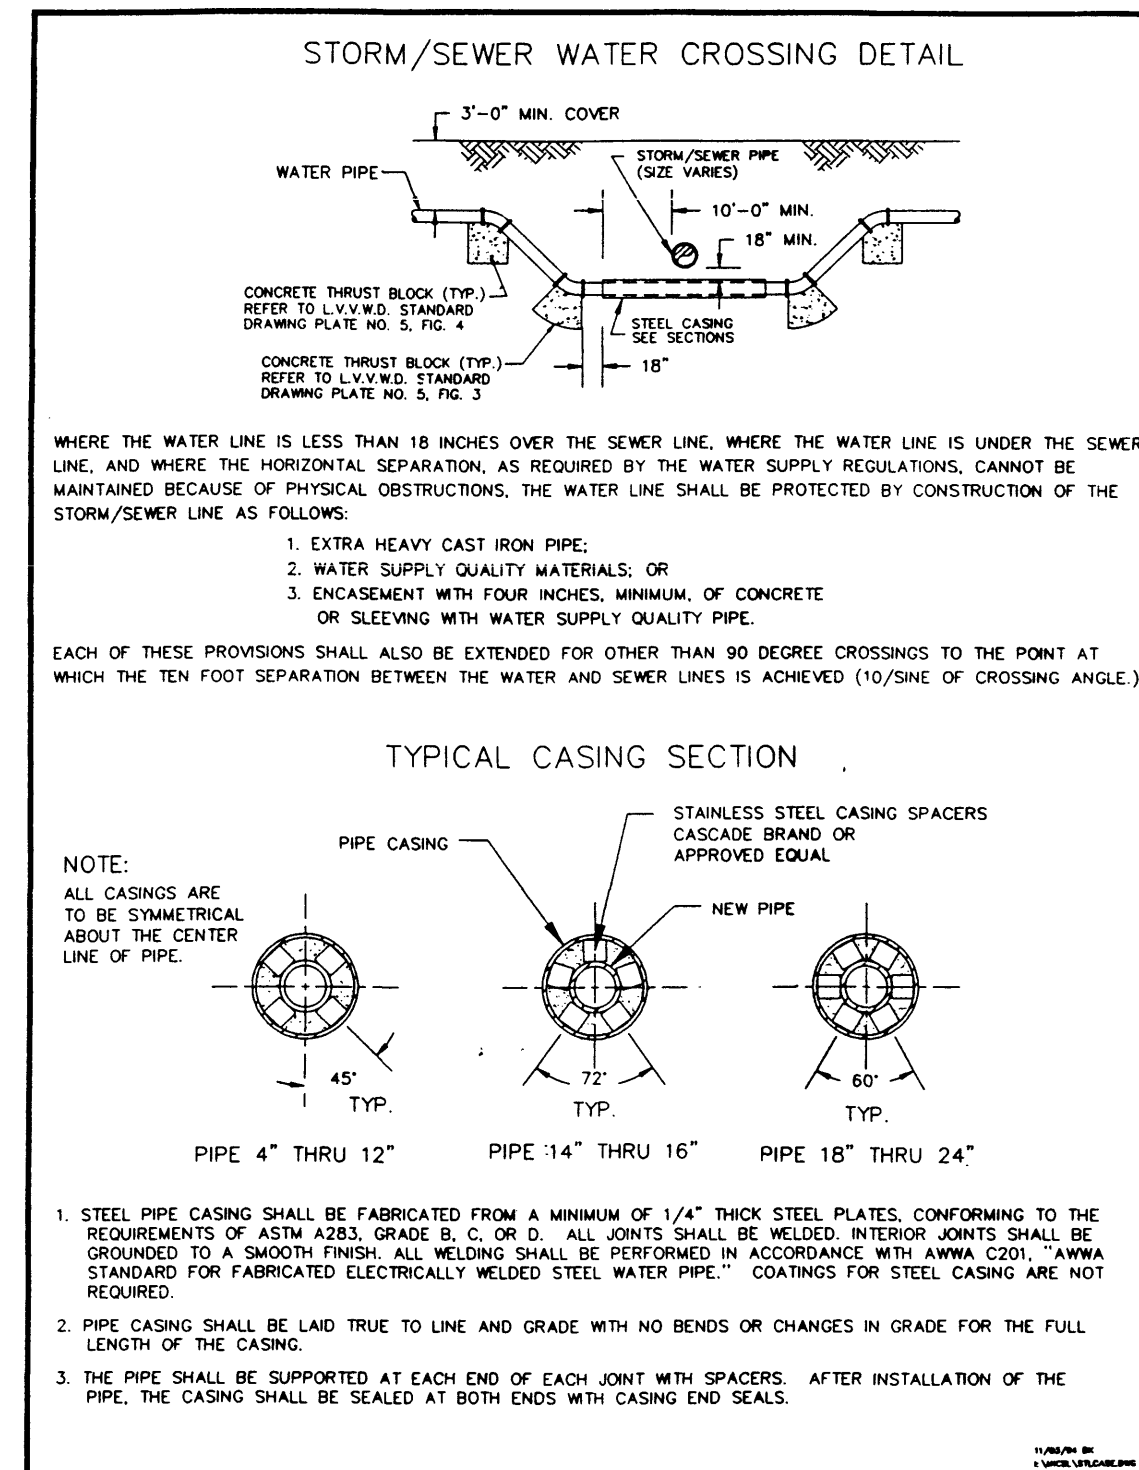

APPROVED FOR CONSTRUCTION

LVWD 5/19/96
DATE

I CERTIFY THAT THIS GRADING PLAN IS IN CONFORMANCE WITH THE APPROVED DRAINAGE STUDY AT THE CITY OF LAS VEGAS FOR THIS PROJECT.
Daniel L. Rubio, Jr. 5/19/96
DATE

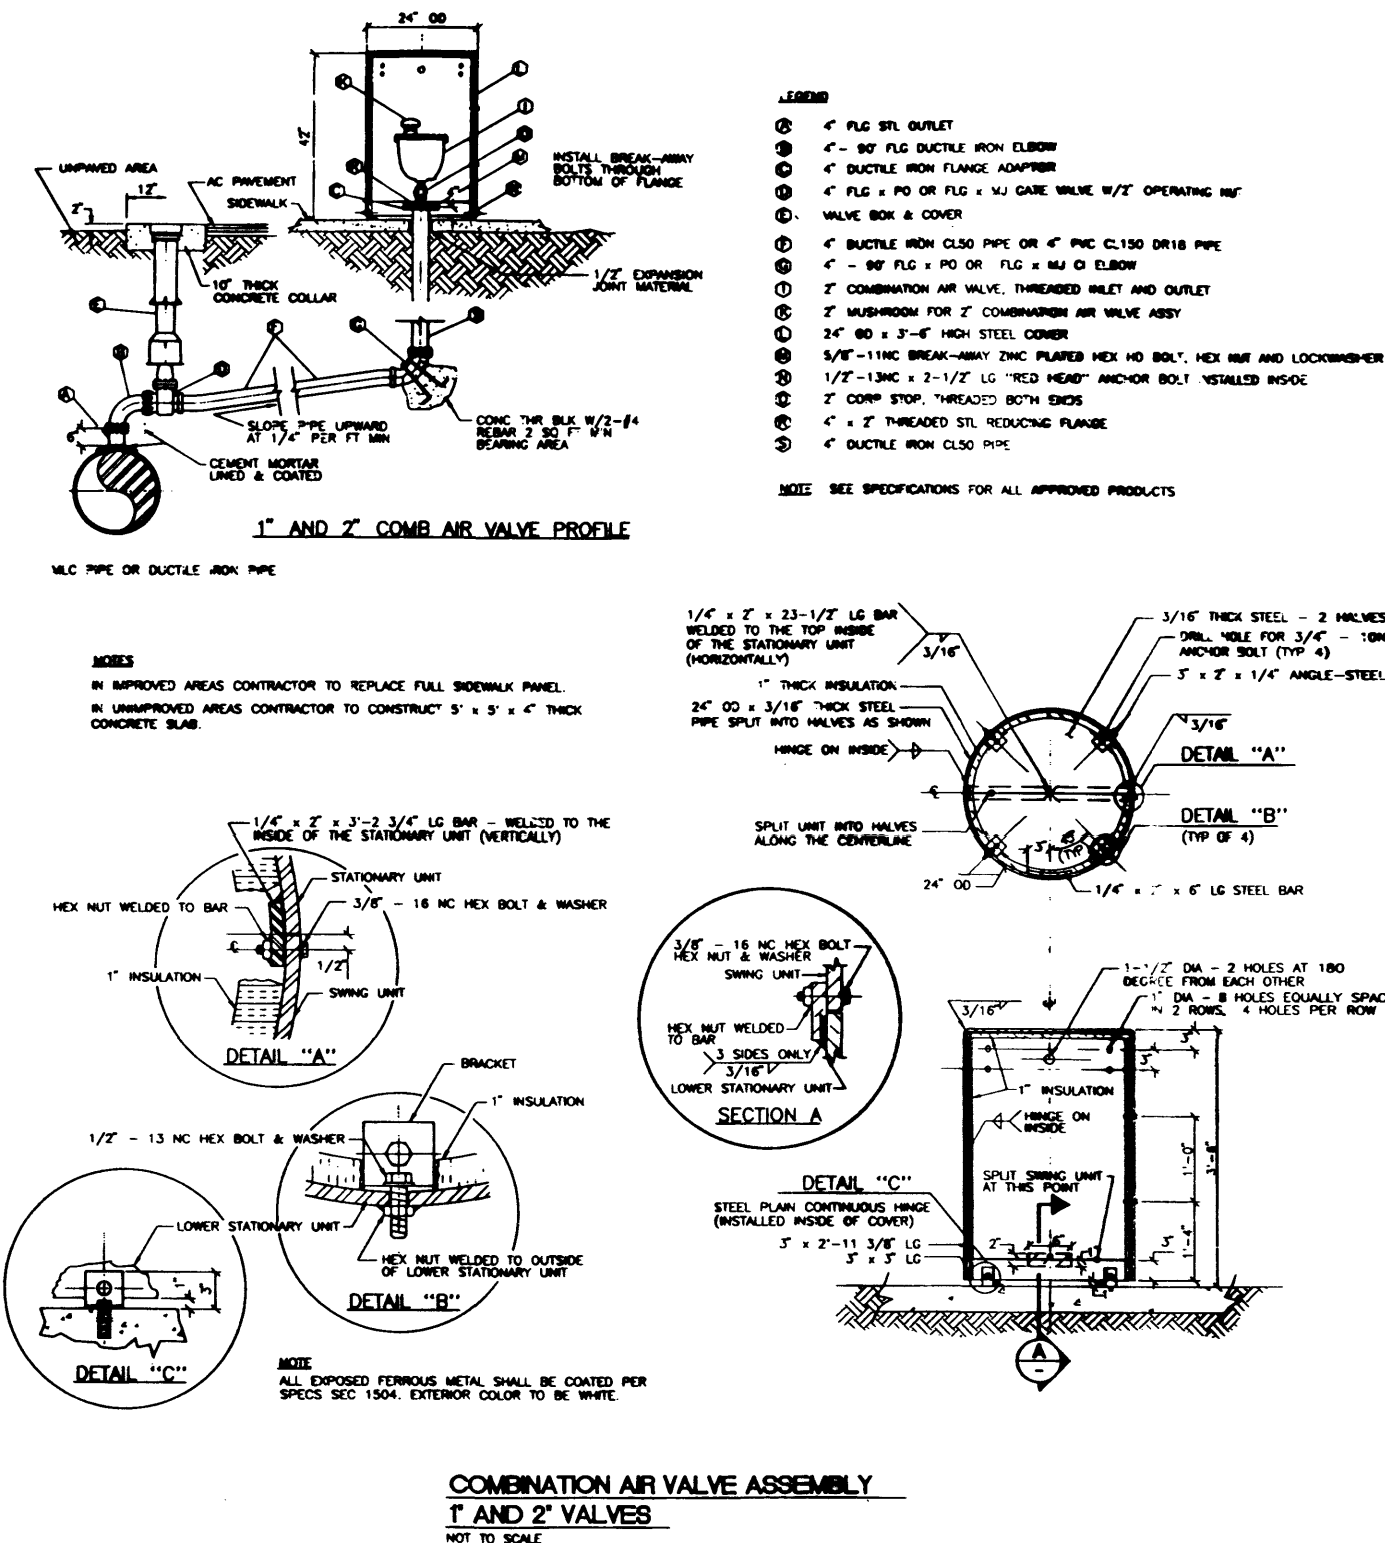

7-25-94 237-09-94	
ADD STUD LOCATION	NO. DESCRIPTION
RECOMMENDED: 5/19/96 DANIEL L. RUBIO, JR. E. E. # 8925	
DATE: 03/18/96	SCALE: AS SHOWN
DRAWN BY:	CHECKED BY:
DESIGNED BY:	JOB NO.: 0145.0025
PECCOLE NEVADA CORP.	PECCOLE WEST PHASE II
PLAN AND PROFILE - SAHARA AVENUE	
STA. 98+50 TO 92+50	
SHEET 12 OF 15	