


RECORD OF SURVEY MONUMENT TIE MAP

MONUMENT REPLACEMENT IN PORTIONS OF SECTION 27 AND THE SOUTH HALF OF SECTION 22,
TOWNSHIP 19 SOUTH, RANGE 60 EAST, M.D.M.
IN THE AREA OF TENAYA WAY / AZURE DRIVE IMPROVEMENTS.

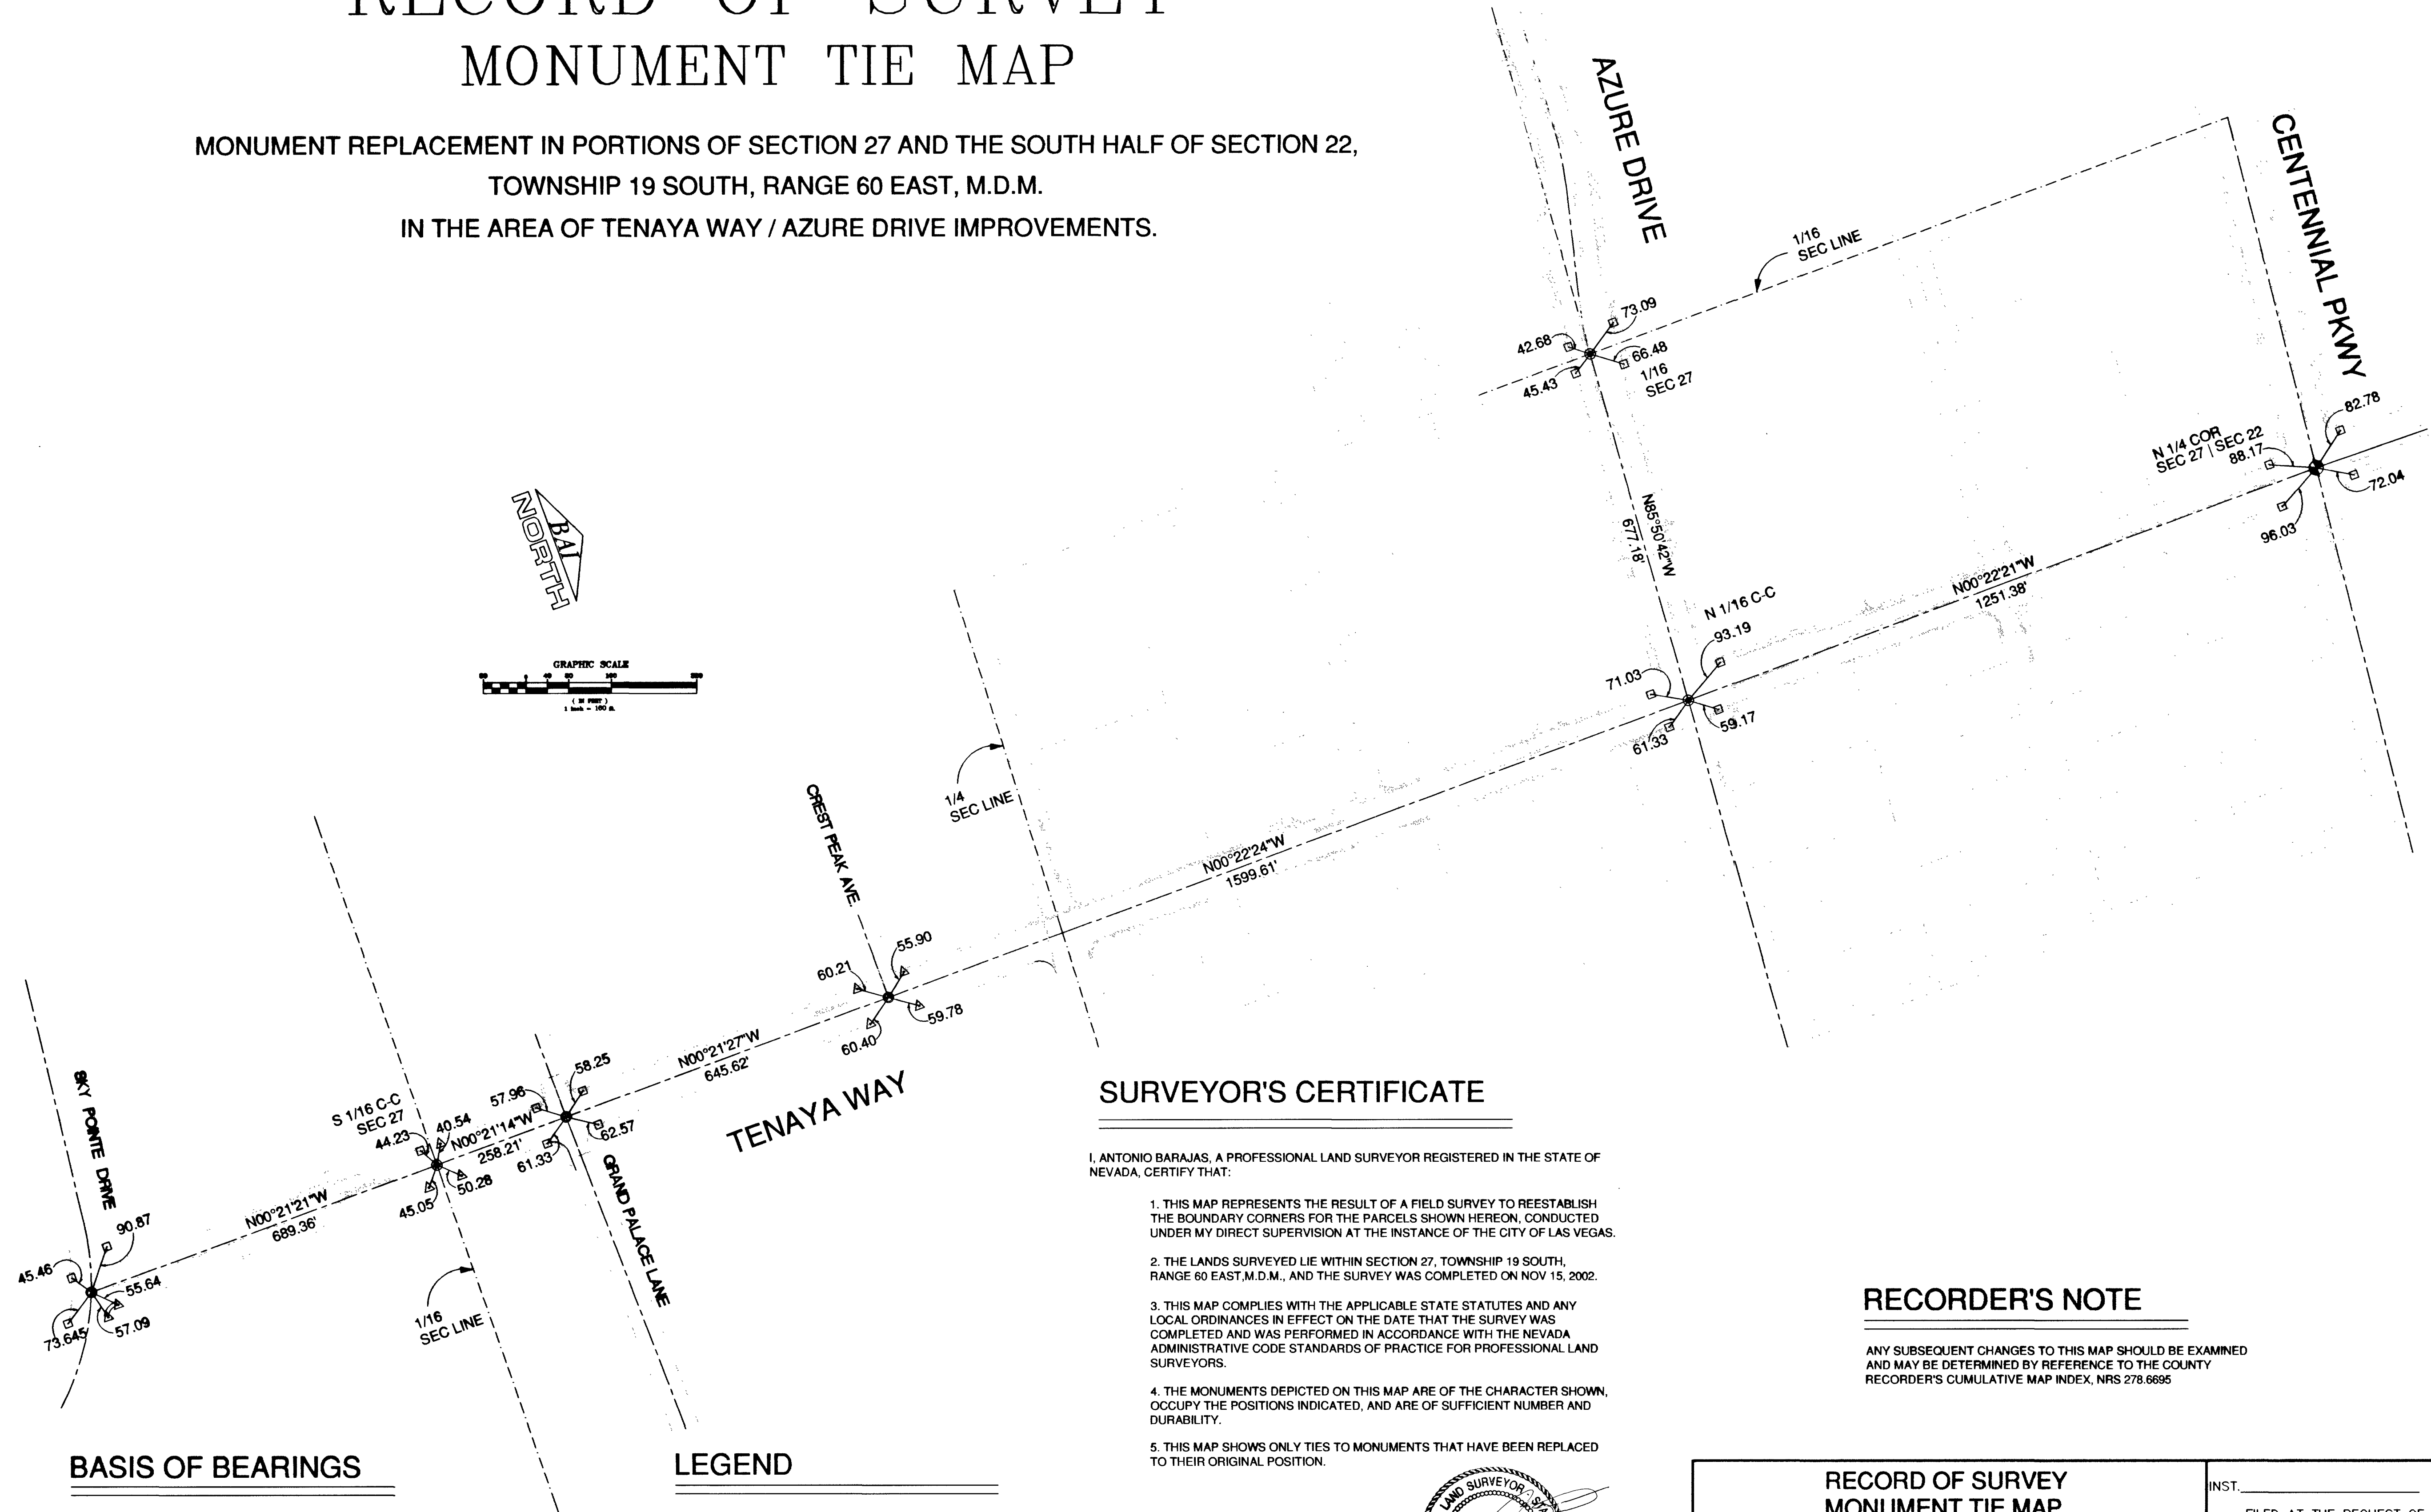

BASIS OF BEARINGS


NORTH AMERICAN DATUM - 1983 (NAD 83)
NEVADA COORDINATE SYSTEM - 1983 (NCS 83)
EAST ZONE (2701), MODIFIED AS SHOWN BY A MAP ON
FILE IN THE OFFICE OF THE COUNTY RECORDER,
CLARK COUNTY, NEVADA, IN FILE 89 OF RECORDS OF
SURVEYS, PAGE 3.

SURVEYORS NOTE:
NO ATTEMPT WAS MADE TO CORRECT POSITION OF MONUMENTS SET,
ONLY TO RESET MONUMENTS LOST DUE TO CONSTRUCTION IN THEIR
ORIGINAL POSITIONS.

LEGEND

- SET TYPE I MONUMENT, RLS 11585.
- SET TYPE II MONUMENT, RLS 11585.
- SET TYPE III MONUMENT, RLS 11585.
- SET TYPE IV TIE MONUMENT, RLS 11585.
- FOUND TYPE IV TIE MONUMENT.
- CENTERLINE.
- FRAC. SECTION LINE.

ANTONIO BARAJAS, PLS
NEVADA CERTIFICATE NO. 11585

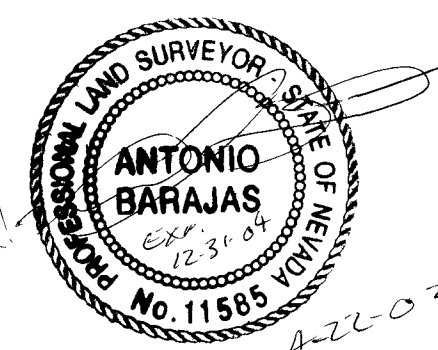

SHEET 1 OF 1

51671

055-700