

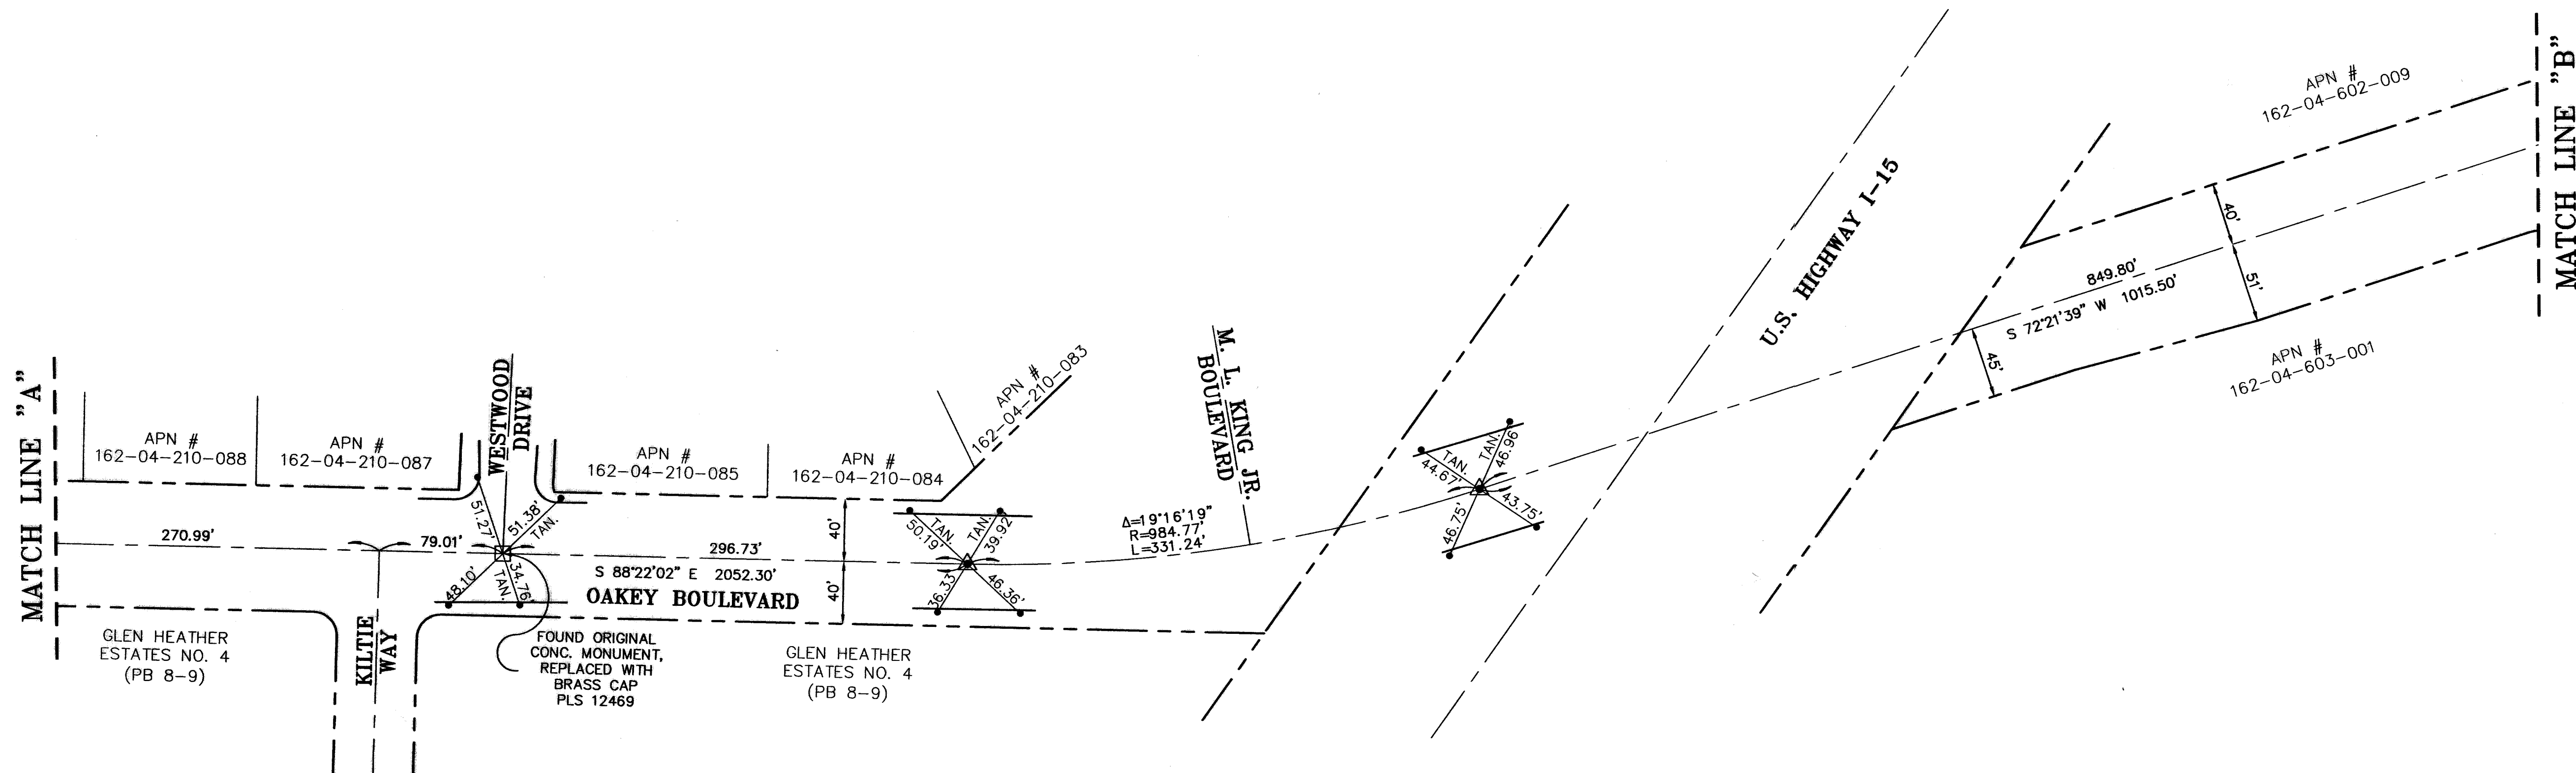


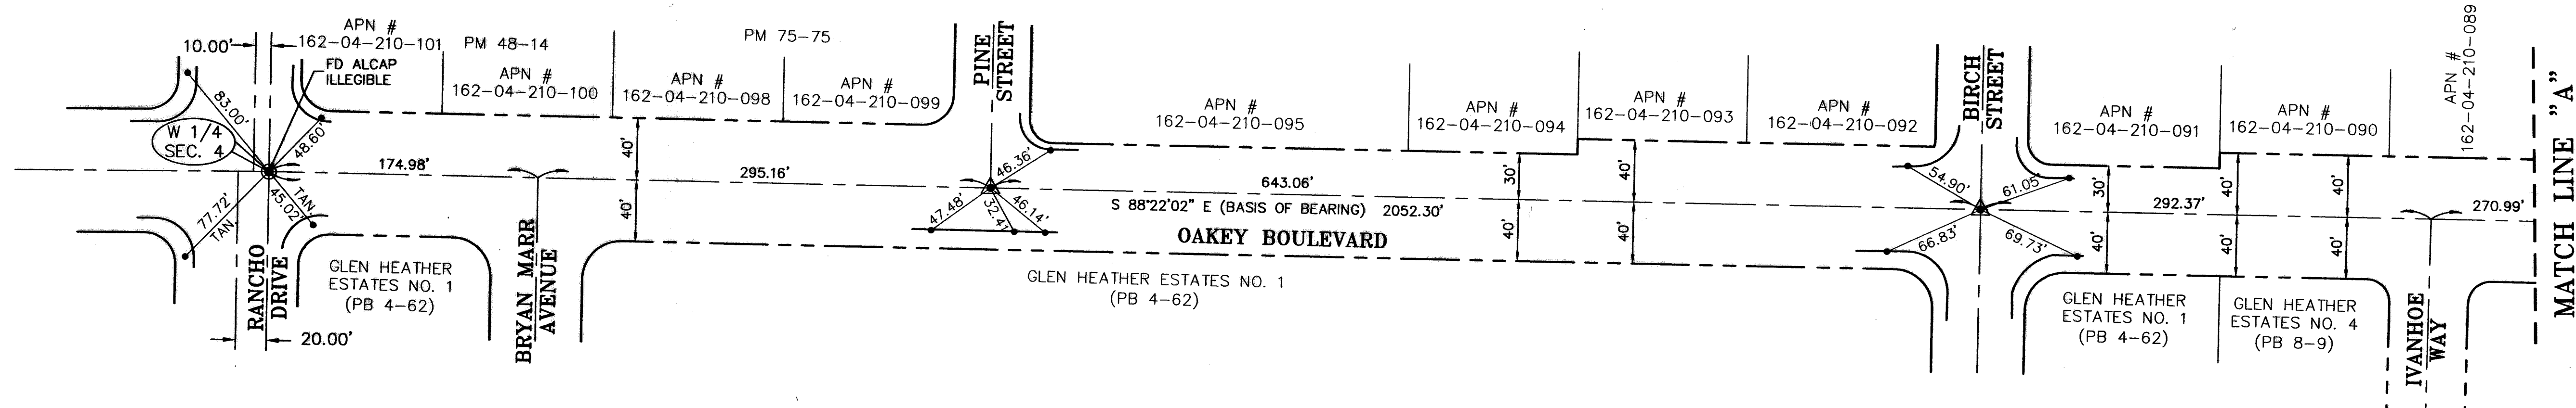

LEGEND

- FD MONUMENT AS NOTED
- SET BRASS CAP, PLS 12469
- ▲ SET 5/8" REBAR & ALCAP, PLS 12469 WITH REFERENCE MONUMENT
- REFERENCE MONUMENTS CLV BRASS CAP PLS 12469
- CENTERLINE
- - - RIGHT OF WAY LINE
- TAN. TANGENT
- APN ASSESSOR'S PARCEL NUMBER
- PB PLAT BOOK

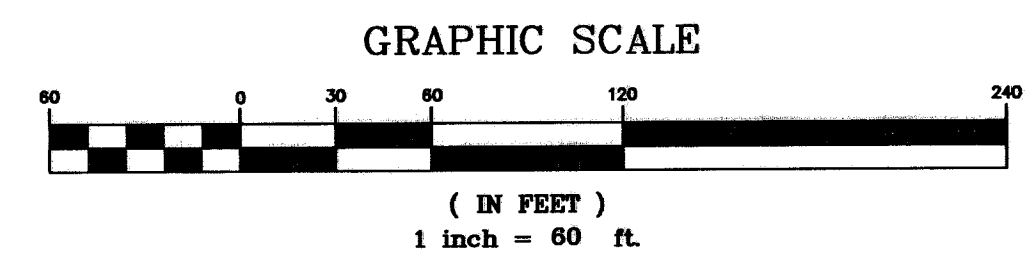

SHEET 2 OF 3

RECORD OF SURVEY CITY OF LAS VEGAS OAKLEY BLVD. & WYOMING AVE. PORTION OF SECTIONS 3 & 4, T. 21 S., R. 61 E., M.D.M. CITY OF LAS VEGAS, CLARK COUNTY, NEVADA	
	DRAWN BY: HJB
	CHECKED BY: ARR
	DATE: SEPTEMBER 29, 2004
	FILE NAME: WYOMING R-O-S.DWG
ADDRESS: 3001 RONEMUS DRIVE, LAS VEGAS, NV. 89128	

055-720