

ESTIMATE OF QUANTITIES

PUBLIC (DESERT INN ROAD ONLY)


4" AC PAVING	2300 SY
TYPE II AGGREGATE	300 CY
TYPE I AGGREGATE	600 CY
EARTHWORK (FILL)	500 CY
VALLEY GUTTER	340 SF

24" "L" TYPE CURB & GUTTER	600 LF
FIRE HYDRANTS	2 EA.

PRIVATE (SEE SHT. 2/5)

2" AC PAVING	2700 SY
TYPE II AGGREGATE	380 CY
TYPE I AGGREGATE	550 CY
EARTHWORK	600 CY
4" CONCRETE SIDEWALK	2250 SF
24" "L" TYPE CURB & GUTTER	1600 LF
FIRE HYDRANT	1 EA.

NOT A PART


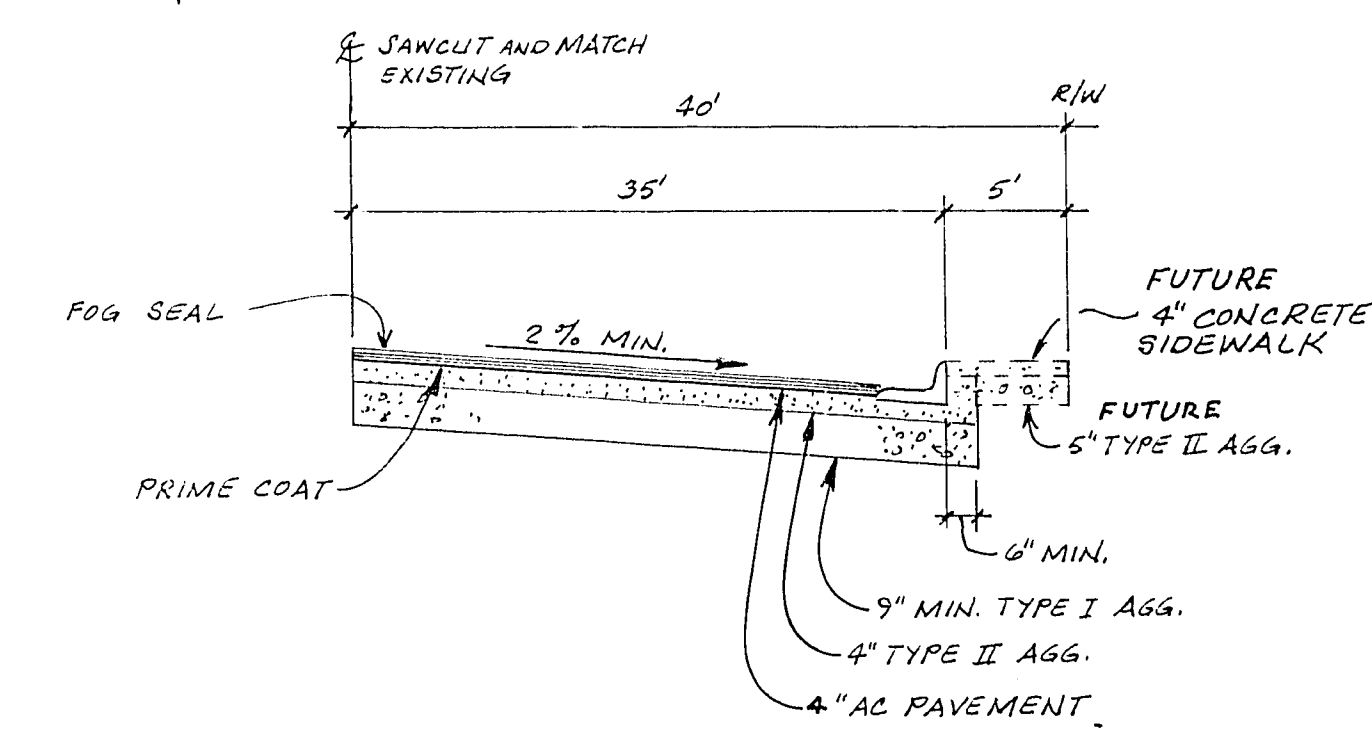


TYPICAL STREET SECTION

NOT TO SCALE

LEGEND

- ⊙ GATE VALVE
- SEWER MANHOLE
- ⊕ FIRE HYDRANT
- W- EXISTING WATER MAIN
- W- NEW WATER MAIN
- S- EXISTING SEWER MAIN
- S- NEW SEWER MAIN
- G- EXISTING GAS MAIN
- EXFL EXISTING FLOWLINE
- FL FLOWLINE
- 35- EXISTING CONTOUR
- EXISTING LIGHT STANDARD
- T- TELEPHONE LINES (EXISTING)

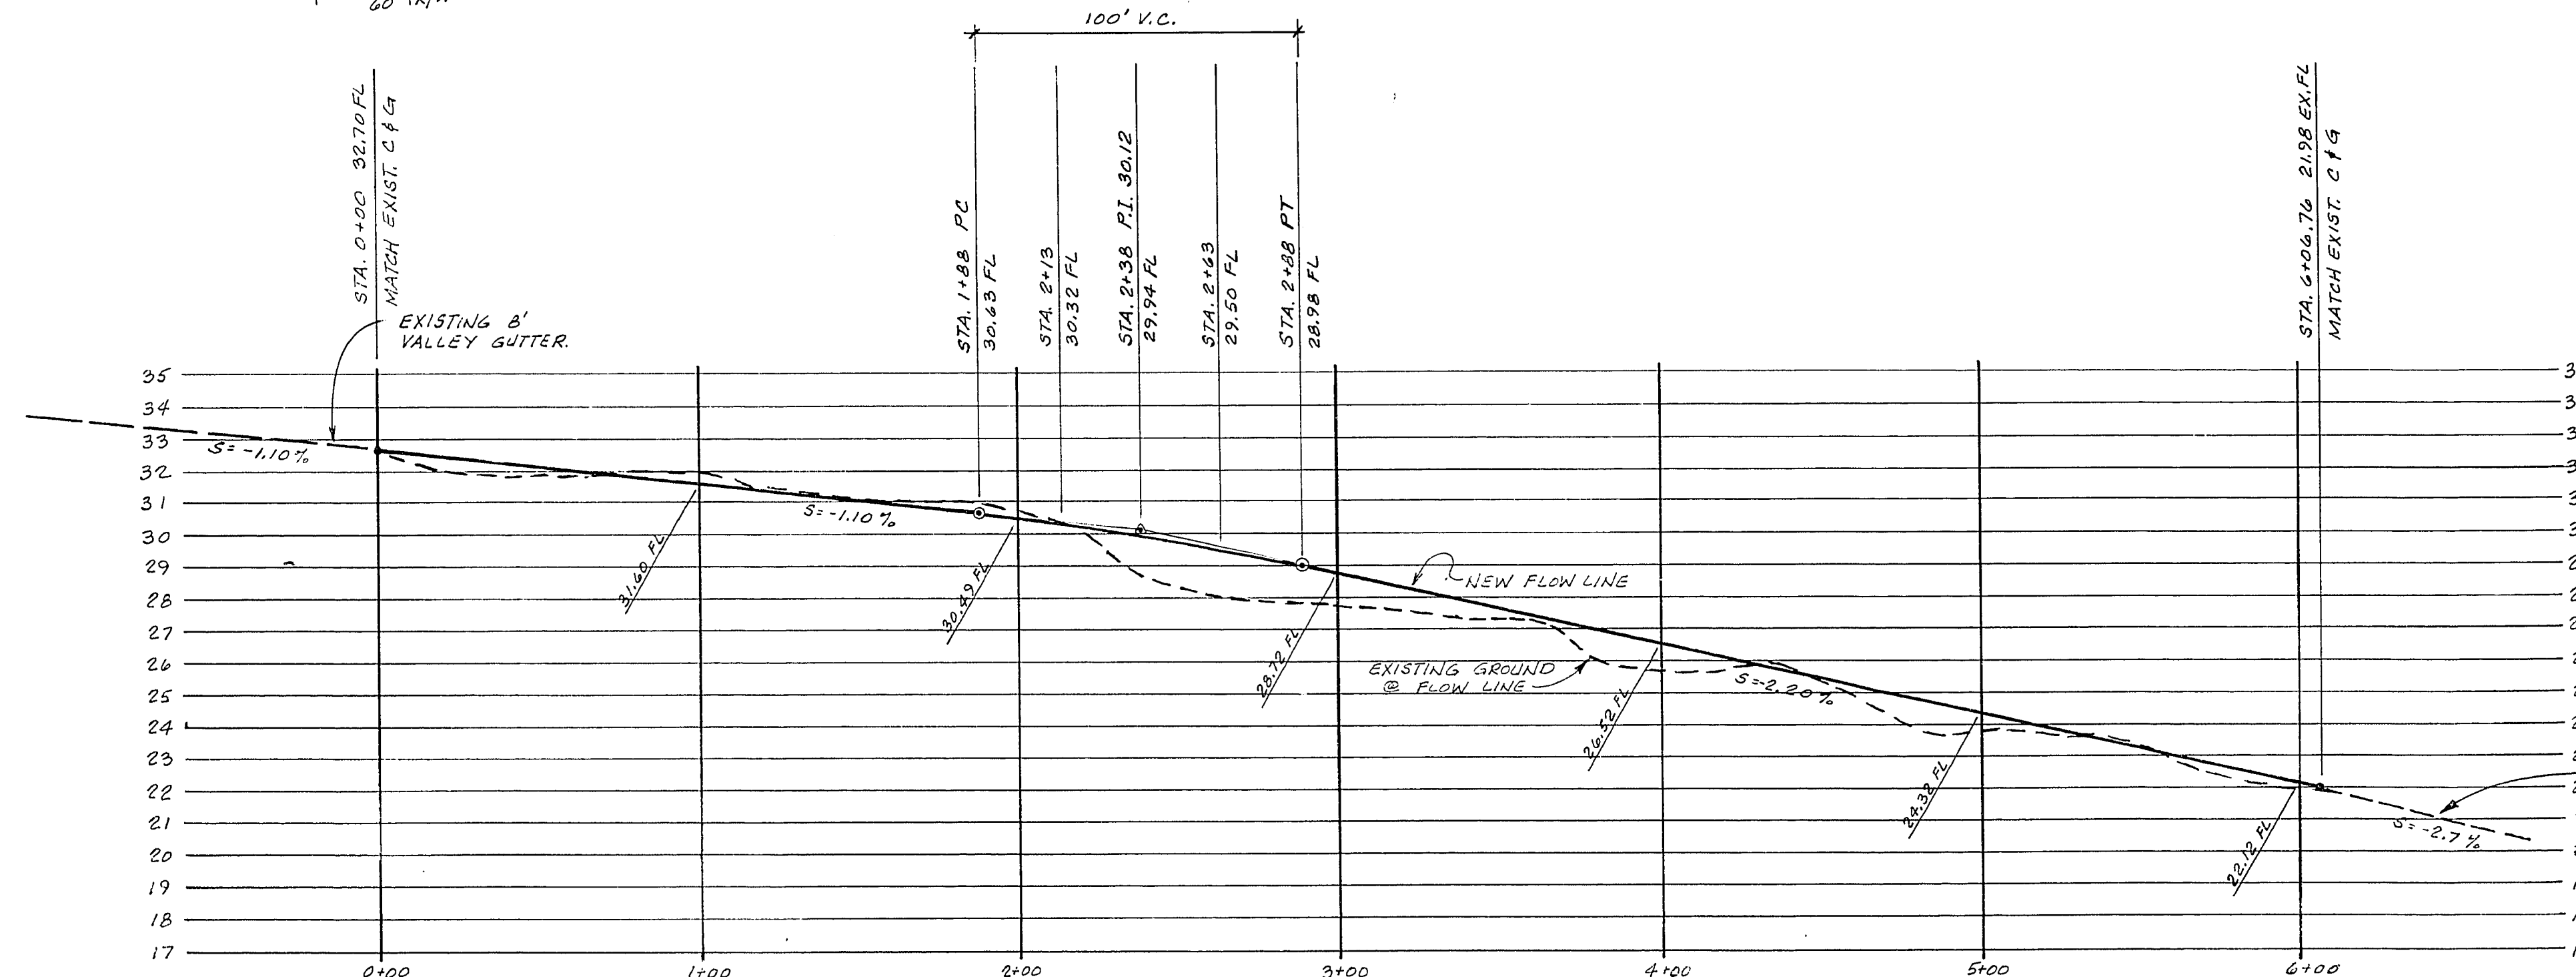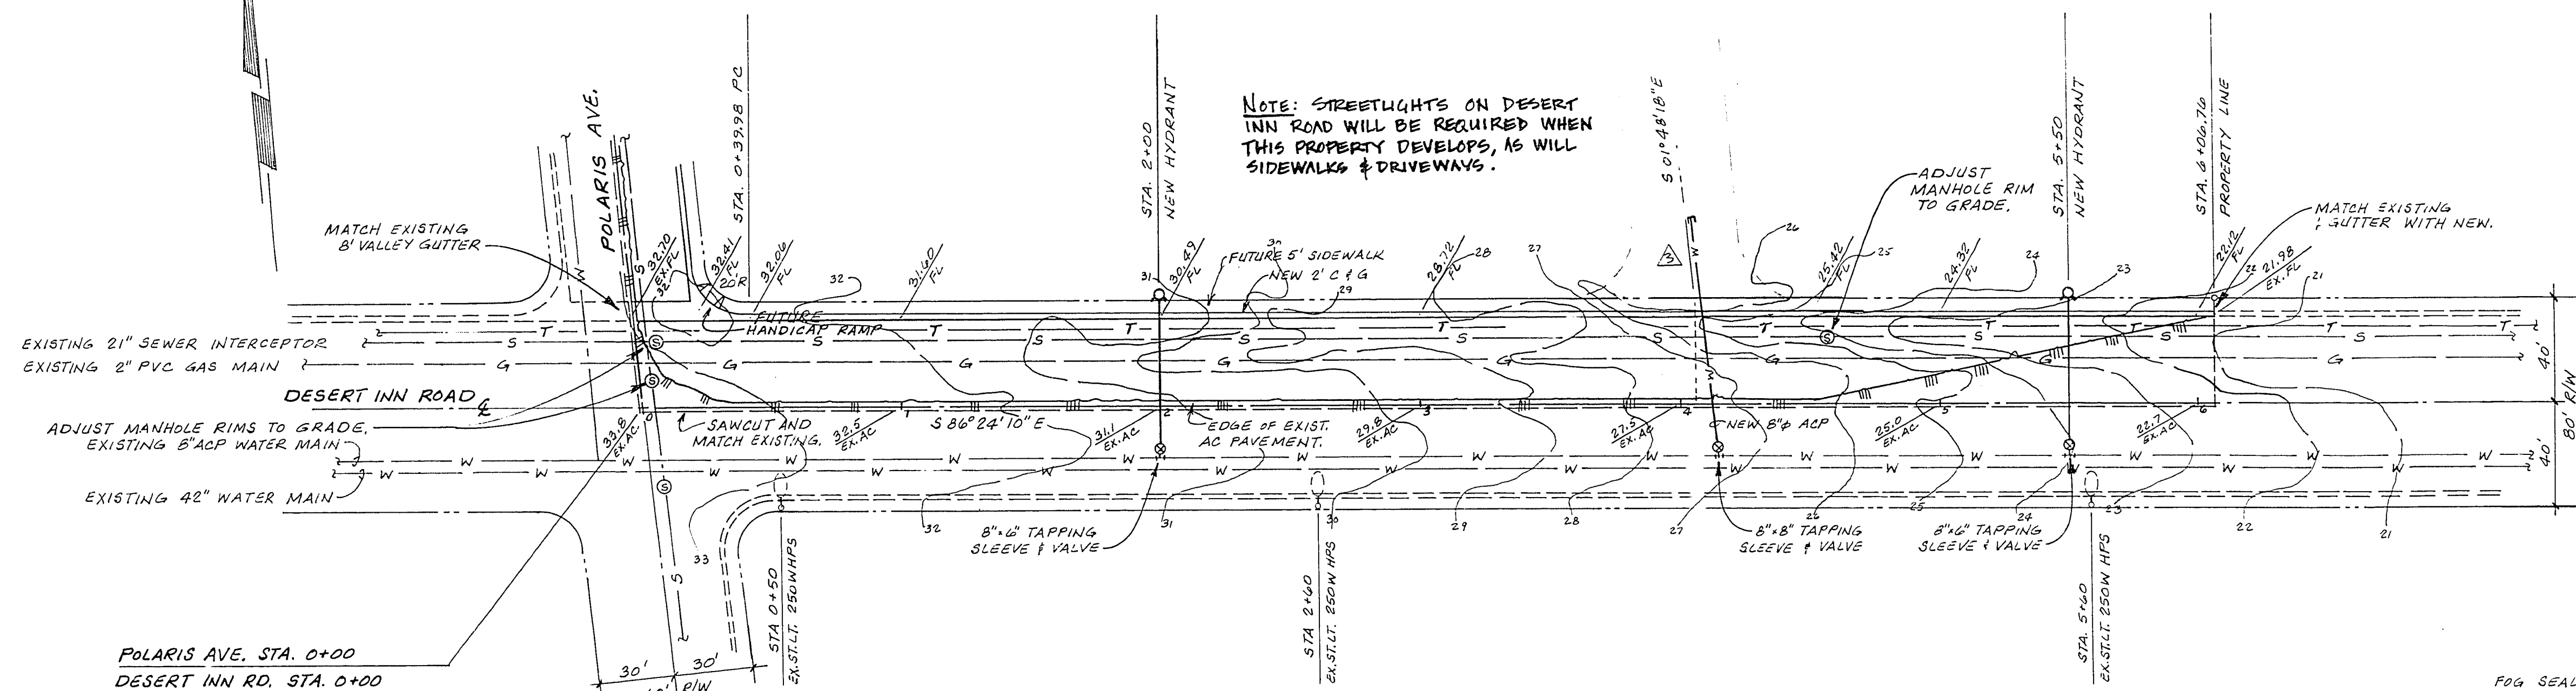

FLOWLINE PROFILE

SCALE: HORIZ.: 1"=40' VERT.: 1"=4'

APP'D ON SHEET #1
LAND DEVELOPMENT

DATE

3/10/87

1"=40' 0 40 80 120

Revised	Description	Submit	Appr'd	Date
1	OWNERS NAME	BDH	BDH	11-1-80
2	DELETE ON SITE IMPROVEMENTS	BDH	BDH	11-1-80
3	REV. PROJ. NAME PER ARCH.	B.P. WALSH	B.P. WALSH	6/1/87
4	REVISED PER CLV COMMENTS.	B.P. WALSH	B.P. WALSH	4/10/87

Refer to Tracing for Latest Revision

Reference Information and Notes:

Designed
B.P. WALSH
Drawn
D.M.
Checked
B.P. WALSH
Date
FEBRUARY 1987

LEWEX, INC.

Kennedy/Jenks/Chilton

Las Vegas, Nevada

Submitted:

Approved:

POLARIS BUSINESS CENTER
DESERT INN ROAD ~ PLAN & PROFILE

CITY OF LAS VEGAS

NEVADA

Scale
1"=40'
Job No.
879007.00-C-00
Sheet
87003

of 5 of 5

107-V1474

4-3-80