



REVISIONS	BY
1/27/87	RLK

KRAEMER ENGINEERING CO., INC.
3355 SO. HIGHLAND DRIVE, SUITE NO. 102
LAS VEGAS, NEVADA 89109
TELEPHONE NO. (702) 732-0517

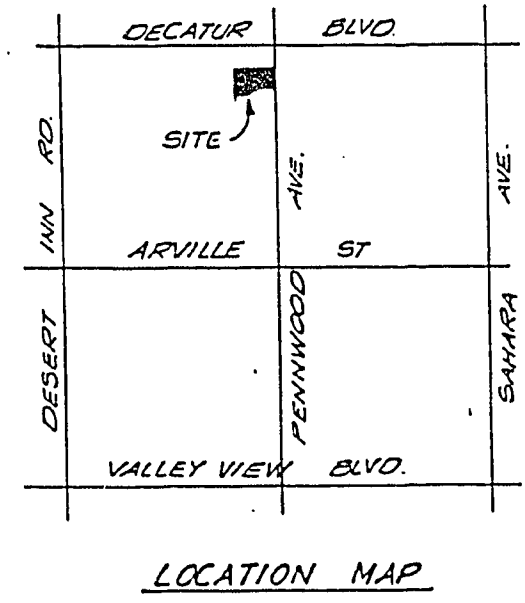

PENNWOOD AVE.


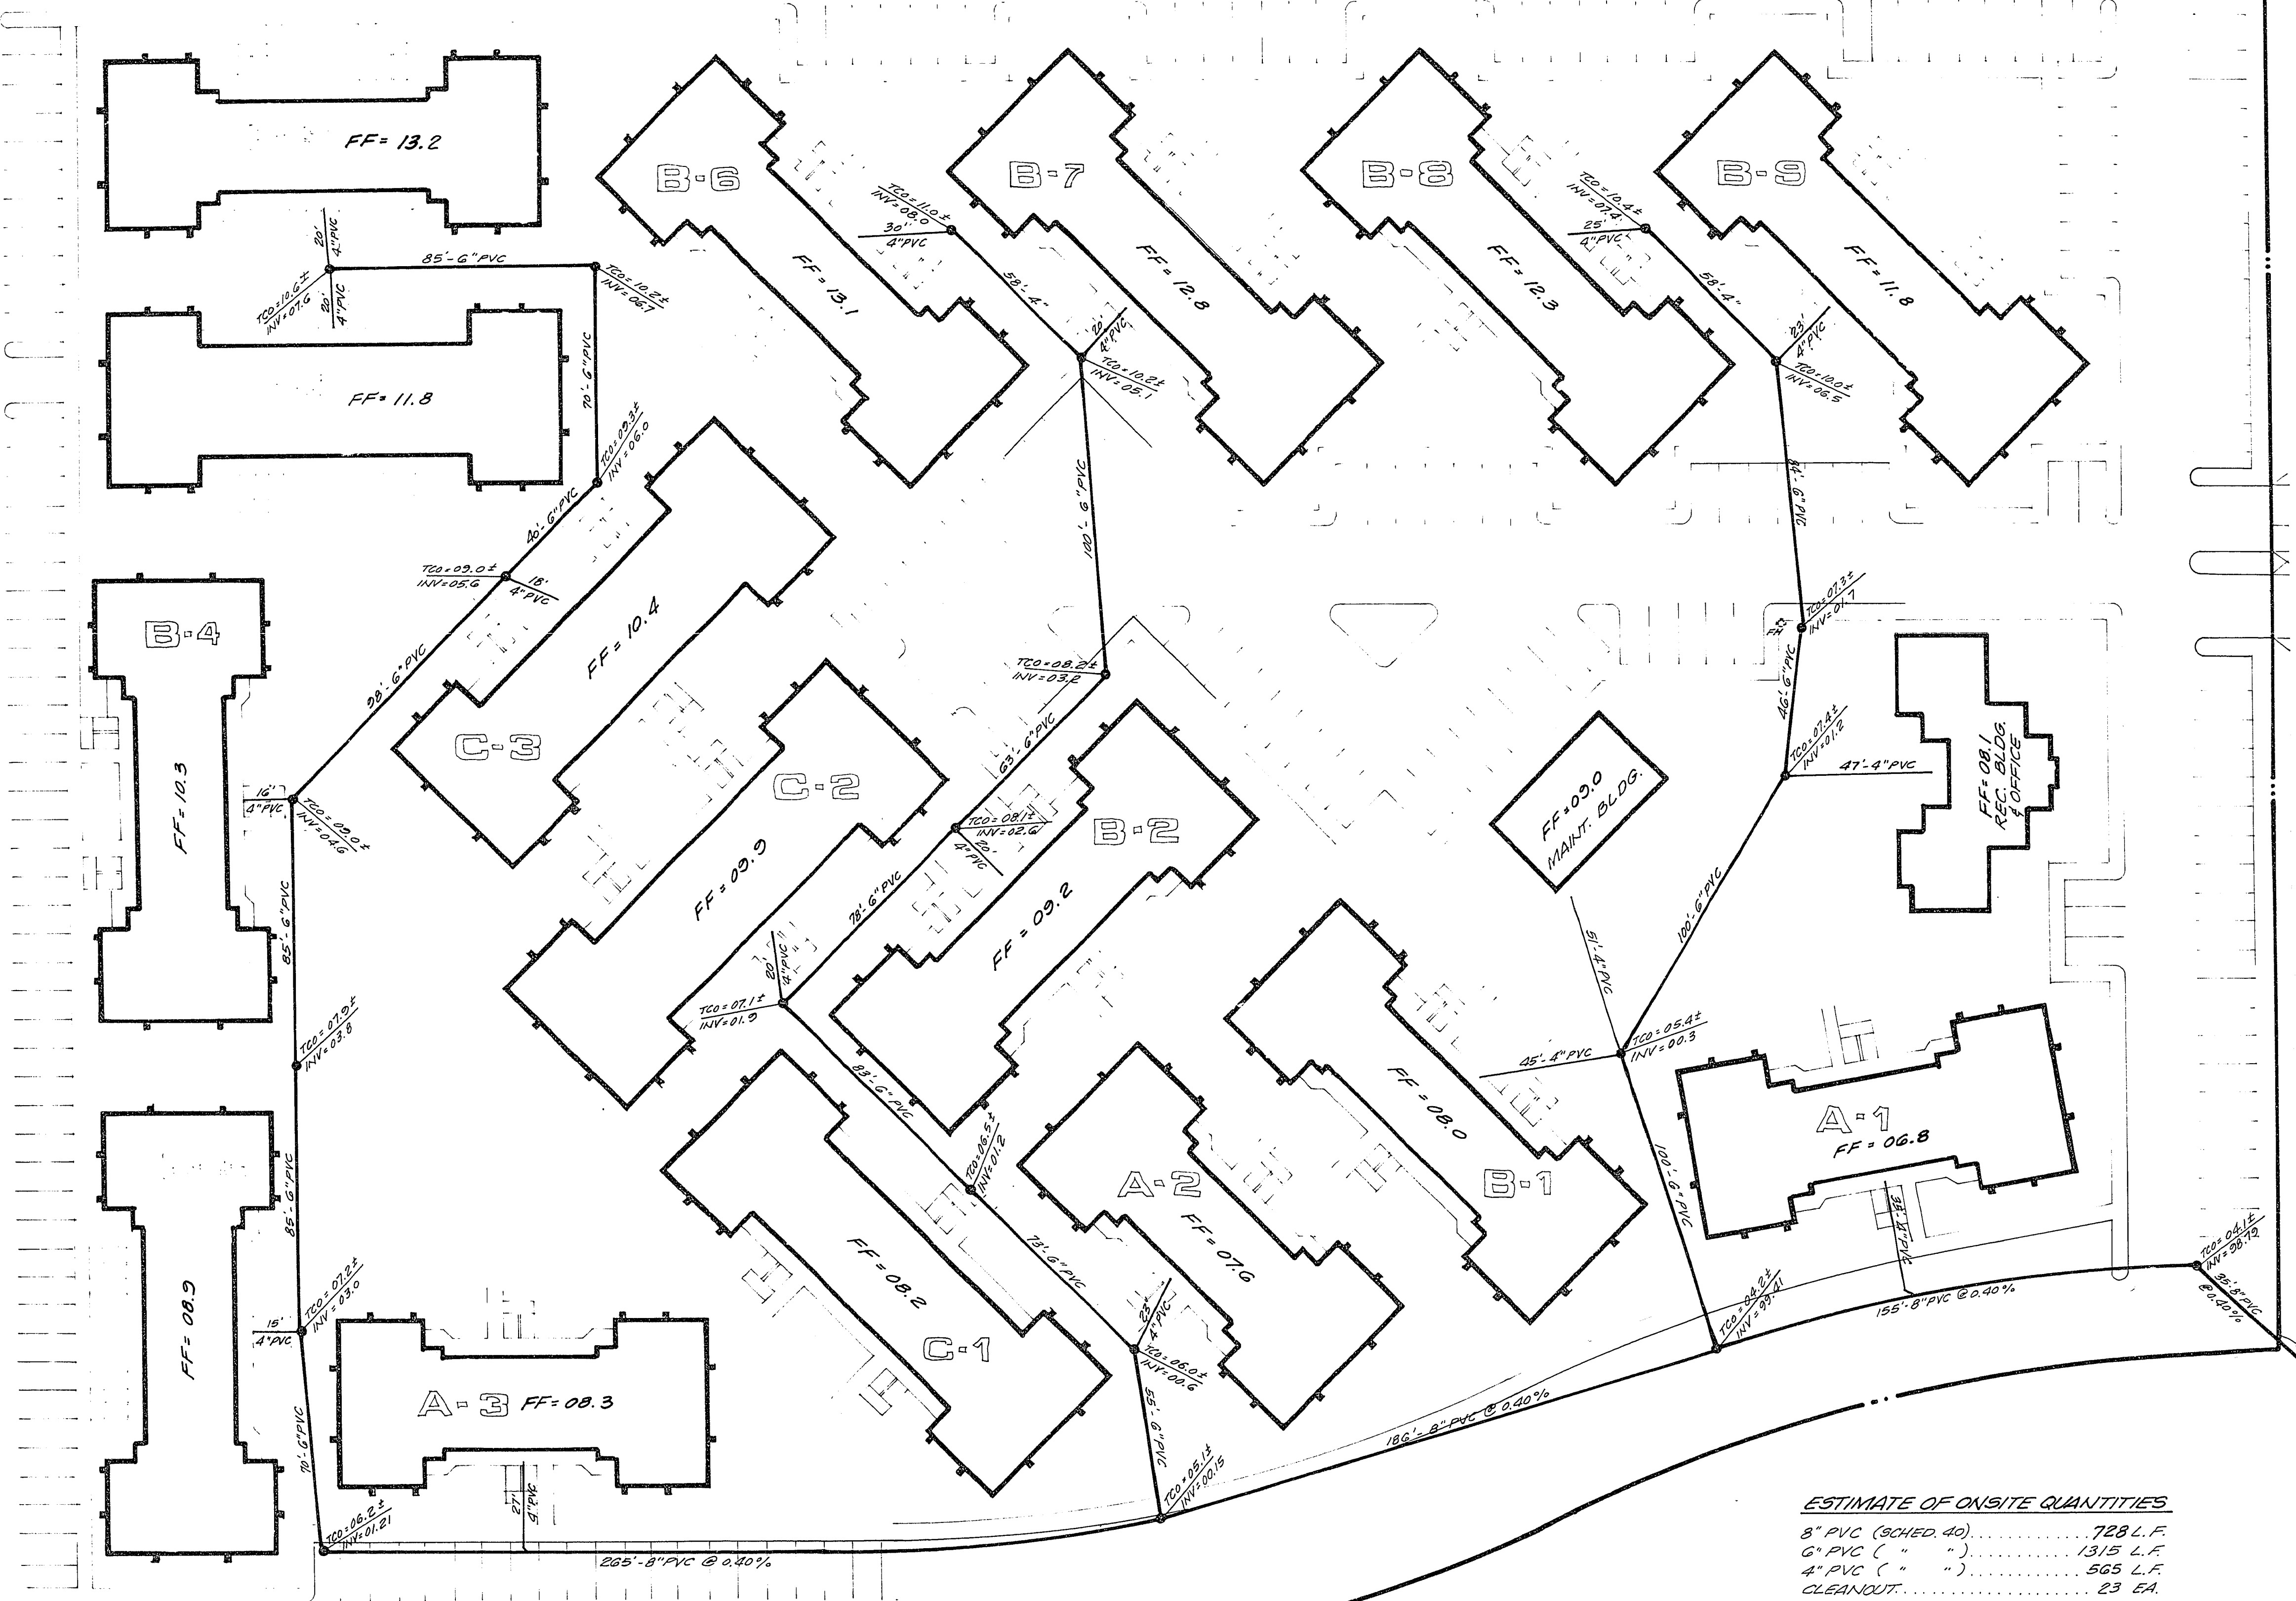


ESTIMATE OF ONSITE QUANTITIES

8" PVC (SCHED. 40)	728 L.F.
6" PVC (" ")	1315 L.F.
4" PVC (" ")	565 L.F.
CLEANOUT	23 EA.
NUMBER OF UNITS	218 EA.

NOTES
1. ALL LABOR & MATERIALS TO BE IN STRICT ACCORDANCE WITH C.L.V. STANDARDS AS WELL AS THE UNIFORM BUILDING AND PLUMBING CODES.

PRIVATE SEWER - TO BE MAINTAINED BY OWNER OUT TO CITY MAIN

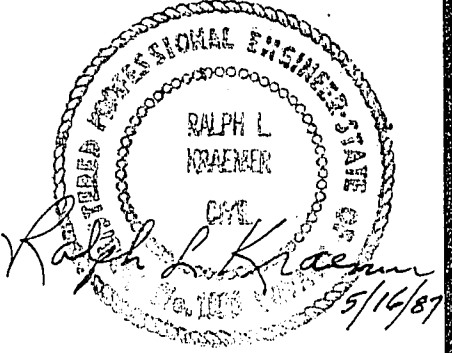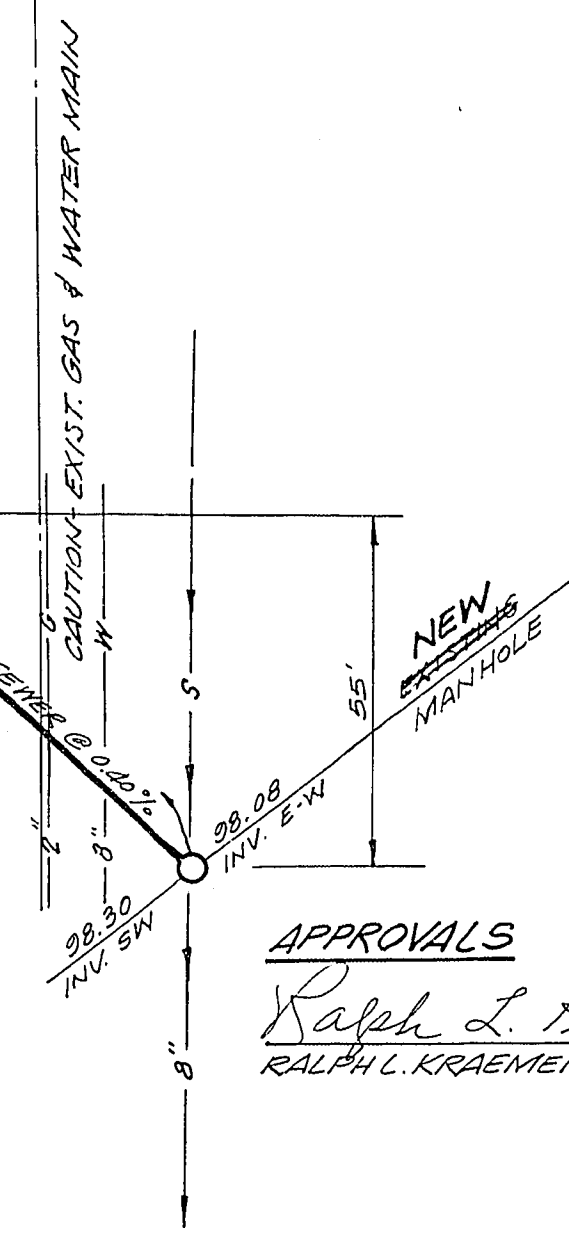

APPROVALS
Ralph L. Kraemer
RALPH L. KRAEMER
10/31/86
DATE

PENNWOOD APARTMENTS

SEWER PLAN

Date	10/31/86
Scale	1" = 30'
Drawn	JB - RK
Job	KE 1031
Sheet	2
Of 4 Sheets	

4.3-57 107-V1487