

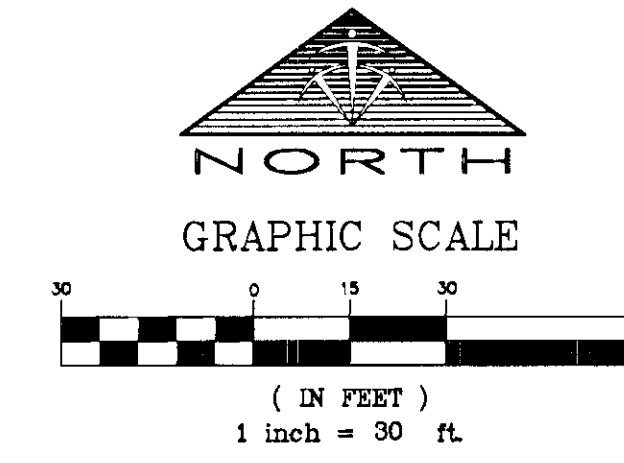
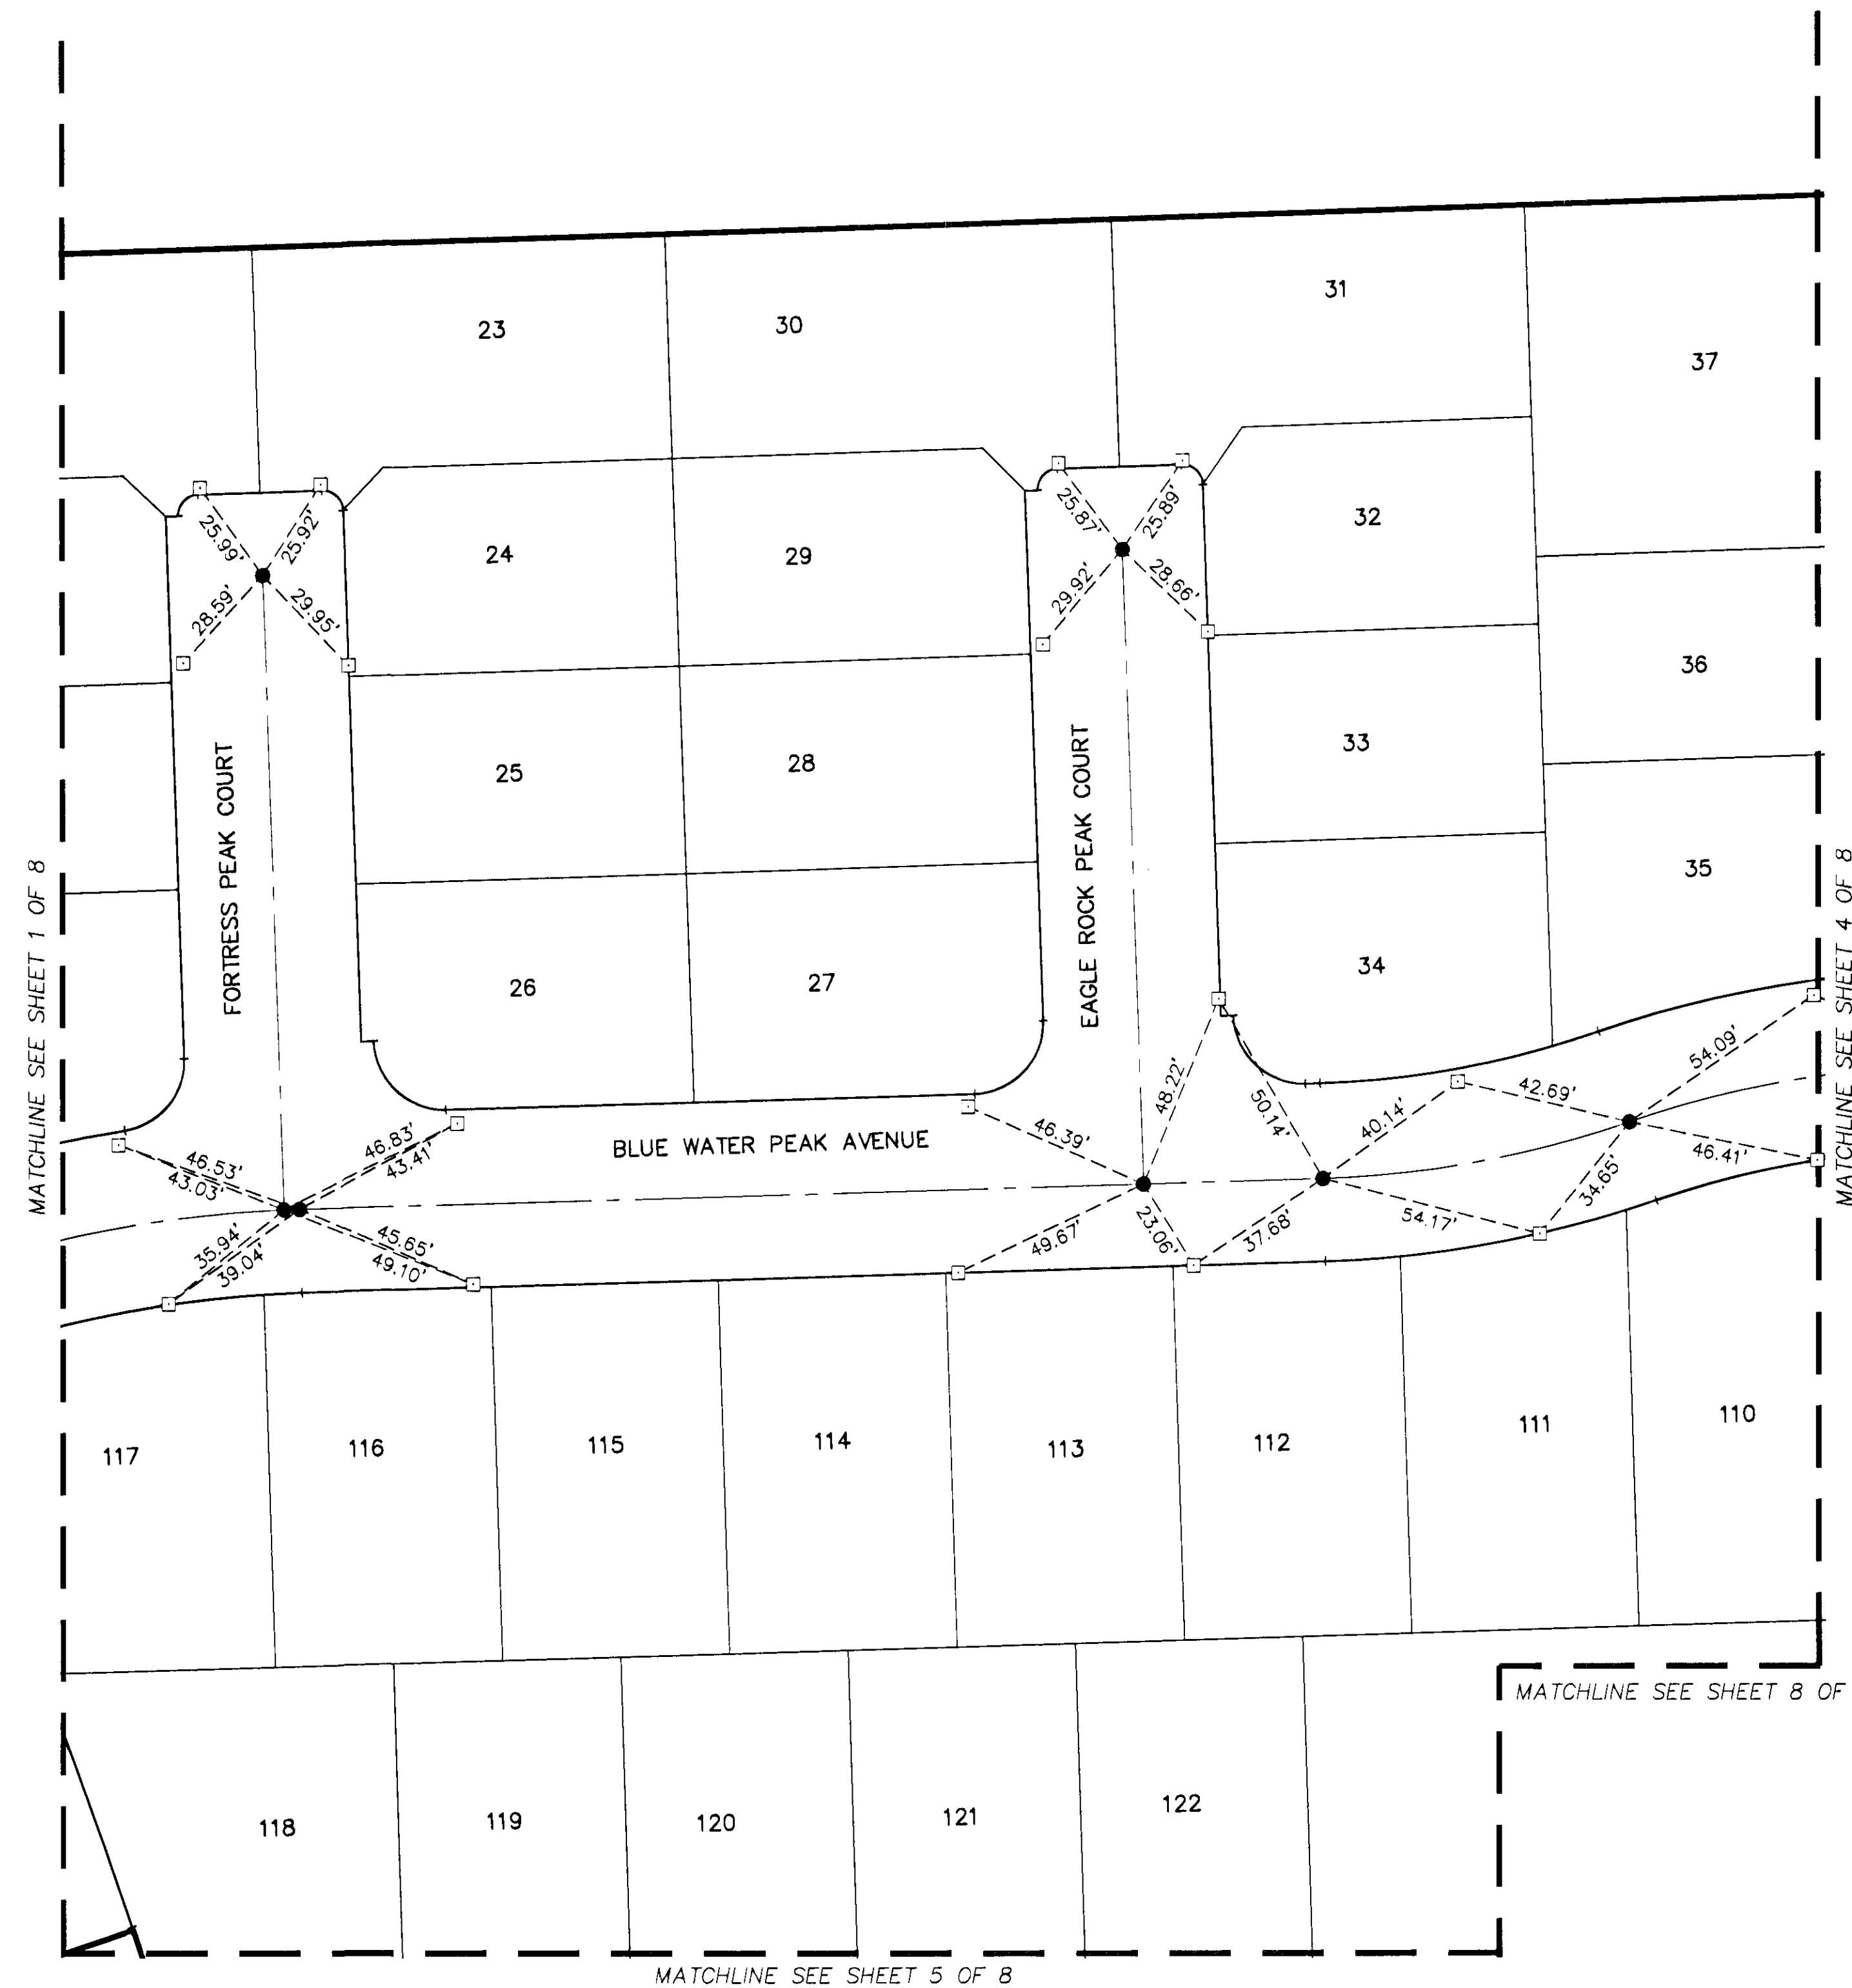


# MONUMENT TIE MAP OF PODS 106 AND 109 AT PROVIDENCE MODELS & UNIT 1

AS SHOWN ON THOSE CERTAIN MAPS ON FILE IN THE CLARK COUNTY RECORDER'S OFFICE IN BOOK 133, PAGE 58 OF PLATS & BOOK 135, PAGE 28 OF PLATS, SITUATE IN THE NORTHEAST QUARTER (NE1/4) OF SECTION 13, TOWNSHIP 19 SOUTH, RANGE 59 EAST, M.D.M., CITY OF LAS VEGAS, CLARK COUNTY, NEVADA

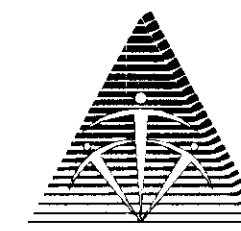

- LEGEND**
- SUBDIVISION BOUNDARY LINE
  - - - ALIQUOT PART LINE
  - - - ASSESSOR'S PARCEL LINE
  - LOT LINE
  - RIGHT-OF-WAY LINE/  
LIMITS OF PRIVATE STREET
  - - - STREET CENTERLINE
  - - - MATCHLINE
  - N.A.P. NOT A PART
  - FOUND MONUMENT AS DESCRIBED
  - SET TYPE III MONUMENT  
STAMPED "PLS 17449"
  - SET TYPE IV-A MONUMENT  
STAMPED "PLS 17449"
  - 1 LOT NUMBER

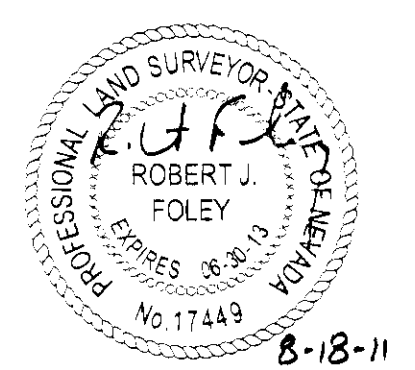

8-18-11  
058-4930-1  
**TRI-CORE**  
SURVEYING, LLC  
6781 WEST CHARLESTON BLVD.  
LAS VEGAS, NEVADA 89148  
TEL. (702) 321-1554 FAX (702) 870-4378

127917  
JOB# 16007.0009