MONUMENT TIE MAP OF

PODS 106 AND 109 AT PROVIDENCE MODELS & UNIT 1

AS SHOWN ON THOSE CERTAIN MAPS ON FILE IN THE CLARK COUNTY RECORDER'S OFFICE IN BOOK 133, PAGE 58 OF PLATS & BOOK 135, PAGE 28 OF PLATS, SITUATE IN THE NORTHEAST QUARTER (NE1/4) OF SECTION 13, TOWNSHIP 19 SOUTH, RANGE 59 EAST, M.D.M., CITY OF LAS VEGAS, CLARK COUNTY, NEVADA

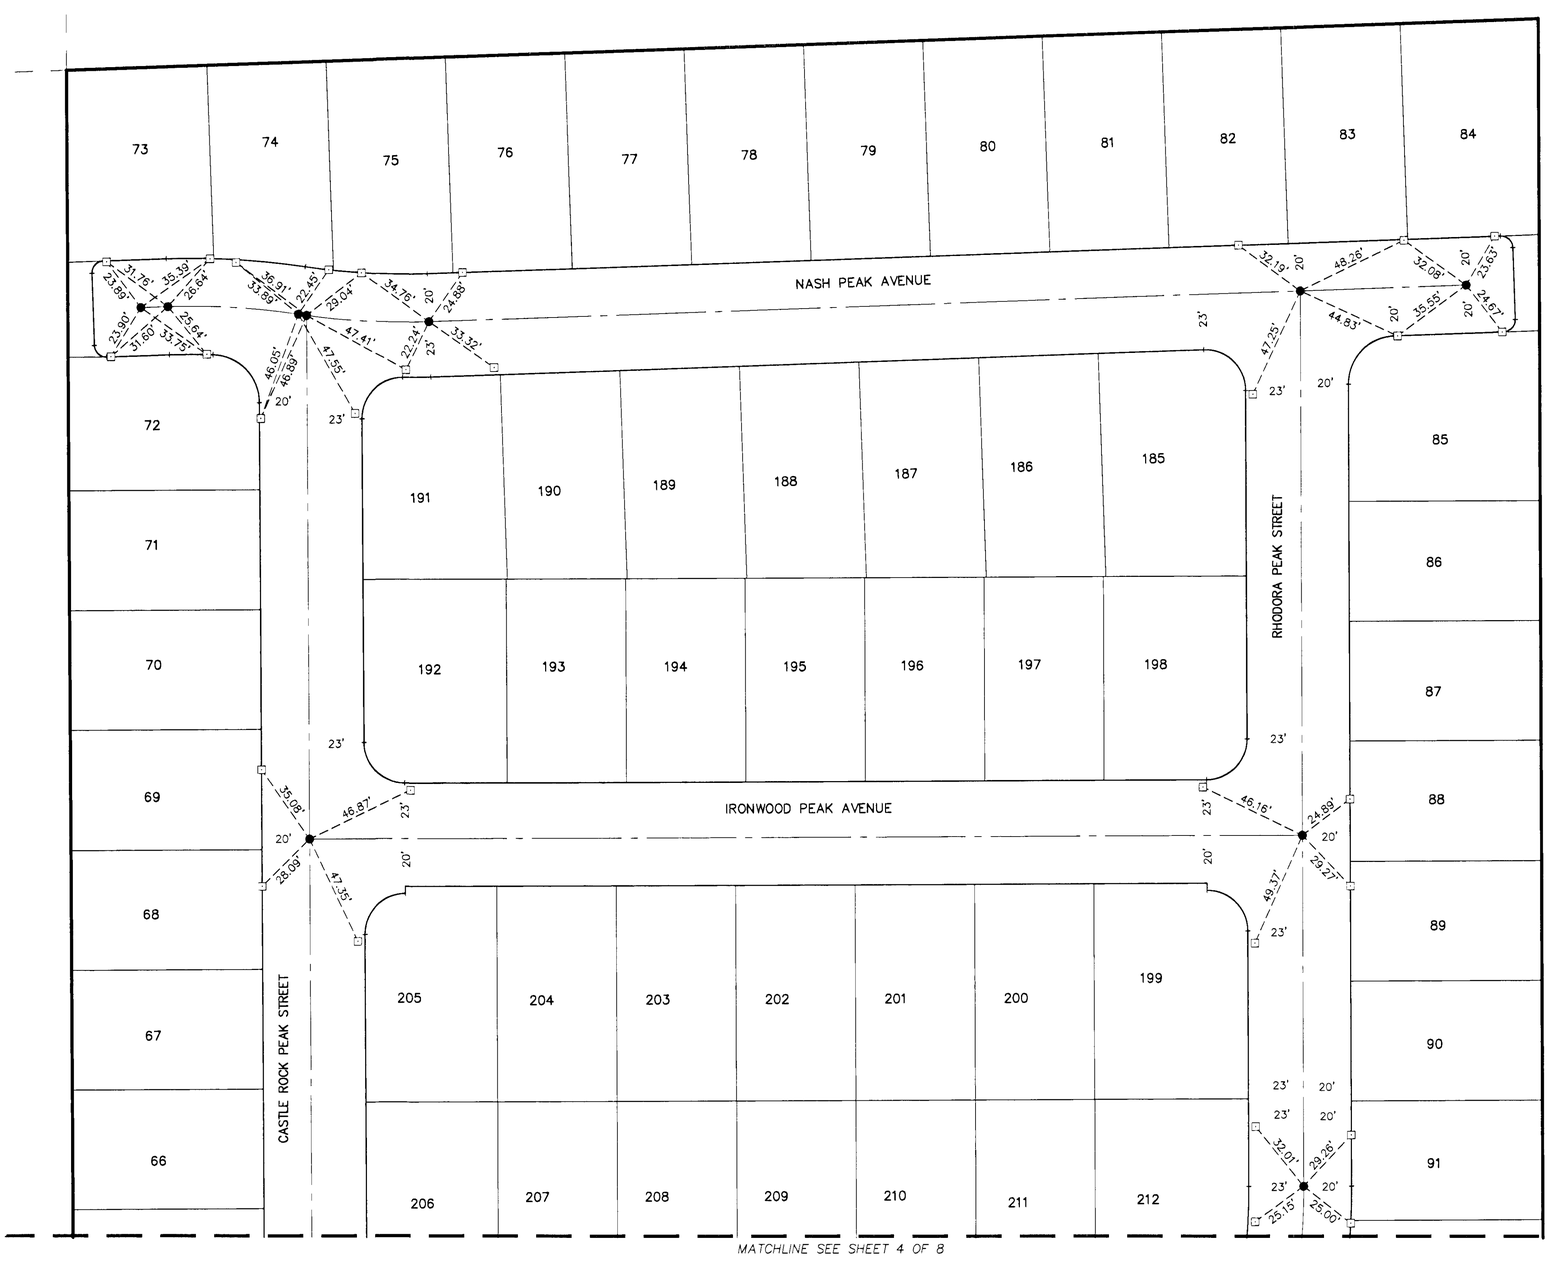

LEGEND

- SUBDIVISION BOUNDARY LINE
- ALIQUOT PART LINE
- ASSESSOR'S PARCEL LINE
- LOT LINE
- RIGHT-OF-WAY LINE/ LIMITS OF PRIVATE STREET
- STREET CENTERLINE
- MATCHLINE
- N.A.P. NOT A PART
- FOUND MONUMENT AS DESCRIBED
- SET TYPE III MONUMENT STAMPED "PLS 17449"
- SET TYPE IV-A MONUMENT STAMPED "PLS 17449"
- 1 LOT NUMBER

PROFESSIONAL LAND SURVEYOR STATE OF NEVADA ROBERT J. FOLEY No. 17449 EXPIRES 15-30-13

8-18-11

058-4930-1

TRI-CORE SURVEYING, LLC
6761 WEST CHARLESTON BLVD.
LAS VEGAS, NEVADA 89146
TEL. (702) 821-1554 FAX (702) 870-4378

127918

JOB# 16007.0009