
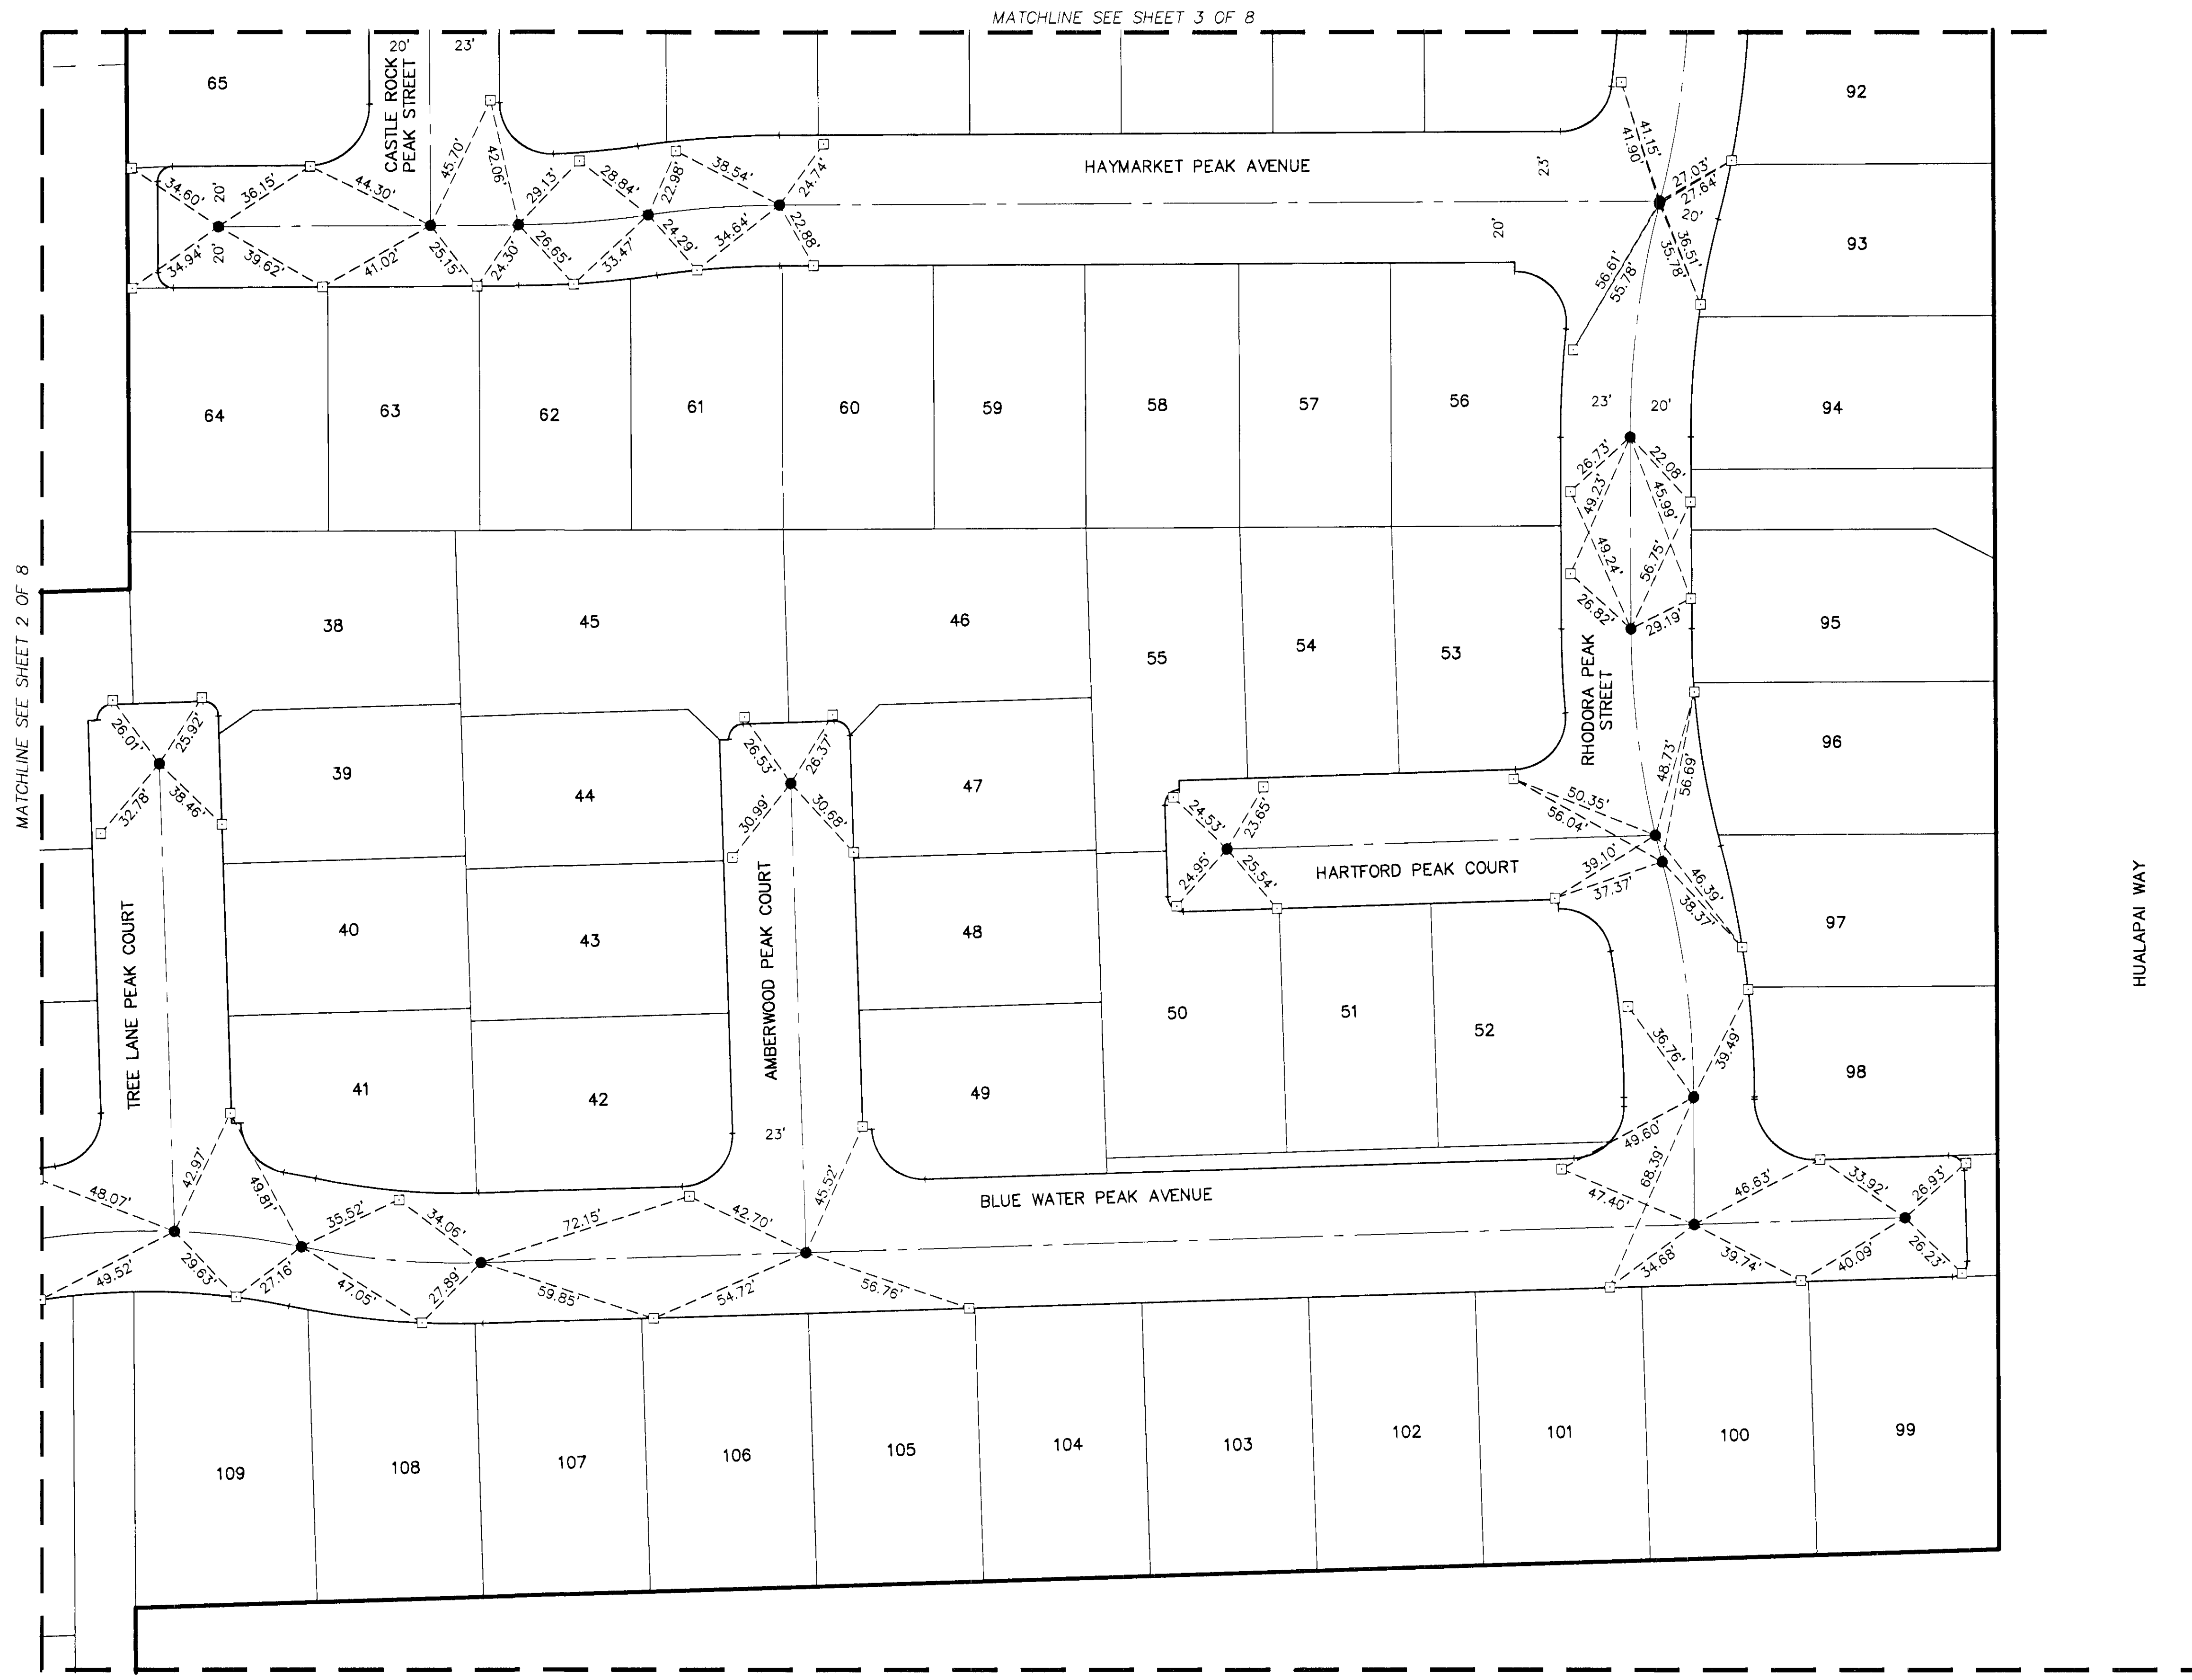



MONUMENT TIE MAP OF PODS 106 AND 109 AT PROVIDENCE MODELS & UNIT 1

AS SHOWN ON THOSE CERTAIN MAPS ON FILE IN THE CLARK COUNTY RECORDER'S OFFICE IN BOOK 133, PAGE 58 OF PLATS & BOOK 135, PAGE 28 OF PLATS, SITUATE IN THE NORTHEAST QUARTER (NE1/4) OF SECTION 13, TOWNSHIP 19 SOUTH, RANGE 59 EAST, M.D.M., CITY OF LAS VEGAS, CLARK COUNTY, NEVADA

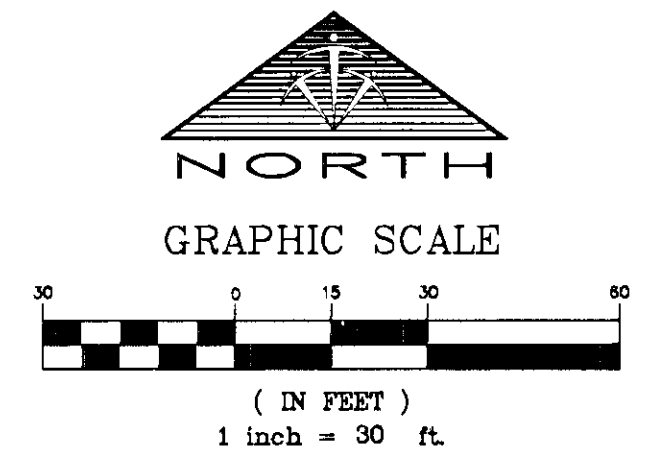


N 1/16
13 18

FOUND BRASS CAP
IN CONCRETE
STAMPED "PLS 11449"

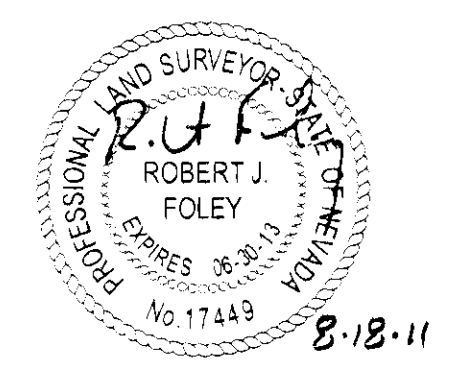

058-4930-1
TRI-CORE
SURVEYING, LLC
6751 WEST CHARLESTON BLVD.
LAS VEGAS, NEVADA 89146
TEL. (702) 821-1554 FAX (702) 870-4378

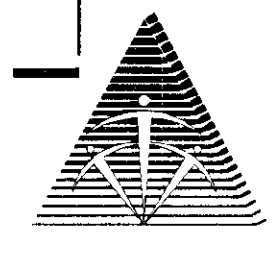

127919
JOB# 16007.0009

MATCHLINE SEE SHEET 8 OF 8