



MONUMENT TIE MAP OF PODS 106 AND 109 AT PROVIDENCE MODELS & UNIT 1

AS SHOWN ON THOSE CERTAIN MAPS ON FILE IN THE CLARK COUNTY RECORDER'S OFFICE IN BOOK 133, PAGE 58 OF PLATS & BOOK 135, PAGE 28 OF PLATS,
SITUATE IN THE NORTHEAST QUARTER (NE1/4) OF SECTION 13, TOWNSHIP 19 SOUTH, RANGE 59 EAST, M.D.M., CITY OF LAS VEGAS, CLARK COUNTY, NEVADA

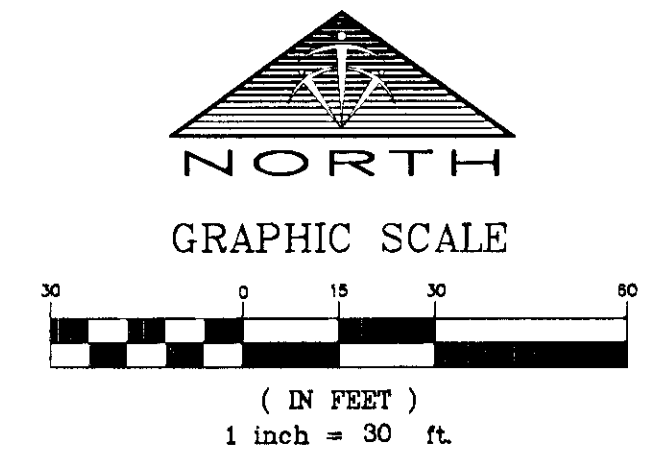


LEGEND

	SUBDIVISION BOUNDARY LINE
	ALIQUOT PART LINE
	ASSESSOR'S PARCEL LINE
	LOT LINE
	RIGHT-OF-WAY LINE/ LIMITS OF PRIVATE STREET
	STREET CENTERLINE
	MATCHLINE
N.A.P.	NOT A PART
	FOUND MONUMENT AS DESCRIBED
	SET TYPE III MONUMENT STAMPED "PLS 17449"
	SET TYPE IV-A MONUMENT STAMPED "PLS 17449"
1	LOT NUMBER

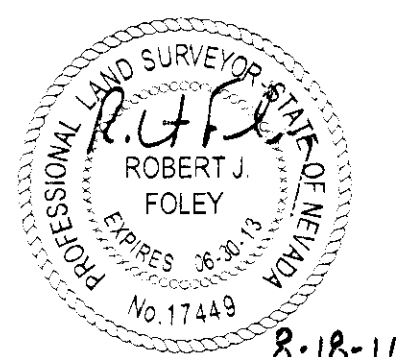

8-18-11

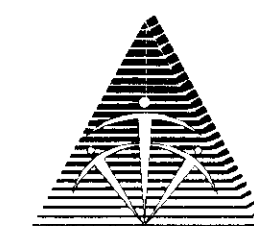

058-492-1
TRI-CORE
SURVEYING, LLC

6781 WEST CHARLESTON BLVD.
LAS VEGAS, NEVADA 89146
TEL. (702) 821-1554 FAX (702) 870-4378

SHEET 5 OF 8