
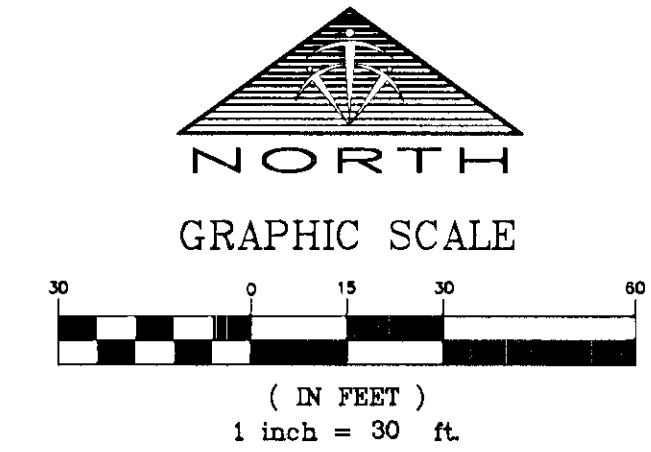




MONUMENT TIE MAP OF PODS 106 AND 109 AT PROVIDENCE MODELS & UNIT 1

AS SHOWN ON THOSE CERTAIN MAPS ON FILE IN THE CLARK COUNTY RECORDER'S OFFICE IN BOOK 133, PAGE 58 OF PLATS & BOOK 135, PAGE 28 OF PLATS, SITUATE IN THE NORTHEAST QUARTER (NE1/4) OF SECTION 13, TOWNSHIP 19 SOUTH, RANGE 59 EAST, M.D.M., CITY OF LAS VEGAS, CLARK COUNTY, NEVADA

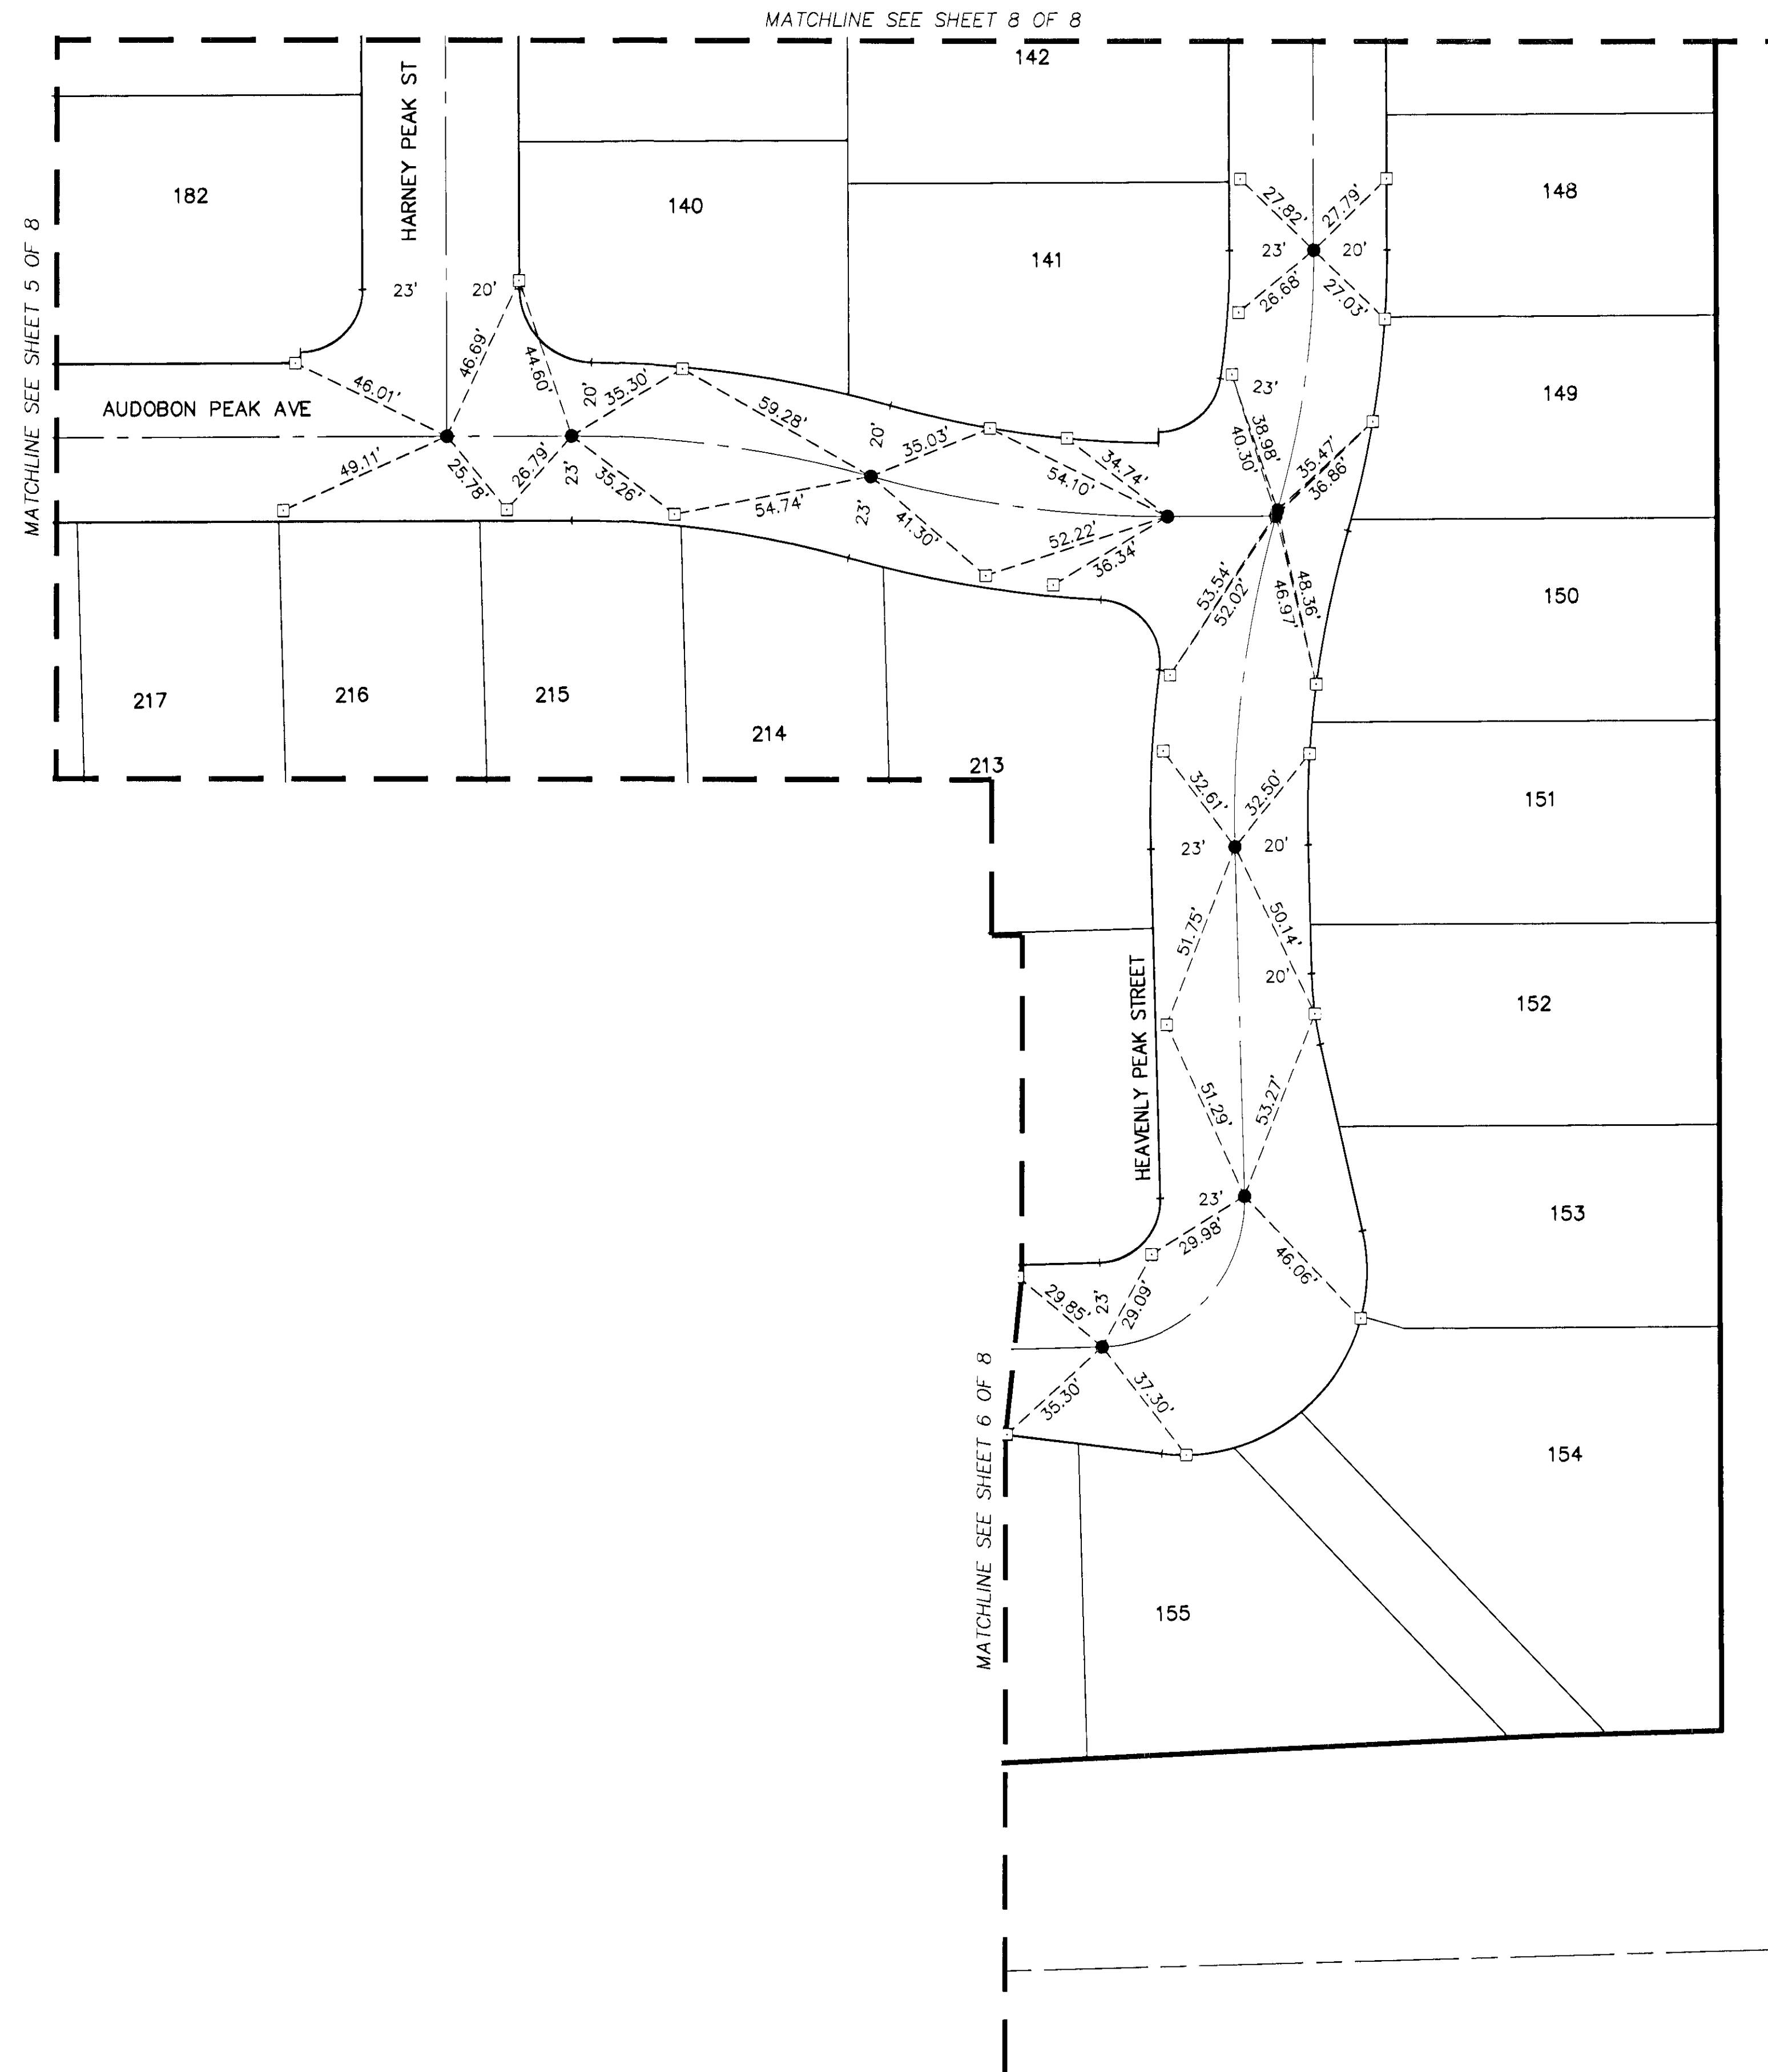

LEGEND	
	SUBDIVISION BOUNDARY LINE
	ALIQUOT PART LINE
	ASSESSOR'S PARCEL LINE
	LOT LINE
	RIGHT-OF-WAY LINE/ LIMITS OF PRIVATE STREET
	STREET CENTERLINE
	MATCHLINE
N.A.P.	NOT A PART
	FOUND MONUMENT AS DESCRIBED
	SET TYPE III MONUMENT STAMPED "PLS 17449"
	SET TYPE IV-A MONUMENT STAMPED "PLS 17449"
1	LOT NUMBER

HUALAPAI
FOUND ALUMINUM CAP
IN MONUMENT WELL
STAMPED "PLS 14419"
1/4
13 | 18

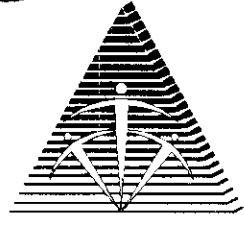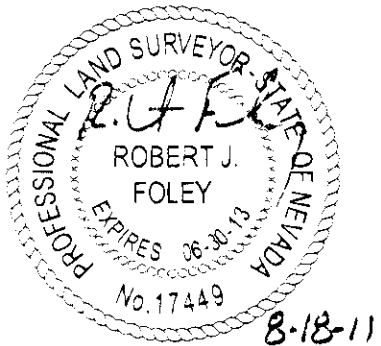

052-4830-1
TRI-CORE
SURVEYING, LLC
6761 WEST CHARLESTON BLVD.
LAS VEGAS, NEVADA 89146
TEL (702) 821-1554 FAX (702) 870-4378

127922
JOB# 16007.0009