

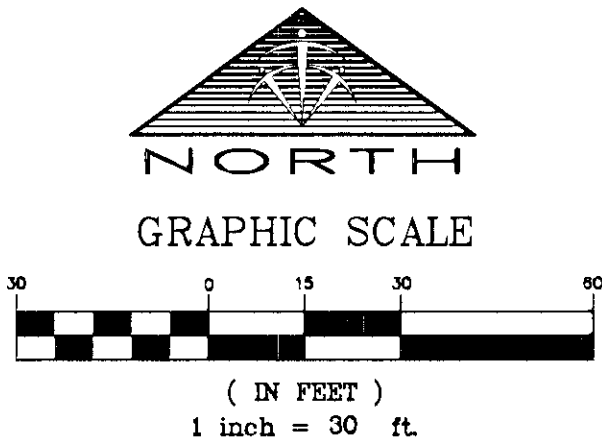
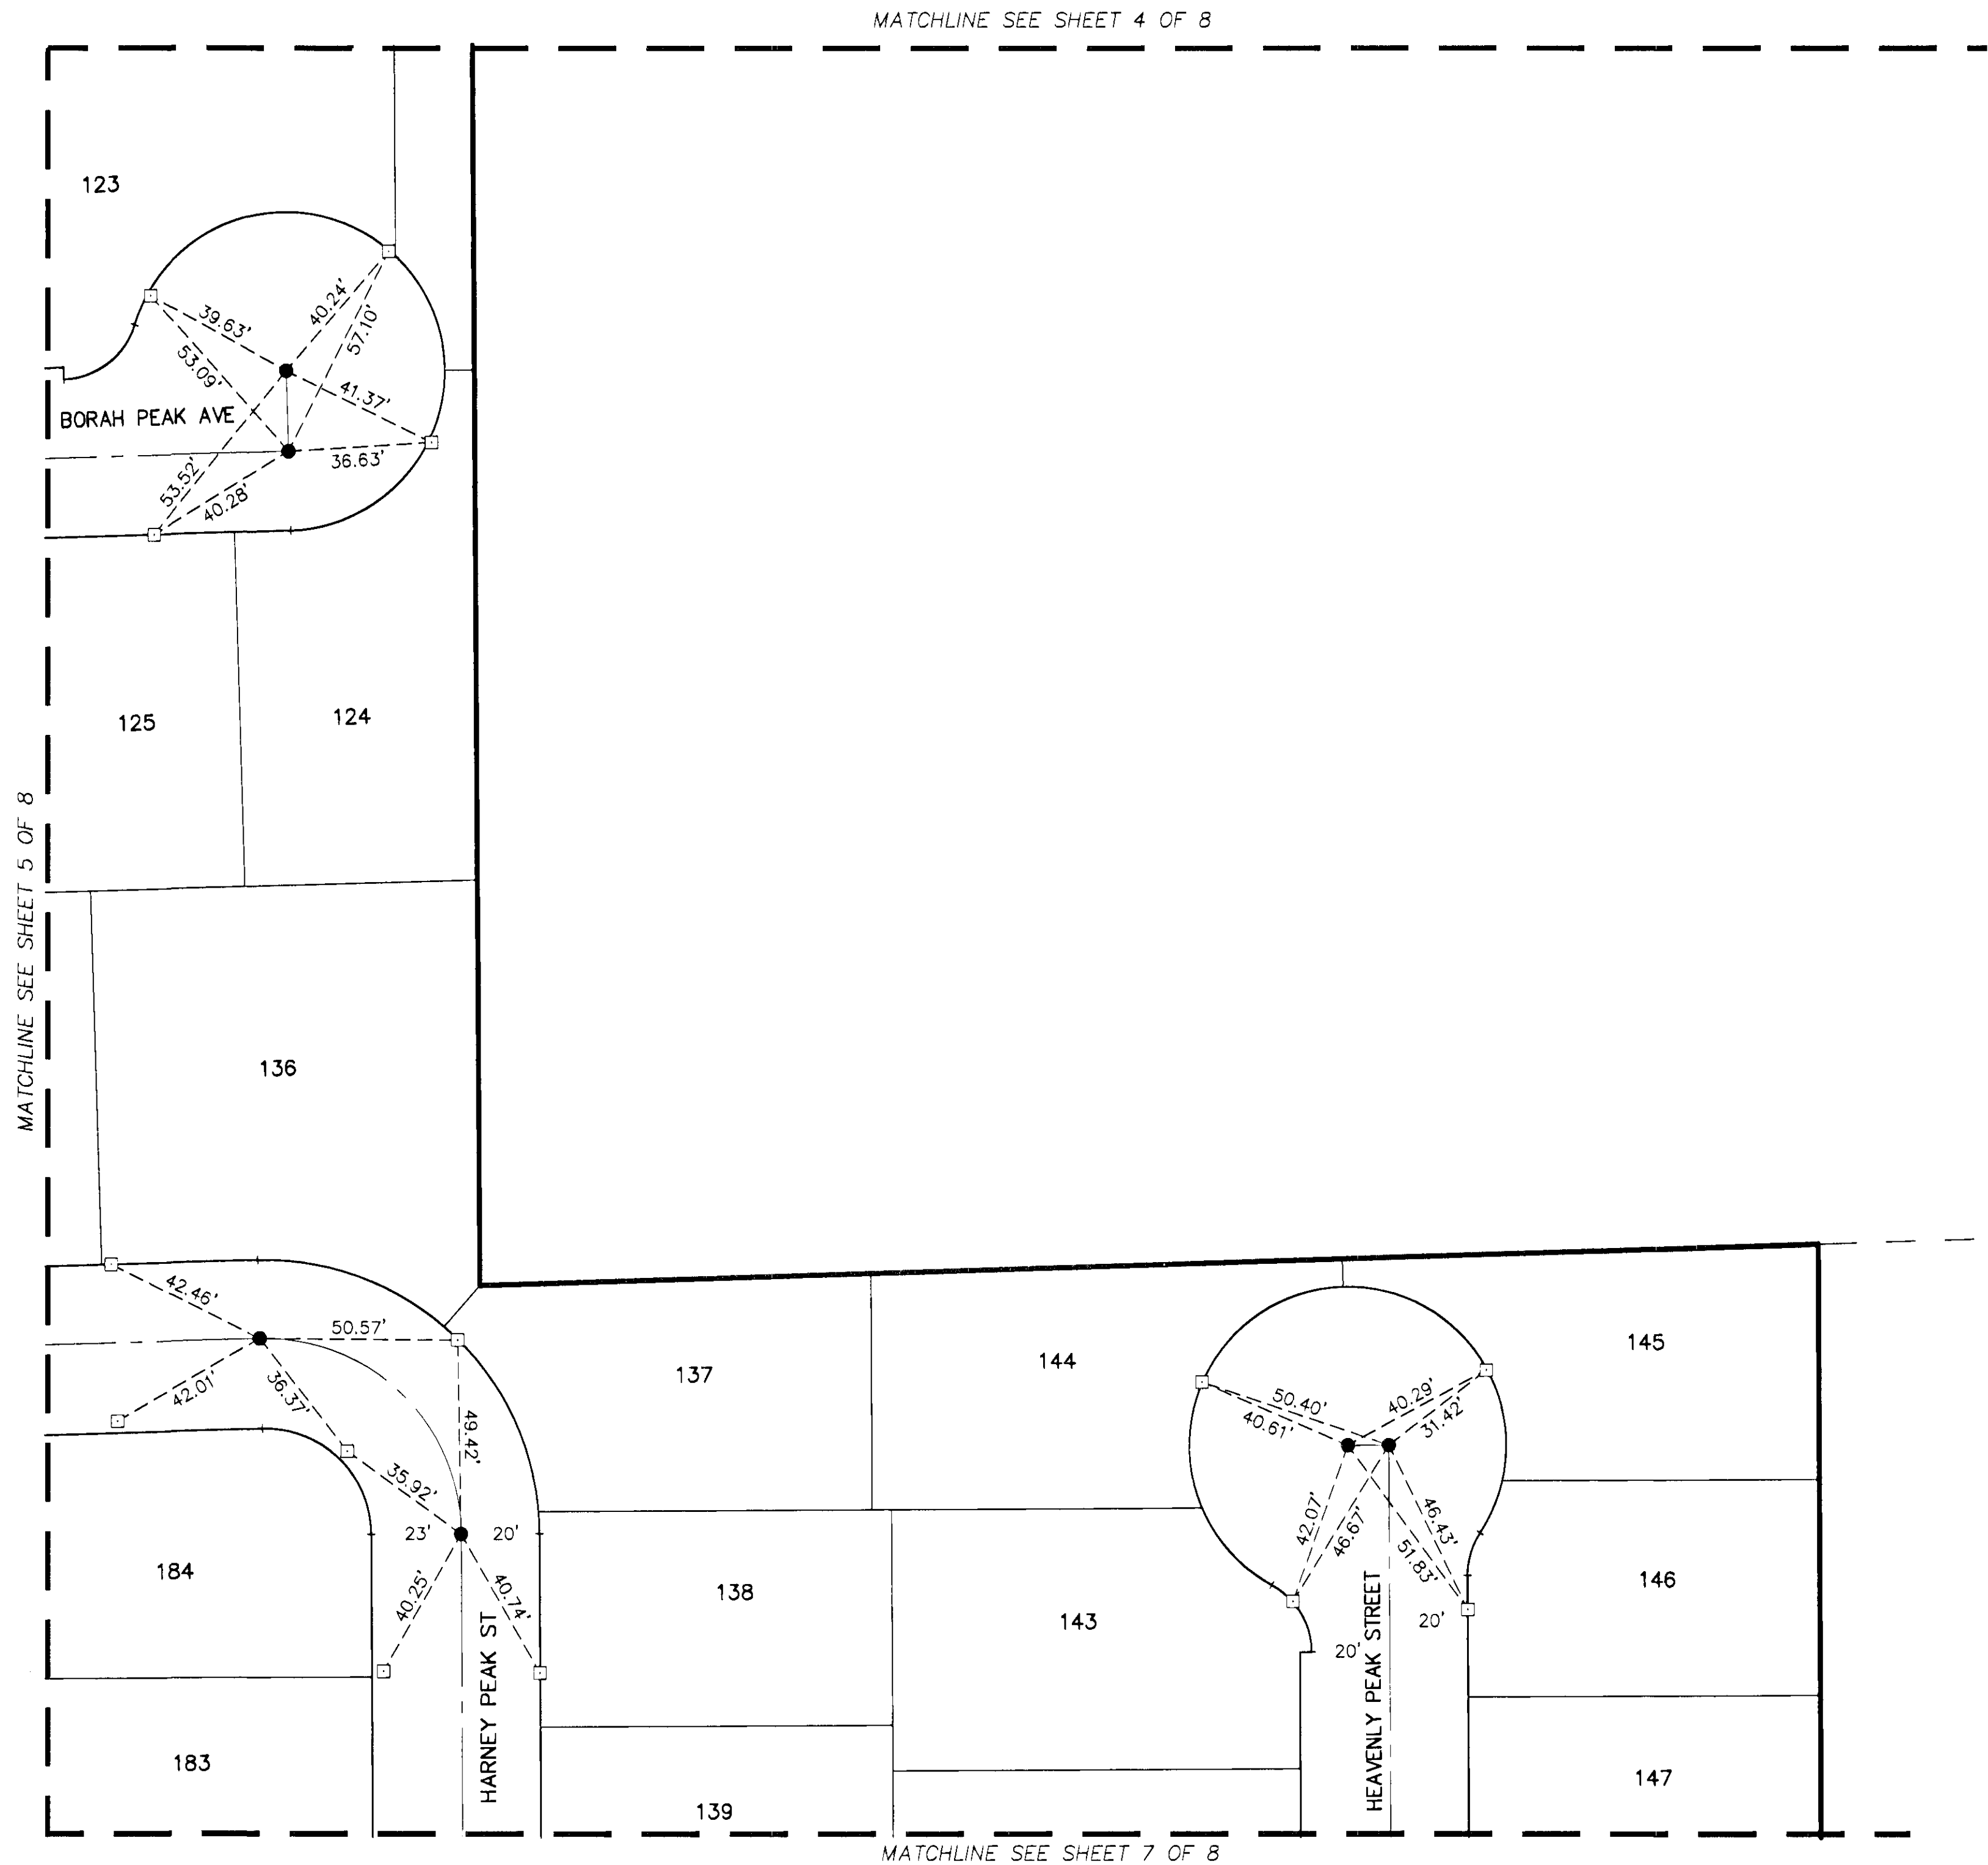


MONUMENT TIE MAP OF
PODS 106 AND 109 AT PROVIDENCE MODELS & UNIT 1

AS SHOWN ON THOSE CERTAIN MAPS ON FILE IN THE CLARK COUNTY RECORDER'S OFFICE IN BOOK 133, PAGE 58 OF PLATS & BOOK 135, PAGE 28 OF PLATS, SITUATE IN THE NORTHEAST QUARTER (NE1/4) OF SECTION 13, TOWNSHIP 19 SOUTH, RANGE 59 EAST, M.D.M., CITY OF LAS VEGAS, CLARK COUNTY, NEVADA

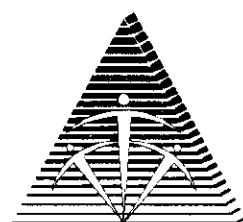

- LEGEND**
- SUBDIVISION BOUNDARY LINE
 - - - ALIQUOT PART LINE
 - - - ASSESSOR'S PARCEL LINE
 - LOT LINE
 - RIGHT-OF-WAY LINE/
LIMITS OF PRIVATE STREET
 - STREET CENTERLINE
 - - - MATCHLINE
 - N.A.P. NOT A PART
 - FOUND MONUMENT AS DESCRIBED
 - SET TYPE III MONUMENT
STAMPED "PLS 17449"
 - SET TYPE IV-A MONUMENT
STAMPED "PLS 17449"
 - 1 LOT NUMBER

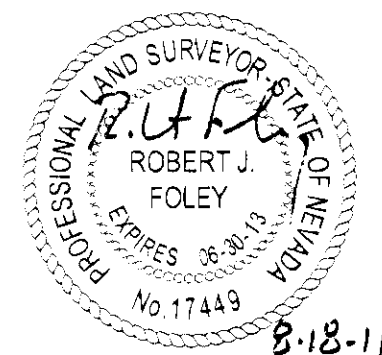

058-4930-1
TRI-CORE
SURVEYING, LLC
6761 WEST CHARLESTON BLVD.
LAS VEGAS, NEVADA 89146
TEL. (702) 821-1554 FAX (702) 870-4378

177923
JOB# 16007.0009