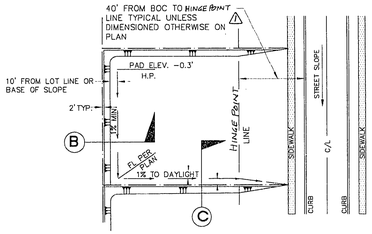

A — TYPICAL INTERIM LOT GRADING DETAIL
SCALE NONE

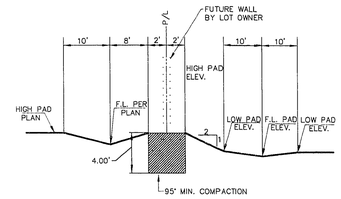

B — SCARP SECTION
SCALE NONE

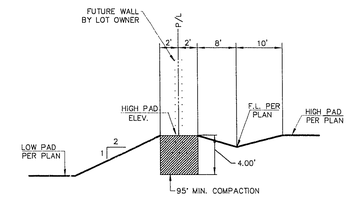

C — SCARP SECTION
SCALE NONE

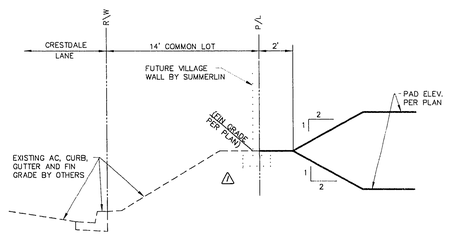

D — BOUNDARY SECTION AT CRESTDALE LANE
SCALE NONE

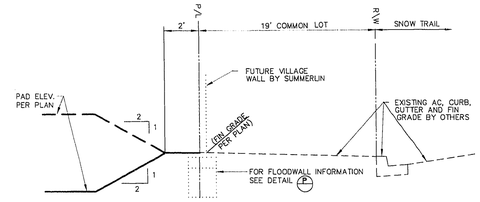

E — BOUNDARY SECTION AT SNOW TRAIL
SCALE NONE

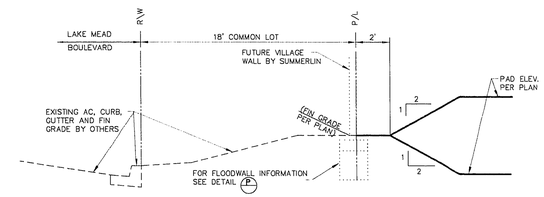

F — BOUNDARY SECTION AT LAKE MEAD BOULEVARD
SCALE NONE

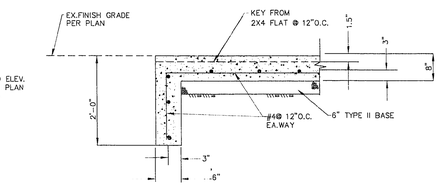

G — HEADWALL SECTION
SCALE NONE

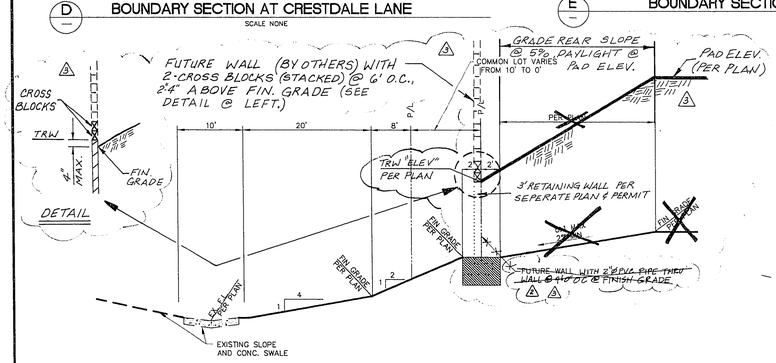

SCALE NONE

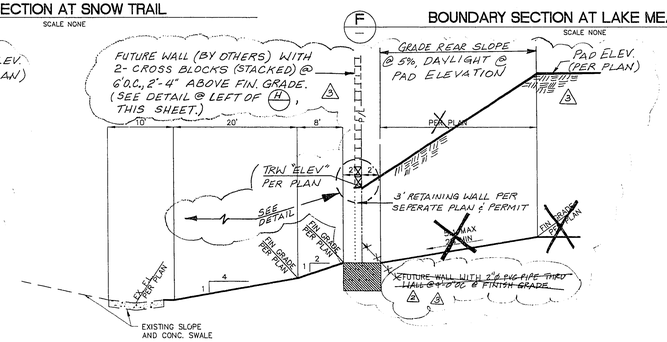

J — CHANNEL SECTION
SCALE NONE

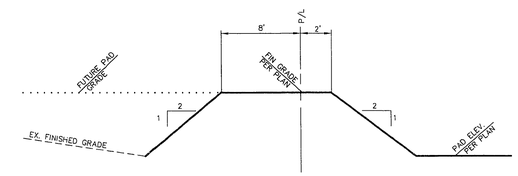

K — INTERIM BERM SECTION
SCALE NONE

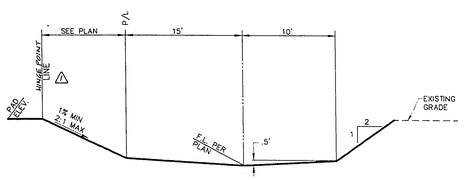

L — INTERIM SWALE SECTION
SCALE NONE

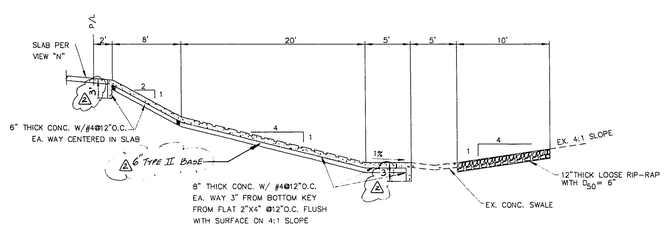

M — SWALE SECTION
SCALE NONE

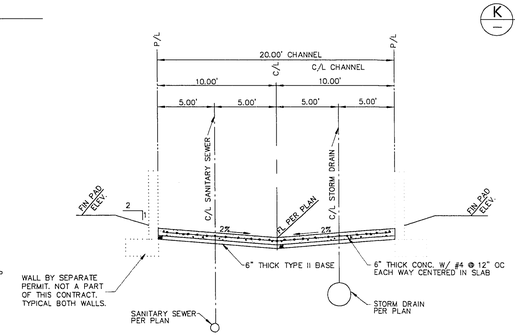

N — CHANNEL SECTION AT COMMON LOT "K"
SCALE NONE

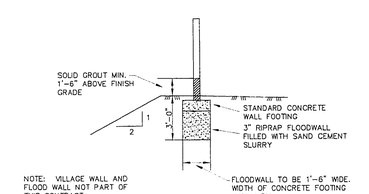

P — FLOODWALL DETAIL
SCALE NONE

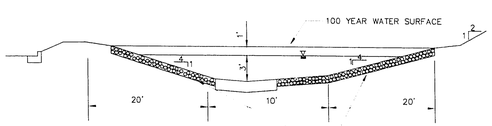

REMOVE UPPER 6" OF EXISTING MATERIAL AND REPLACE WITH MINIMUM 3" ROUND RIP-RAP. 6" LAYER. EXTENT TO BE FROM LAKE MEAD BLVD TO CRESTDALE LANE. THIS WORK TO BE ADDED AS PART OF VILLAGE 7 PHASE II. NOT A PART OF THIS CONTRACT

Q — HILLPOINT CHANNEL SECTION
LOOKING SOUTH

	DATE	DESCRIPTION
3	2-8-95	Revised per Comments of Bureau of Engineering
2	12-27-94	Revised per Comments of Bureau of Engineering
1	12-27-94	Revised Sect B, Revised Sect C, Revised Sect A

RECOMMENDED — DATE — REV. — DATE — APPROVAL

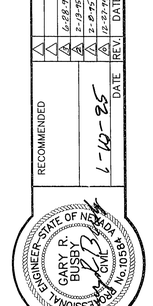

ENGINEER
THE KEITH COMPANIES NEVADA
4032 SO. INDUSTRIAL RD. LAS VEGAS, NV 89103 (702) 733-0350

- PLANNING
- CIVIL ENGINEERING
- LANDSCAPE ARCHITECTURE
- LAND SURVEYING
- CONSTRUCTION MANAGEMENT

HOWARD HUGHES PROPERTIES
SUMMERLIN VILLAGE 7 - THE TRAILS - MOUNTAIN TRAILS

DETAIL SHEET

SHEET
DE-2
SHT 19 OF 27

12-27-94

11-19-225

1074-4371

Z:\SMS2\JOBS\DE2 Wed Feb 9 12:54:50 1995 SHADED 1=Q WHITEOUT 10. SOLID 11 & UP- 486-50#10
HP Designjet 650C HP-GL/2 Acc. v2.0 plotter driver by Hewlett-Packard 1.0