

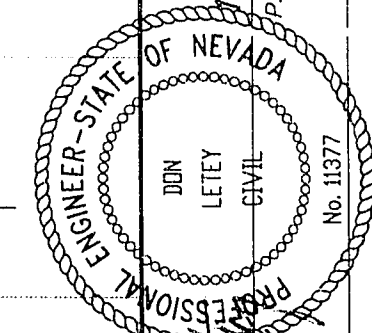
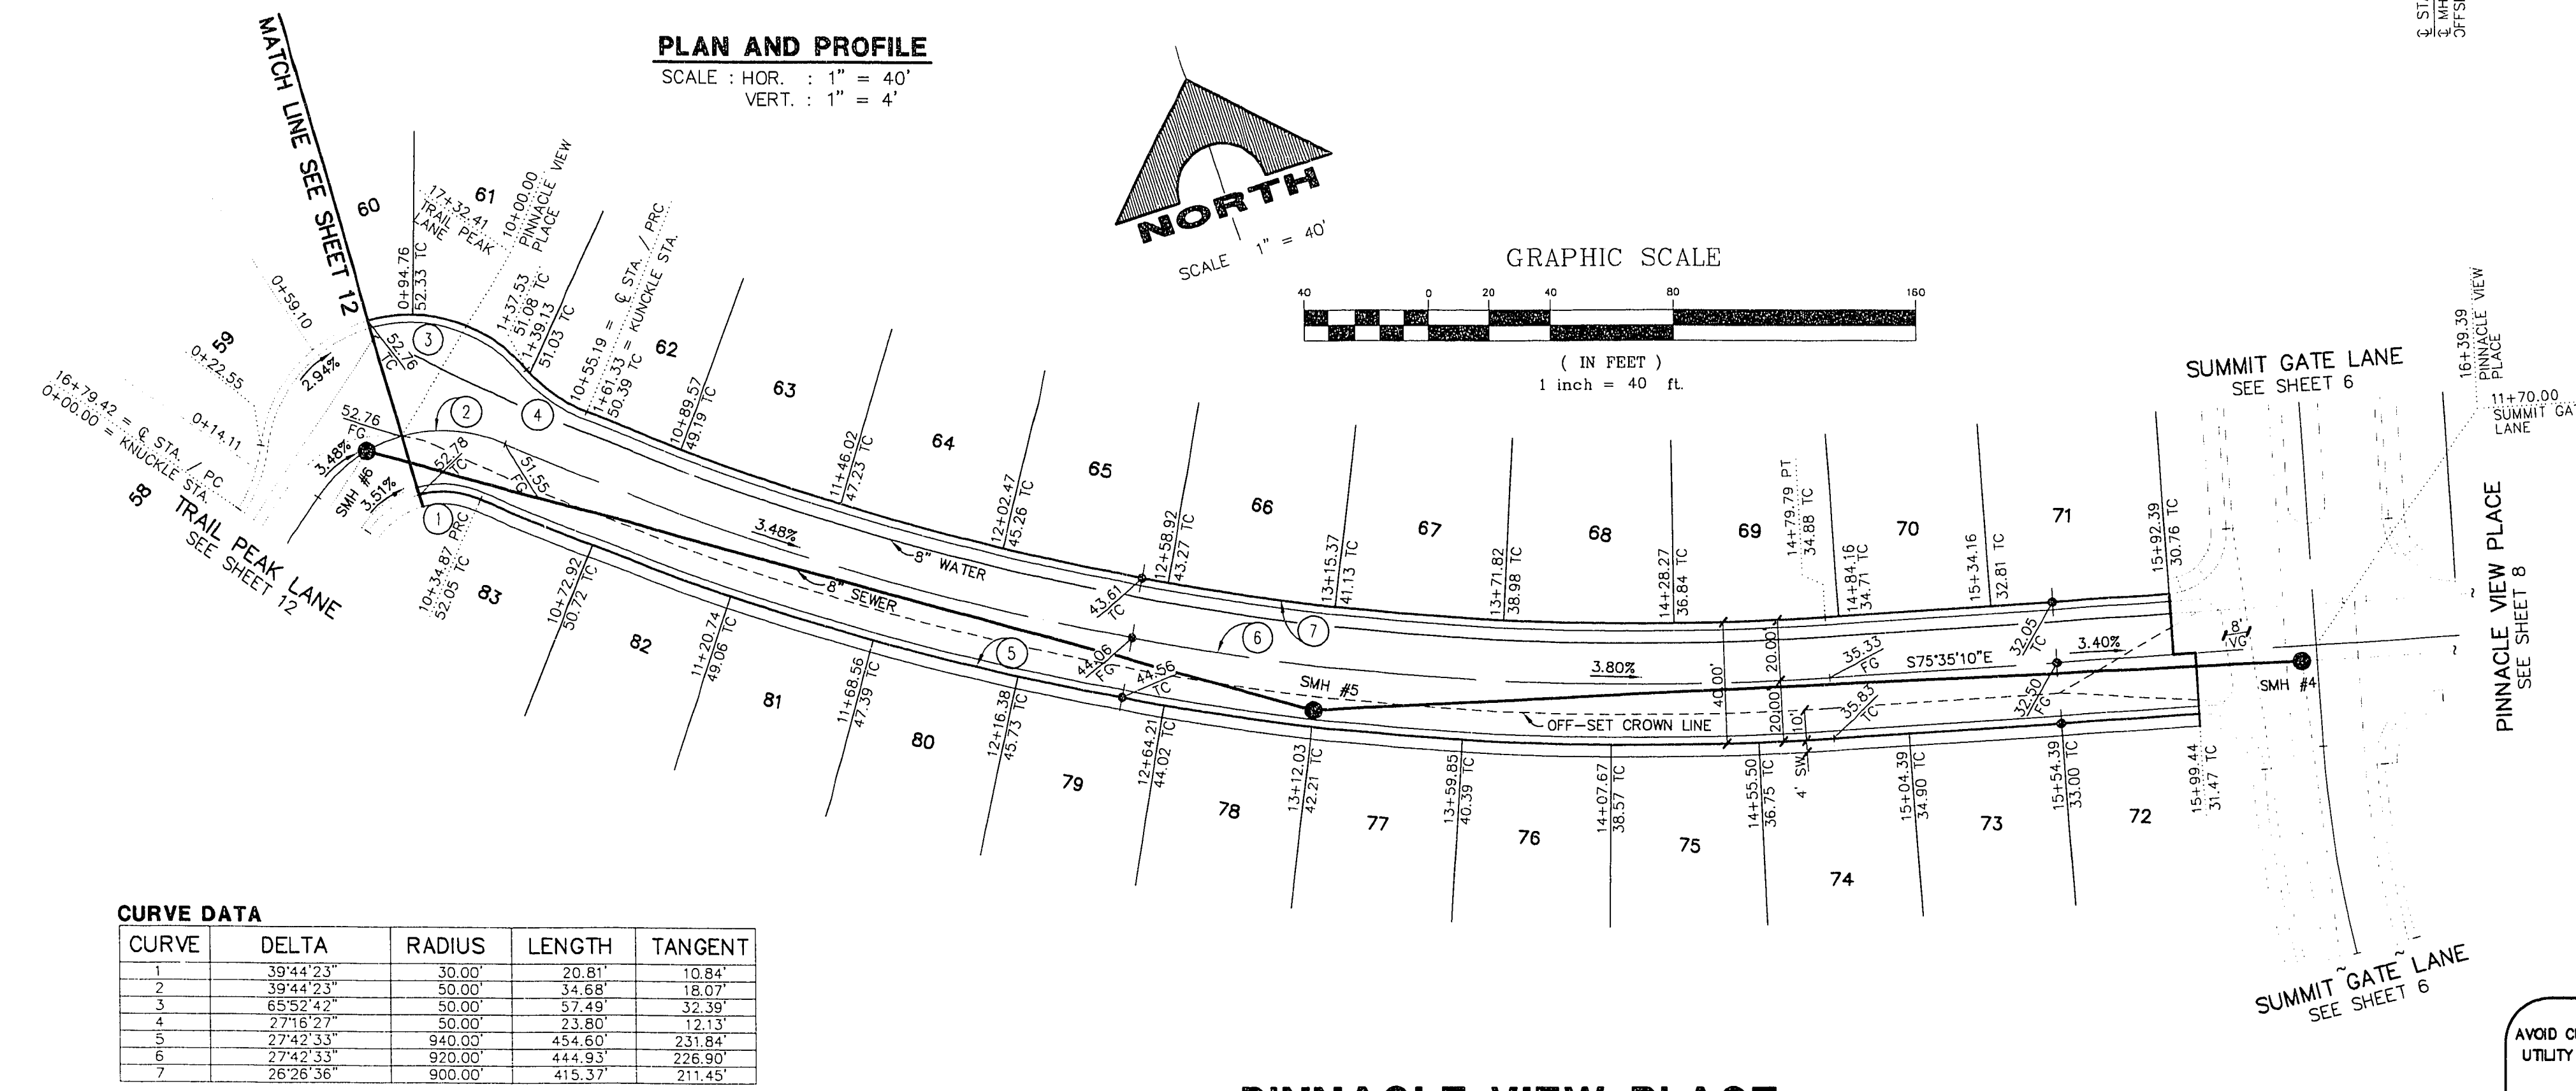


REV	DATE	DESCRIPTION
1	11/14/95	ISSUED FOR PERMITS
2	1/17/97	REVISED PER PERMITS
3	1/17/97	REVISED PER PERMITS
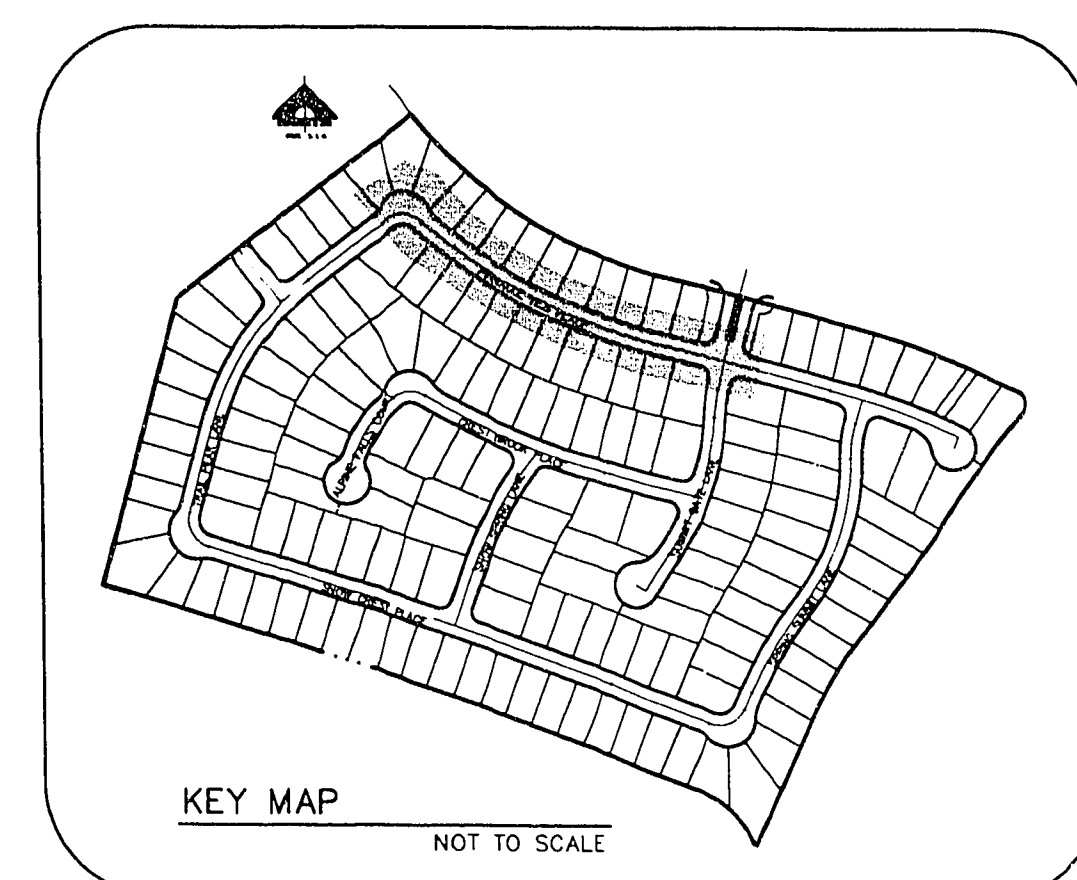

G. C. WALLACE, INC.
Engineering/Architecture
1555 SOUTH RAINBOW BLVD., LAS VEGAS, NEVADA 89102
(702) 363-1200

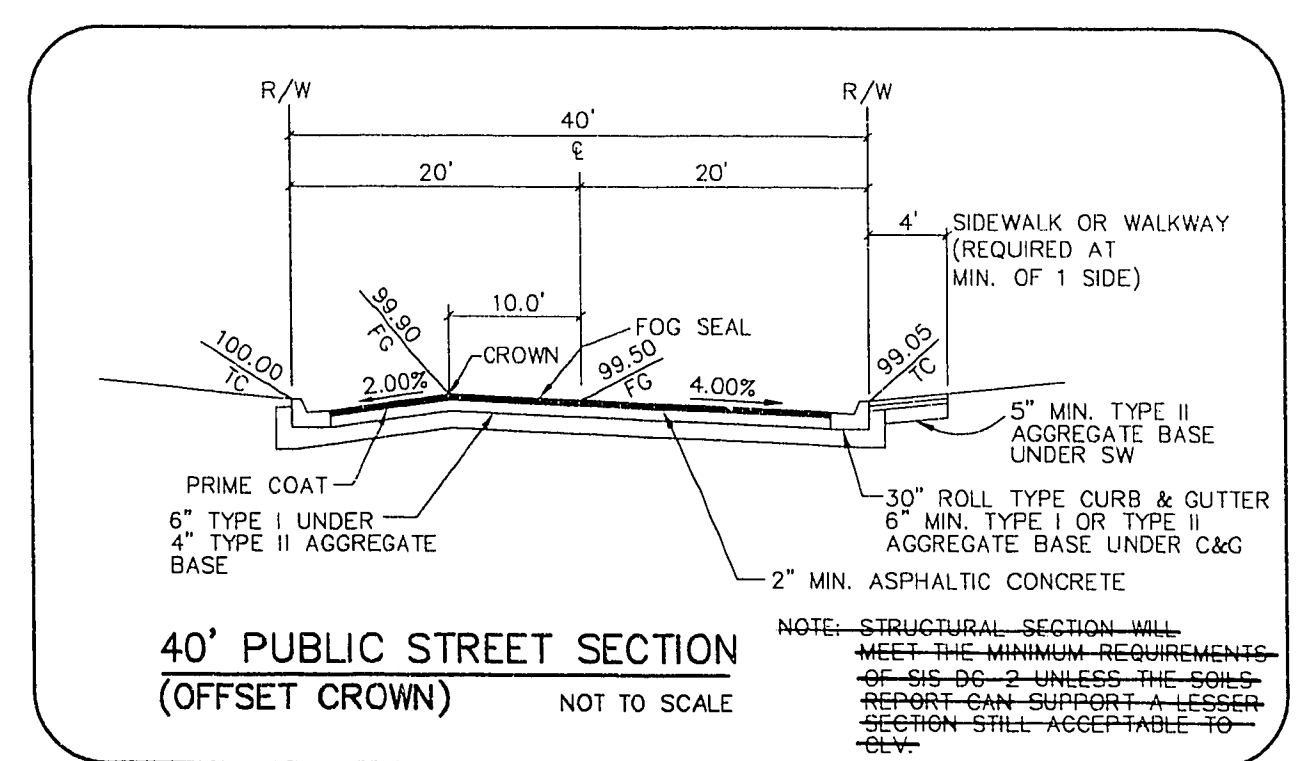

AVOID CUTTING UNDERGROUND UTILITY LINES. IT'S COSTLY.

Call before you Dig.

1-800-227-2600

UNDERGROUND SERVICE ALERT (USA)

780.010D

PLOTTED: 05/10/95
MG-SI-02.DWG

MOUNTAIN GATE WEST
BEAZER HOMES
PINNACLE VIEW PLACE

SHEET
7
OF 21 SHEETS

11-22-126

107-4397