




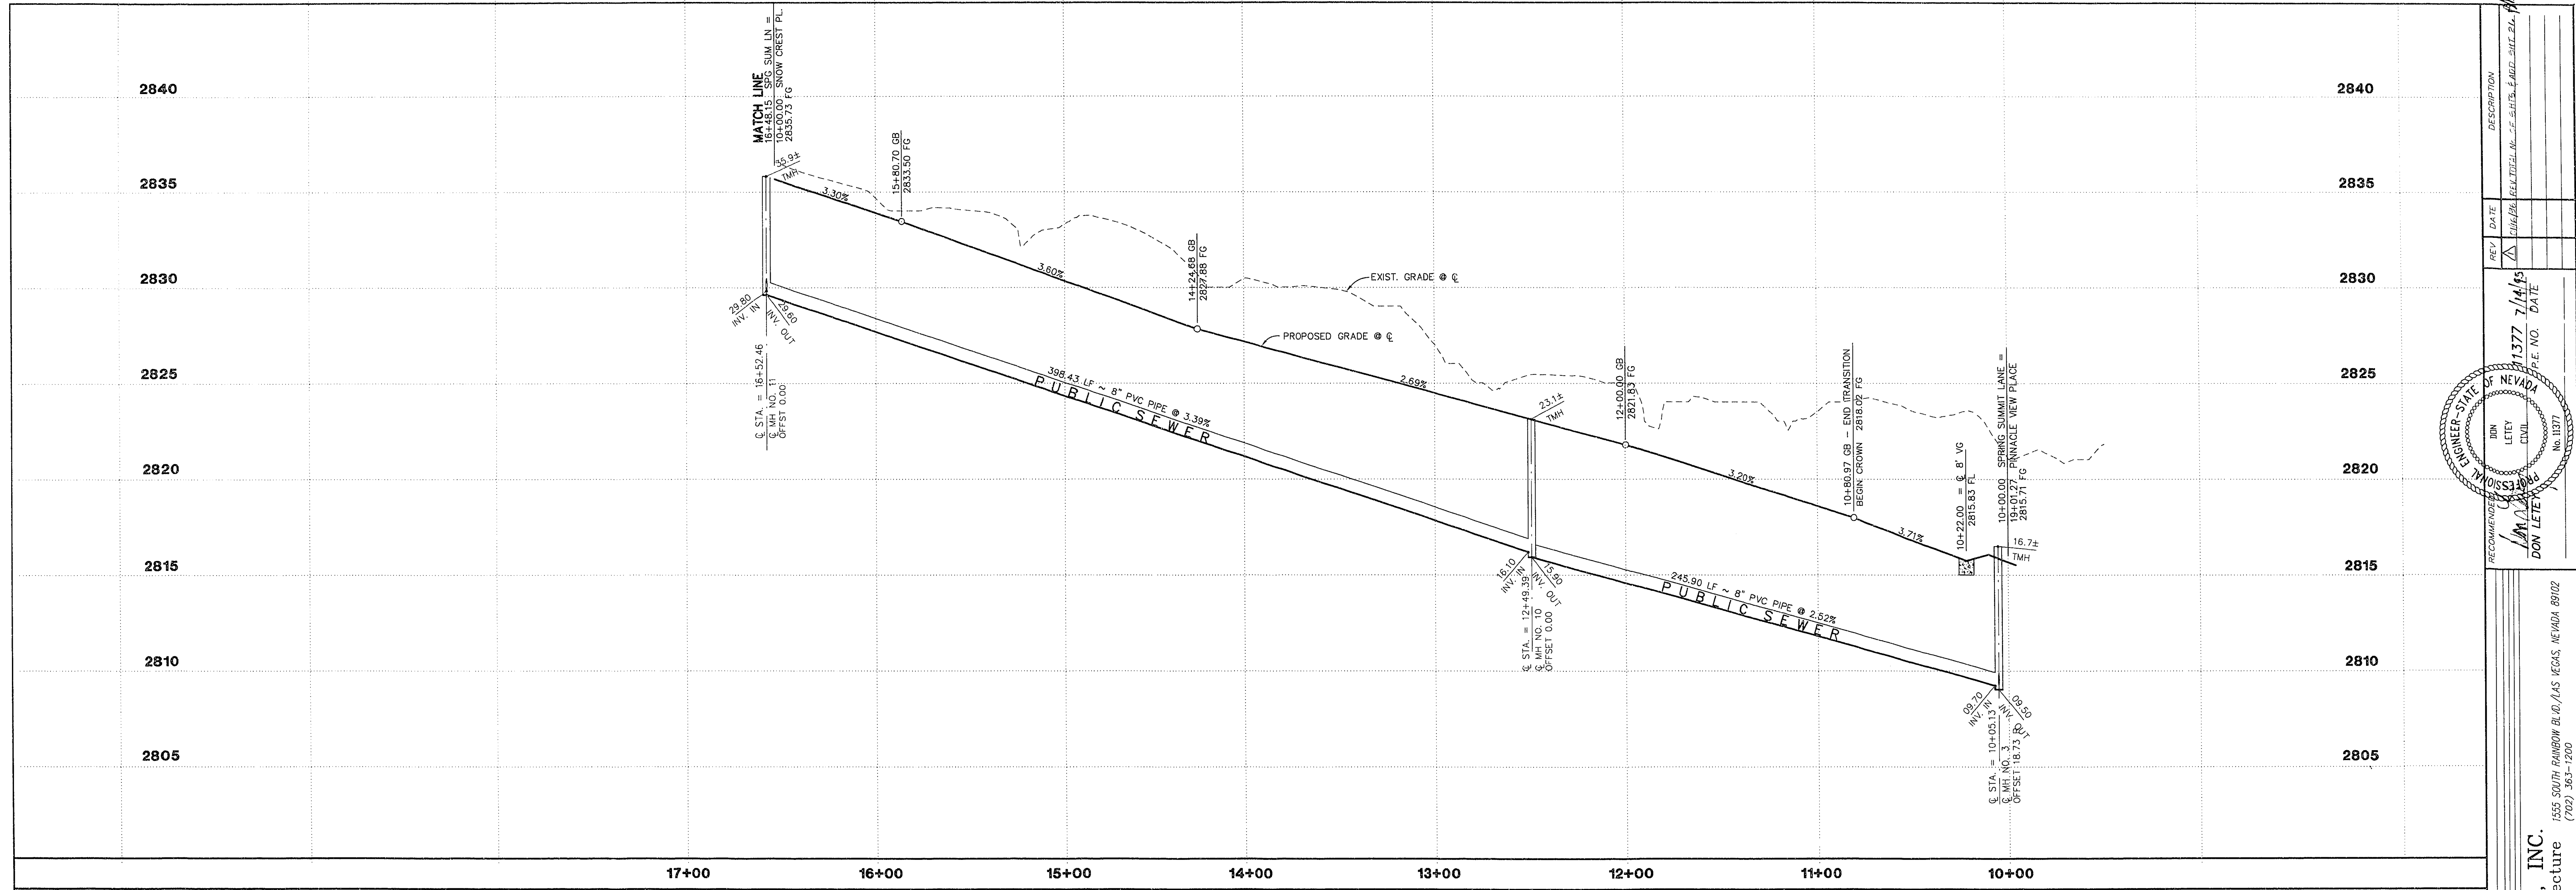


REV	DATE	DESCRIPTION
1	7/14/15	11-22-128
2	7/14/15	107Y-4397

ENGINEER-STATE OF NEVADA
DON LEE
CIVIL

G.C. WALLACE, INC.
Engineering/Architecture
1555 SOUTH RAINBOW BLVD., LAS VEGAS, NEVADA 89102
(702) 363-1200

MOUNTAIN GATE WEST
BEAZER HOMES
SPRING SUMMIT LANE
SHEET 9 OF 21 SHEETS

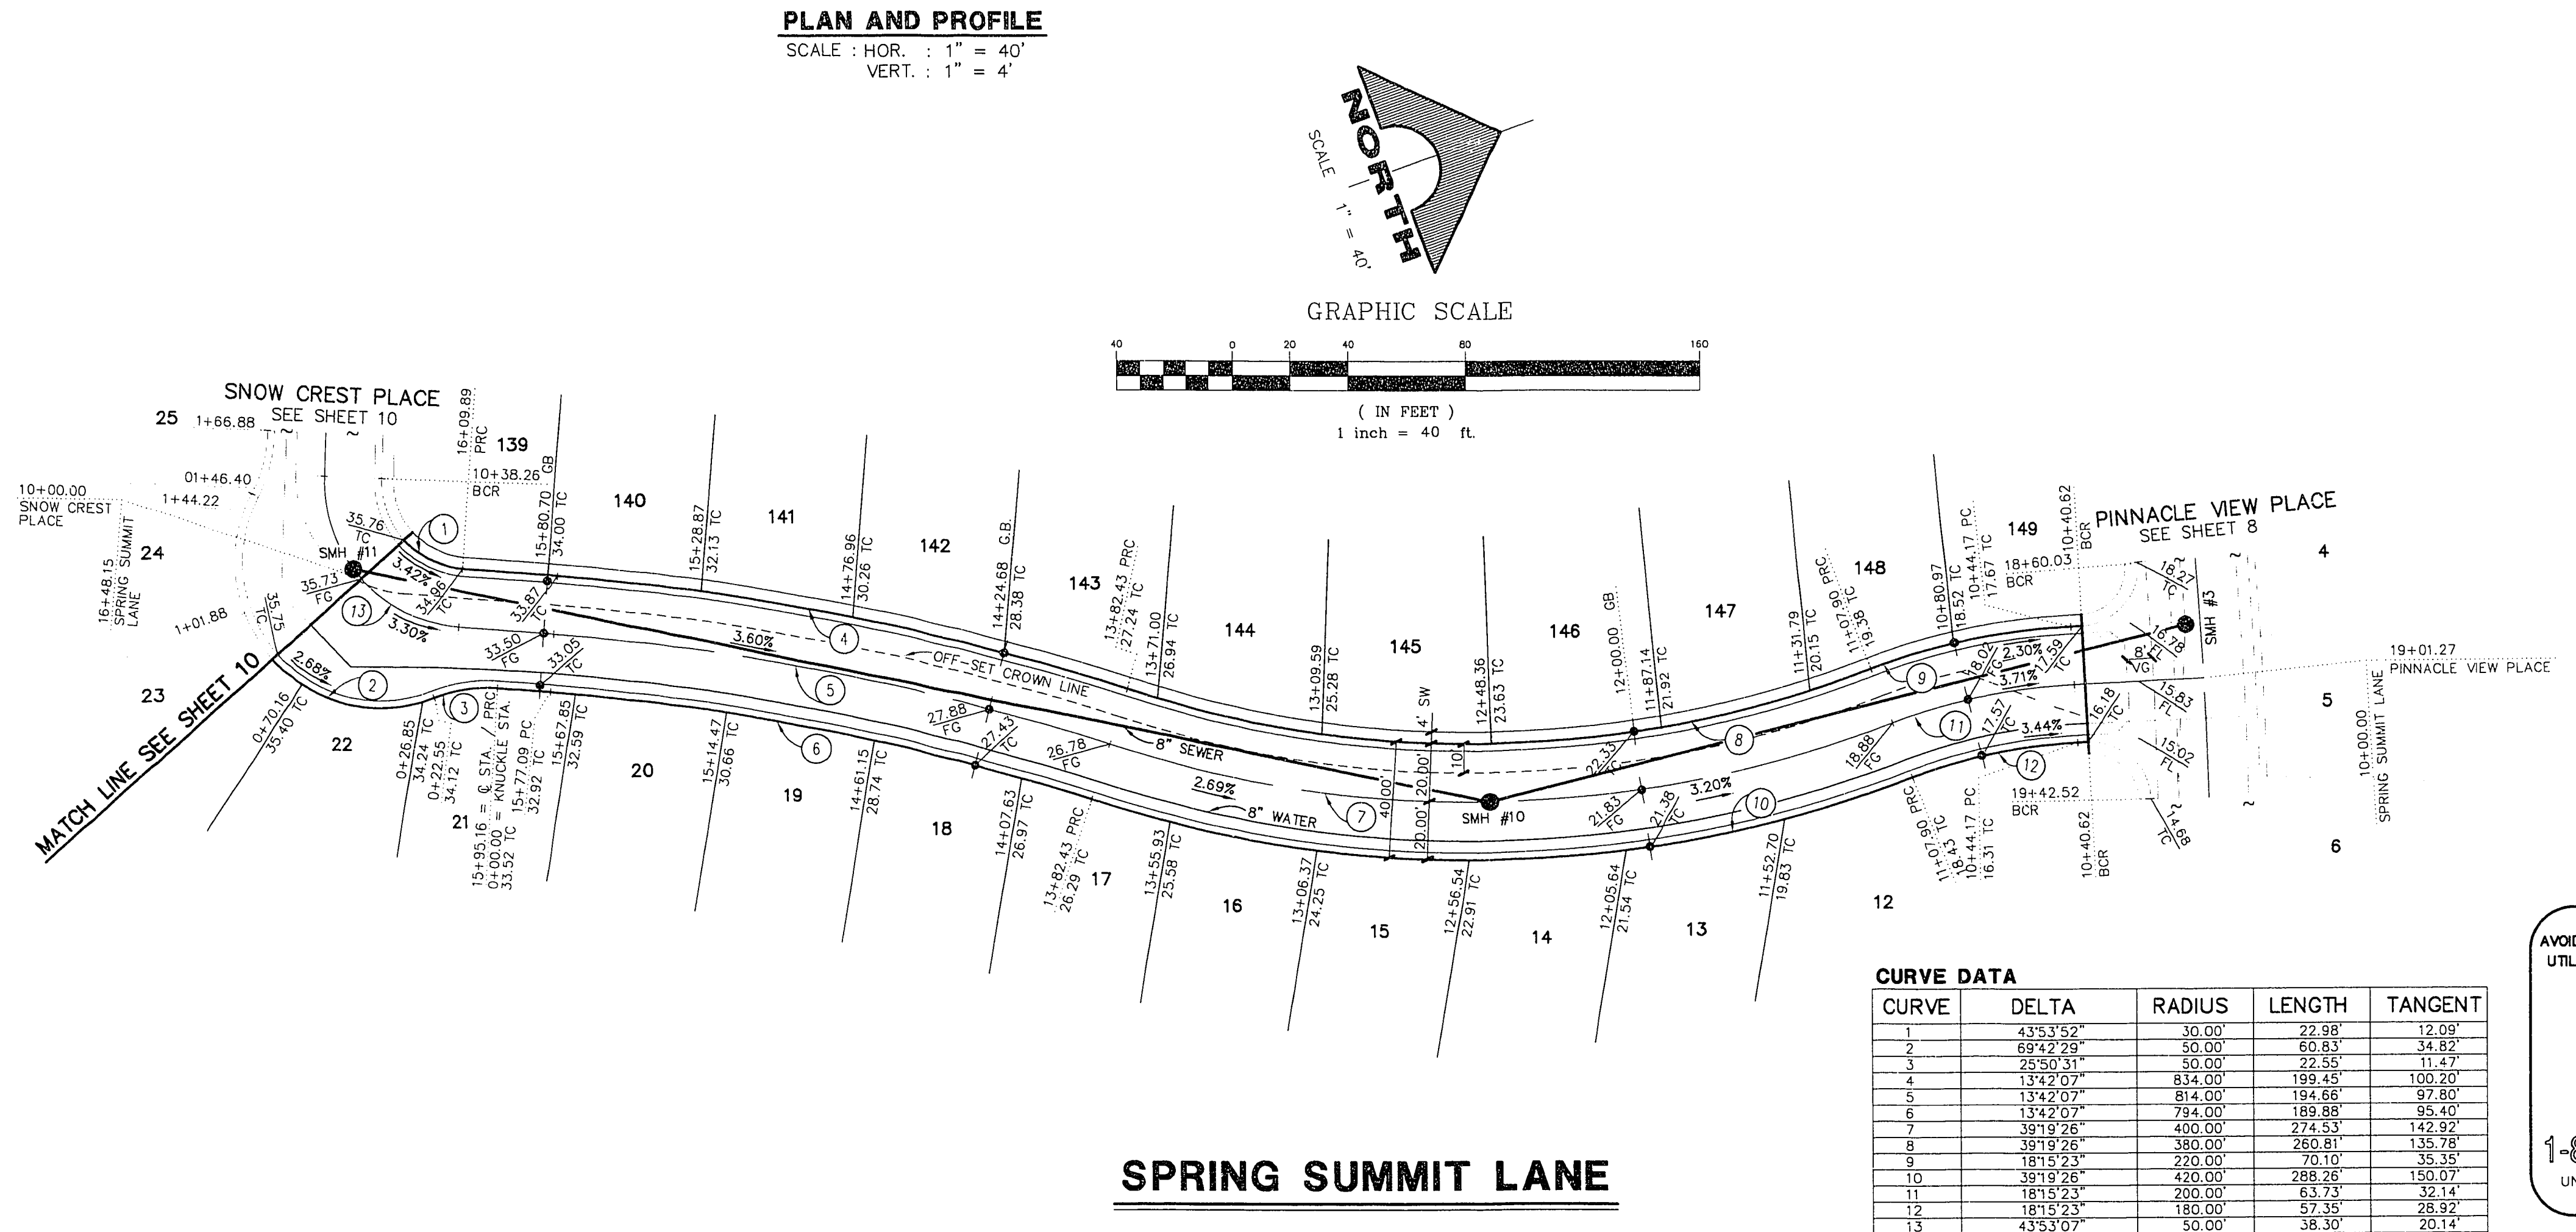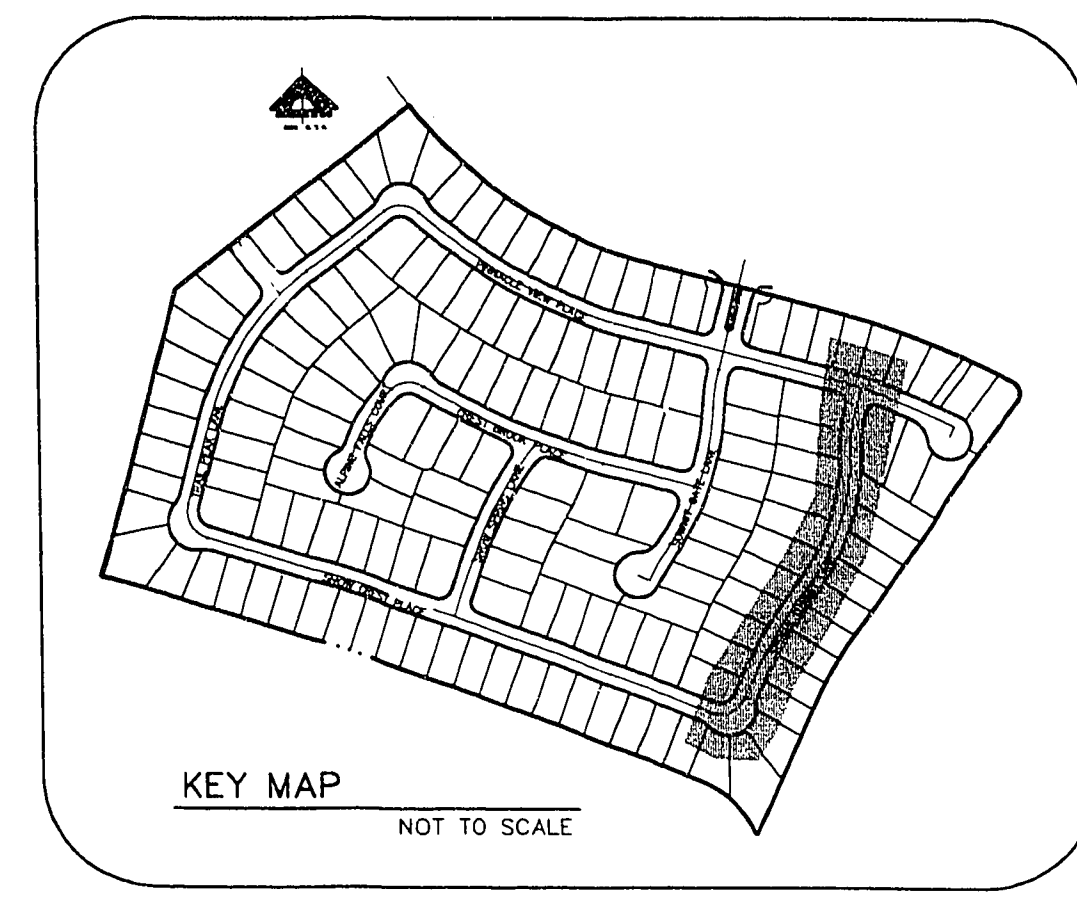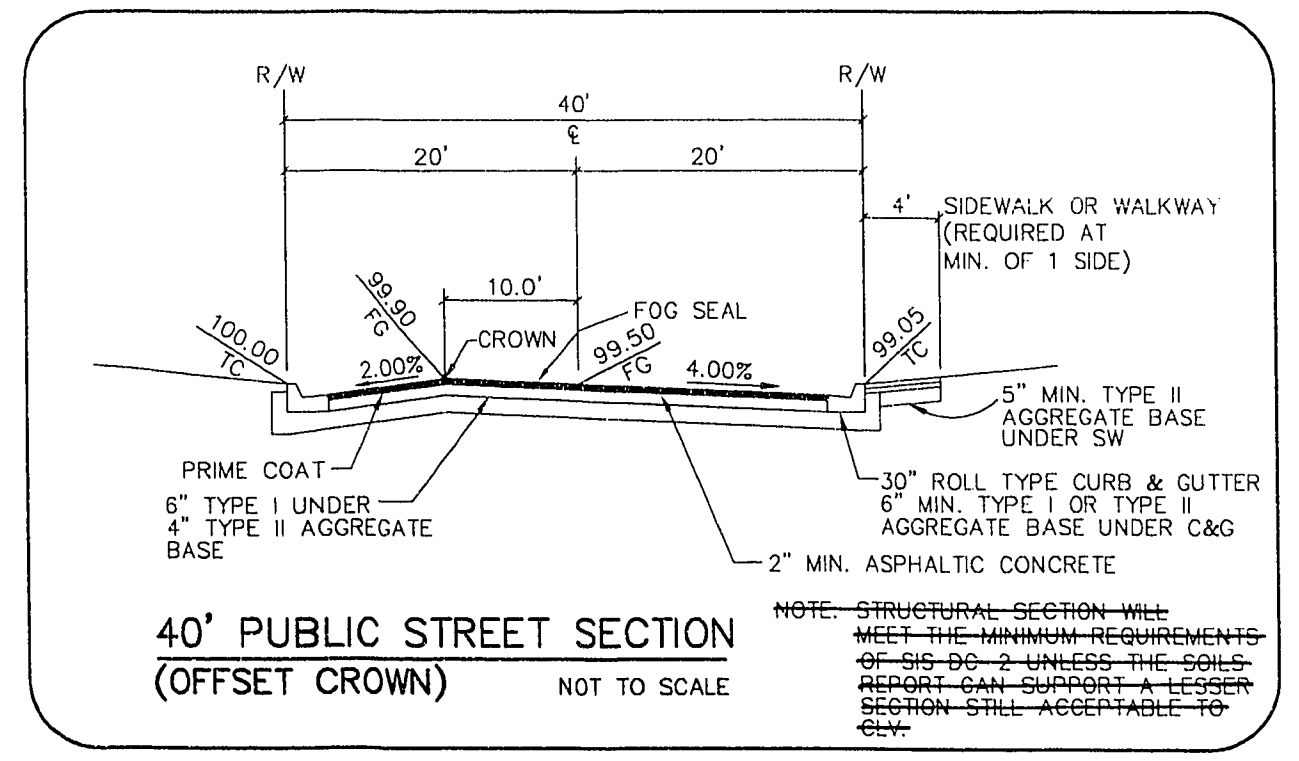

CURVE DATA				
CURVE	DELTA	RADIUS	LENGTH	TANGENT

AVOID CUTTING UNDERGROUND UTILITY LINES. IT'S COSTLY.
Call before you Dig
1-800-227-2600
UNDERGROUND SERVICE ALERT (USA)