
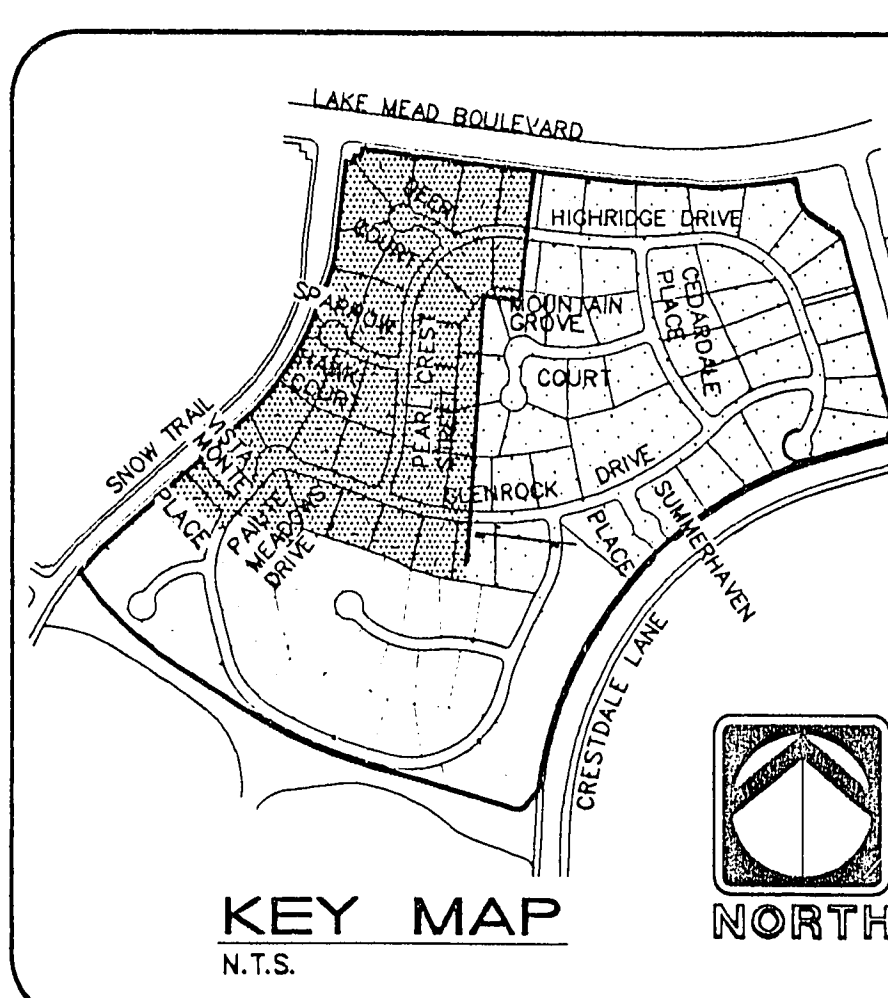
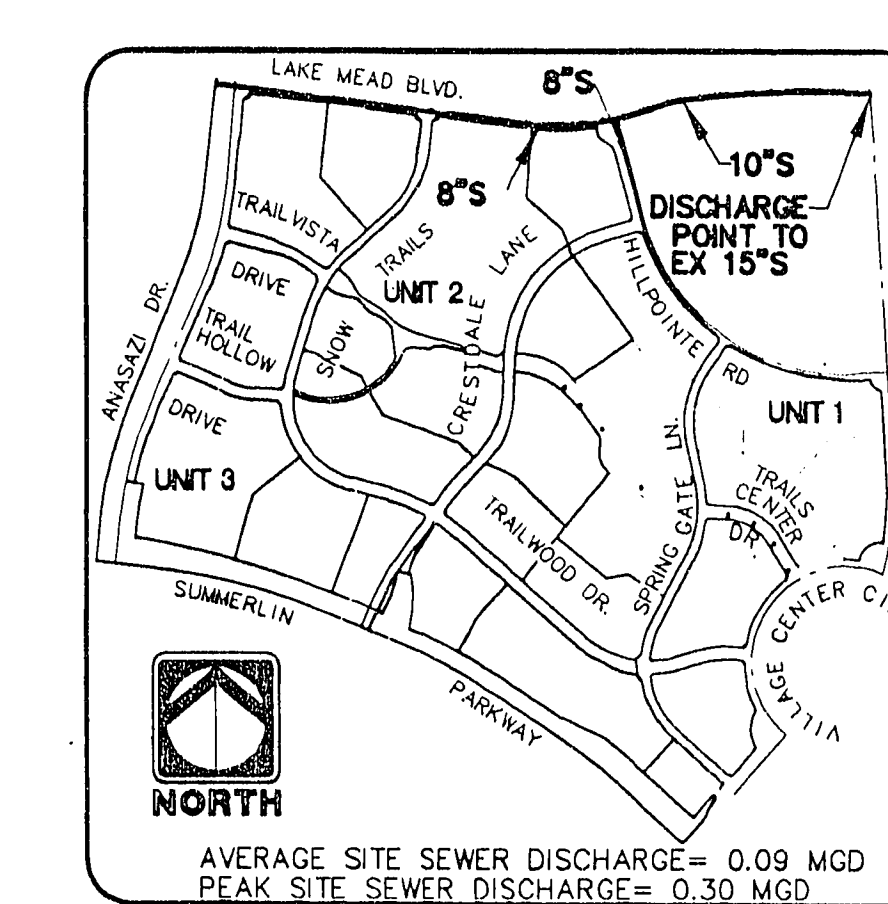
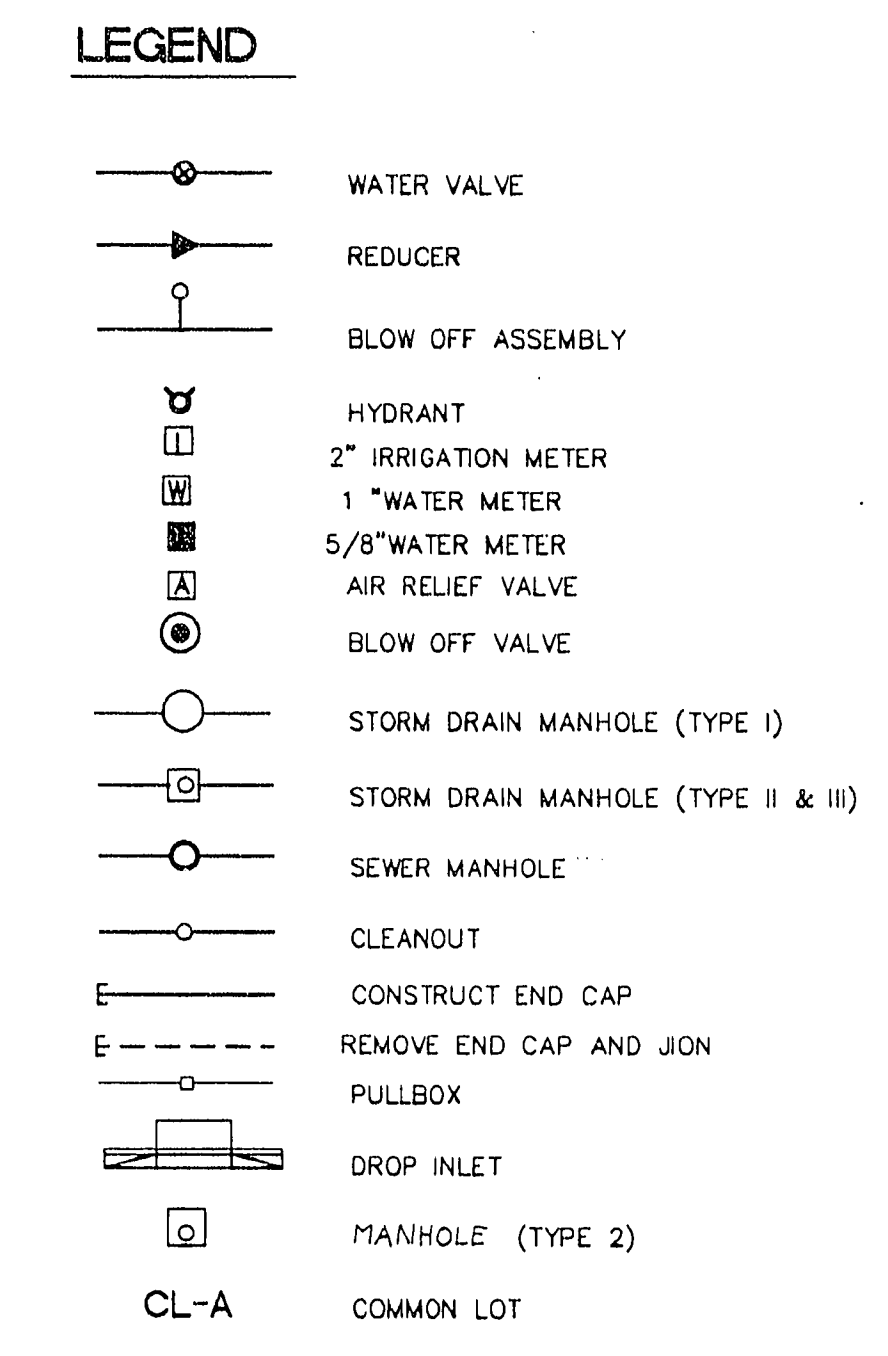


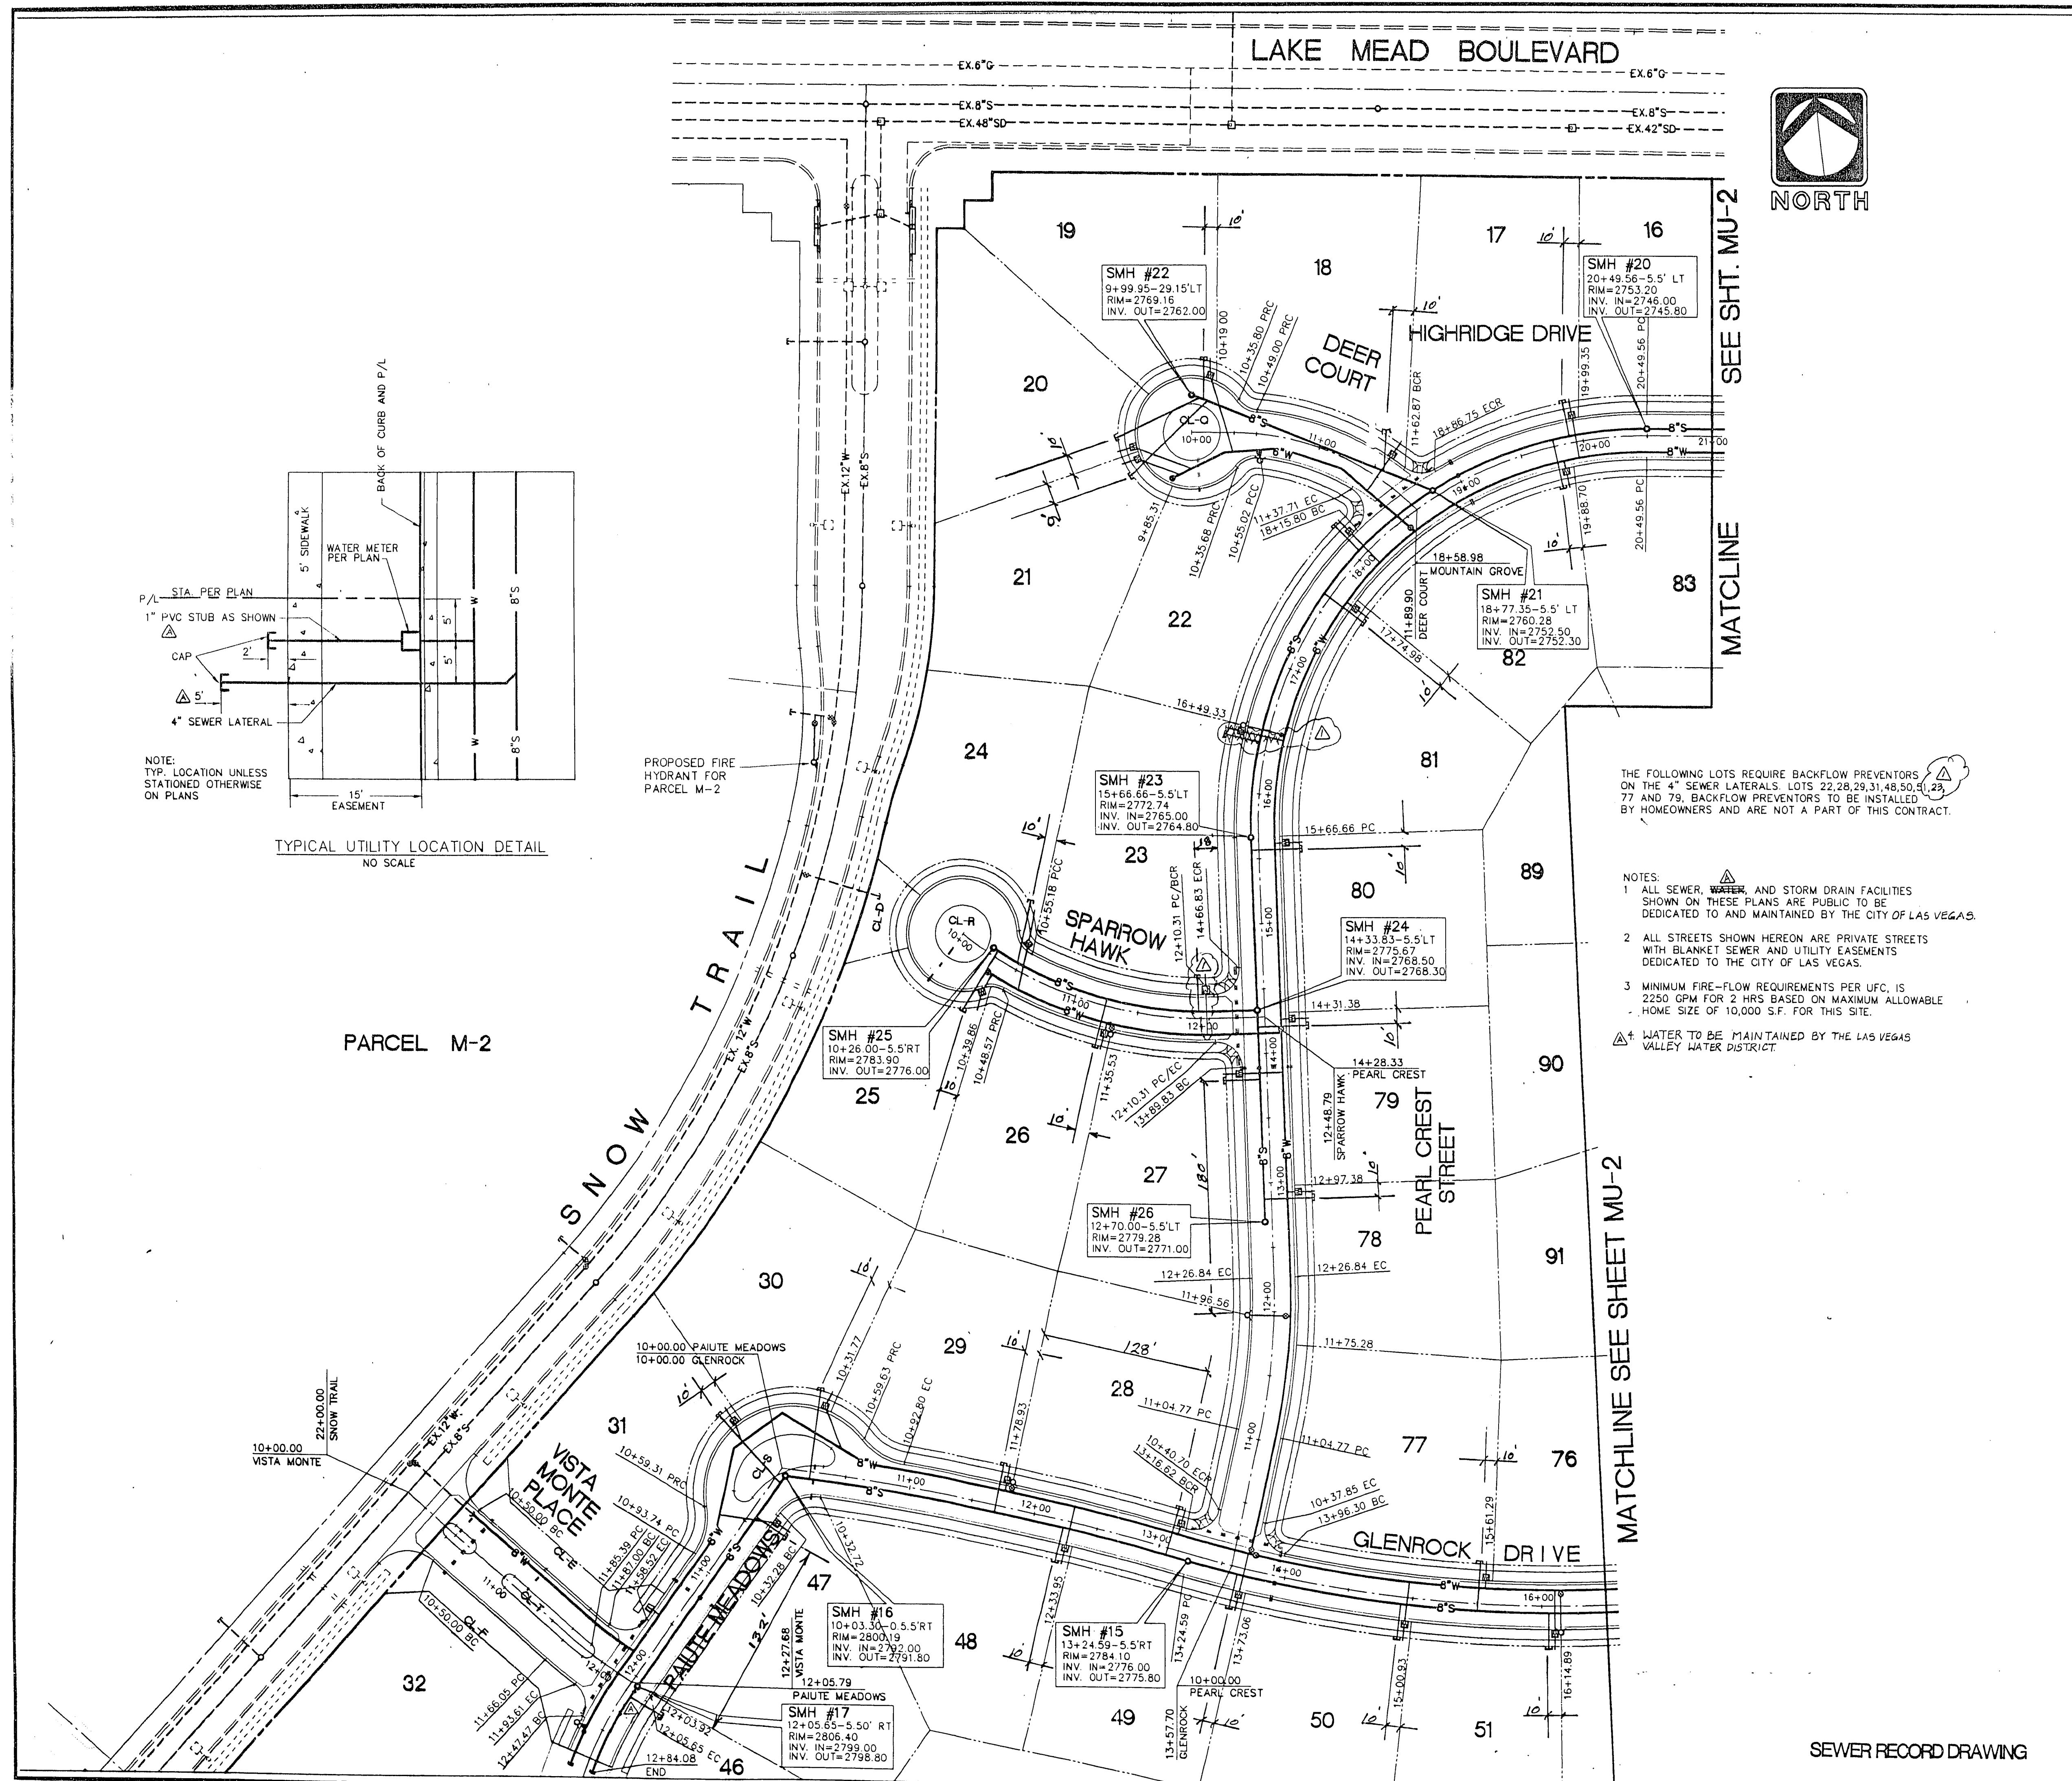

Avoid cutting underground  
utility lines. It's costly.

**Call  
before you  
Dig.**

**1-800-227-2600**  
UNDERGROUND SERVICE (USA)

[illegible]

G:\SUN501P\504001 Tue Jan 17 10:37:29 1995 SHADED 1-g, WHITEOUT 10, SOLID 11 & JP- 485-50410  
HP DesignJet 600! HP-G/L/2 A01 4.2 Plotter driver by Hewlett-Packard 1.0