


MONUMENT TIE MAP OF LEWIS HOMES - LAS VEGAS - NO. 9A

Being a portion of the N 1/2, NW 1/4, SE 1/4, Section 29,
T20S., R62E., MDM, Clark County, Nevada

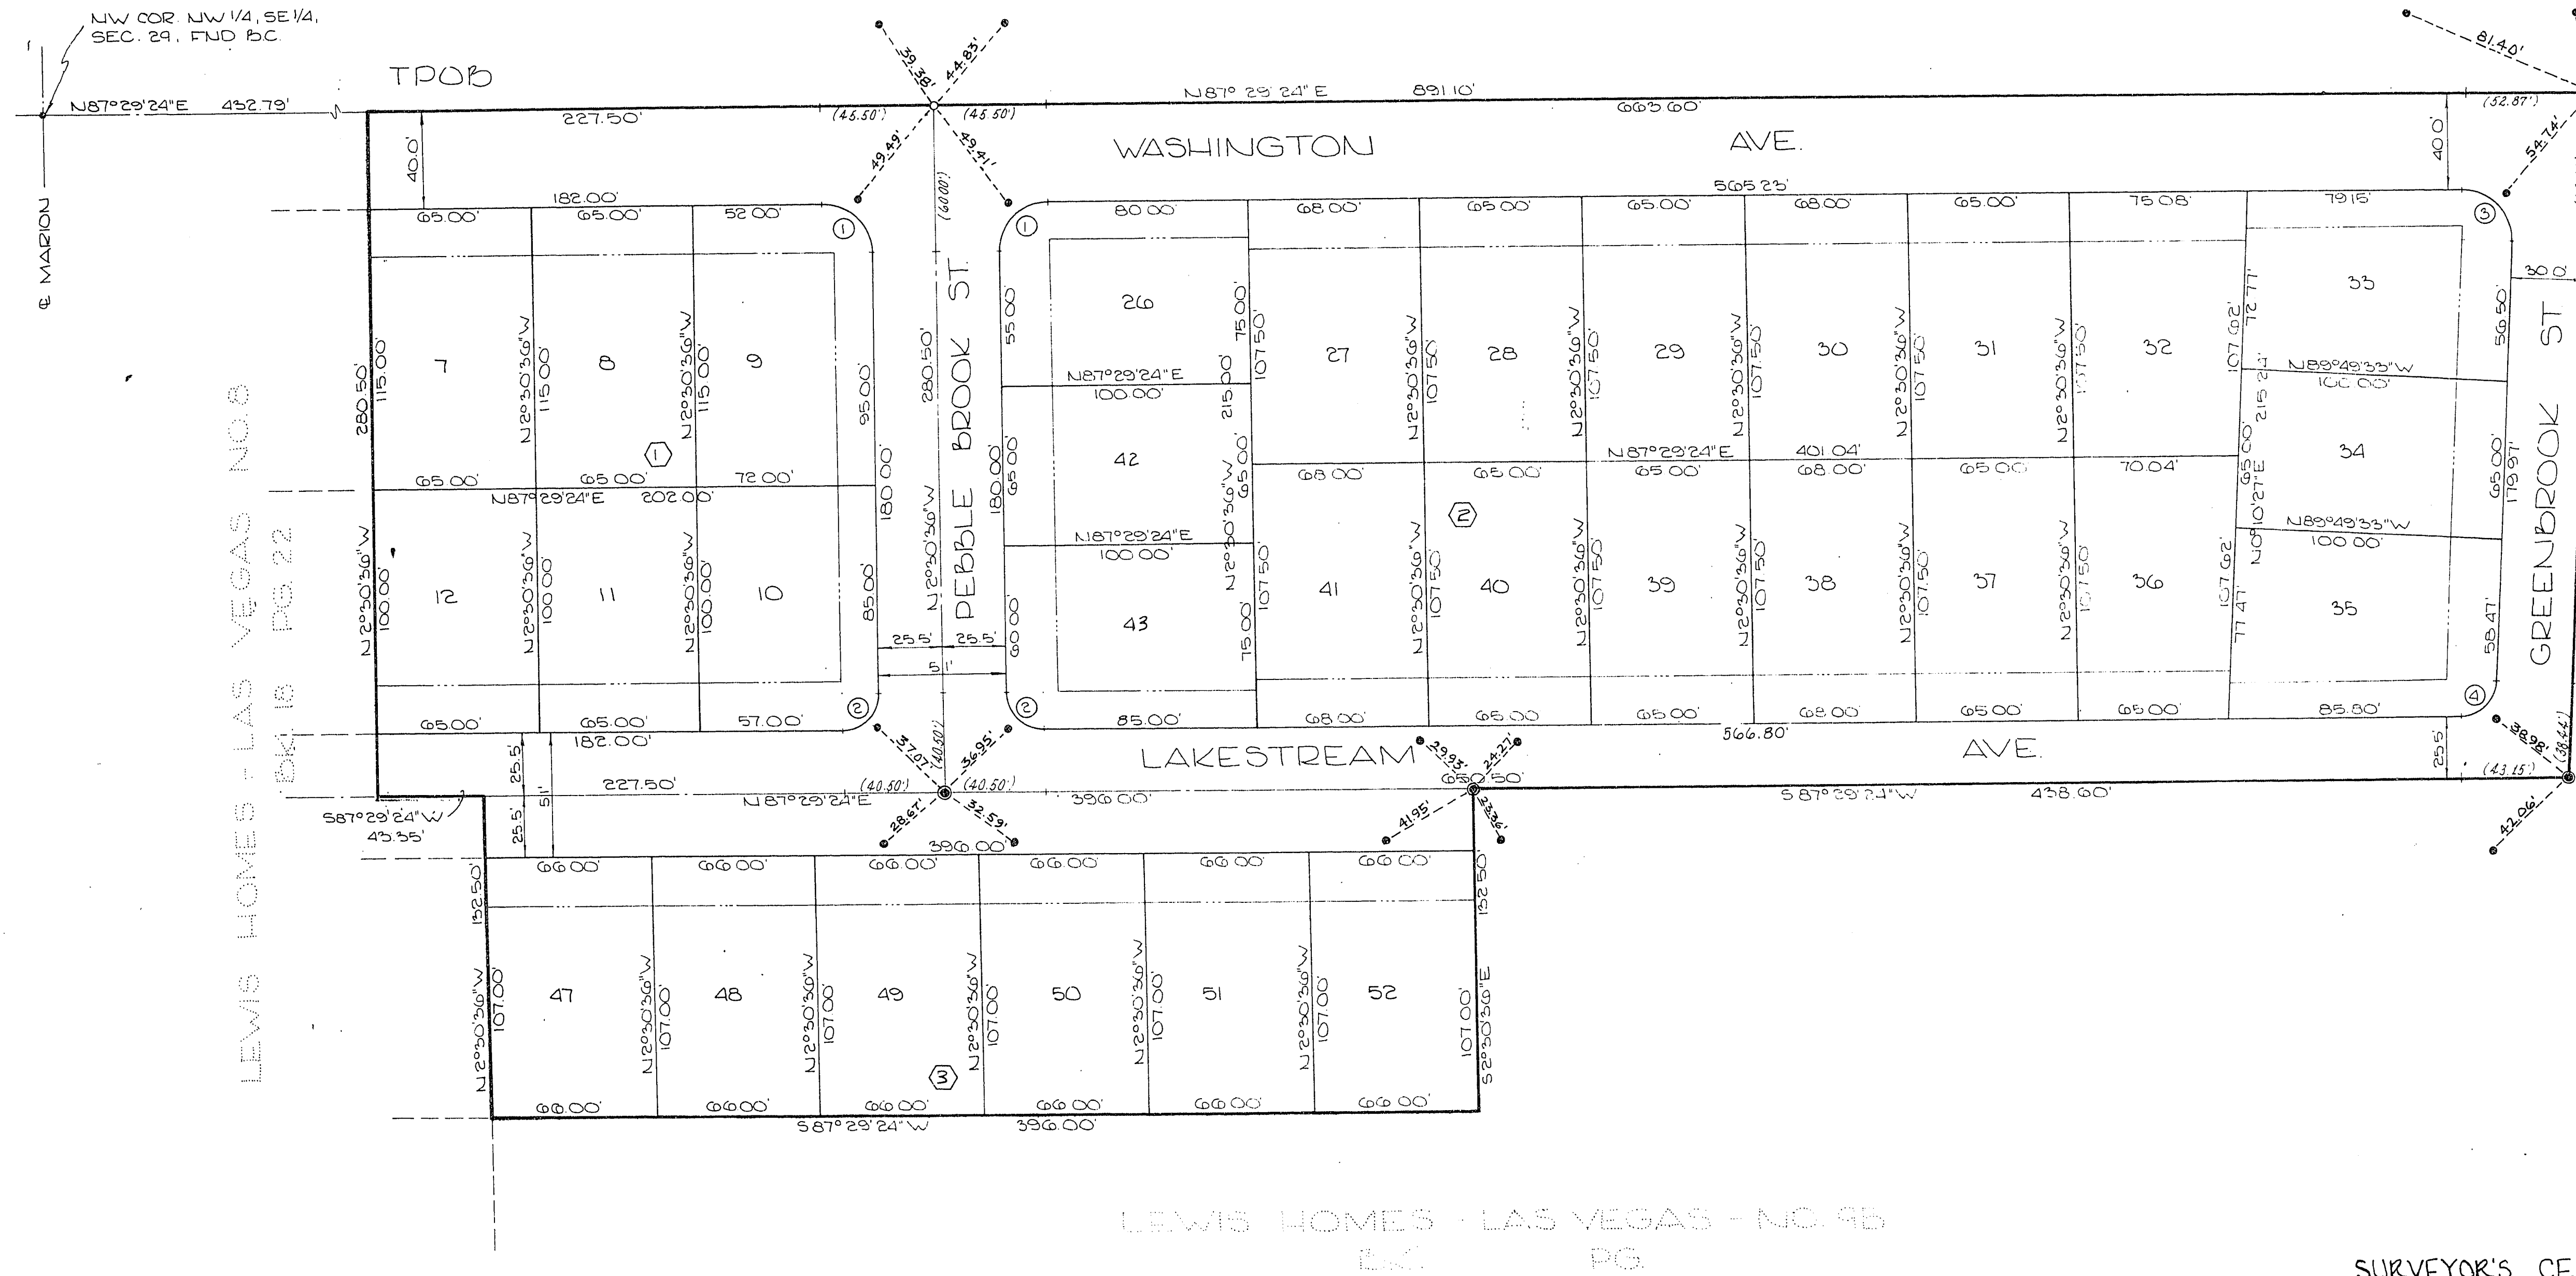

NO	Δ	B	T	L
1	90°00'00"	20.00'	20.00'	31.42'
2	90°00'00"	15.00'	15.00'	23.56'
3	92°41'03"	20.00'	20.36'	32.33'
4	87°18'51"	15.00'	14.31'	22.86'

LEGEND

- 41 LOT NUMBER
- ② BLOCK NUMBER
- ③ CURVE NUMBER
- SET BC IN CONC MON
- BUILDING SETBACK LINE
15' SIDE 20' FRONT
- SET REBAR & ALUM. CAP
- SET LEAD & BRASS NAIL

SURVEYOR'S CERTIFICATE

I, Jerry E. Barnson, a registered land surveyor, do hereby certify that the monuments have been set and the ties established as shown hereon.

Jerry E. Barnson 9/13/77
JERRY E. BARNSON DATE
REG. LAND SURVEYOR
NEV. CERT. # 4046

