





NOTE! UTILITY INFORMATION WAS DERIVED FROM DATA FURNISHED BY UTILITY COMPANIES. CONTRACTOR MUST CONFIRM LOCATION OF UTILITIES BEFORE COMMENCING EXCAVATION.

CURVE DATA				
STATION	R	Δ	L	T
1	138.41'	26° 03' 01"	90.21'	45.90'
2				
3	172.91'	26° 03' 01"	78.62'	40.00'
4				
5	147.41'	26° 03' 01"	67.02'	34.10'
6	10.00'	90° 00' 00"	15.71'	10.00'
7	10.00'	90° 00' 00"	15.71'	10.00'
8	10.00'	90° 00' 00"	15.71'	10.00'
9	10.00'	90° 00' 00"	15.71'	10.00'
10	125.50'	63° 56' 59"		
11	120.50'	63° 56' 59"	111.68'	62.48'
12	100.00'	63° 56' 59"		
13				
14	14.50'	63° 56' 59"	83.15'	46.51'
15	10.00'	90° 00' 00"	15.71'	10.00'
16	10.00'	90° 00' 00"	15.71'	10.00'
17	10.00'			
18	20.00'			
19	25.00'	91° 26' 14"	39.90'	25.64'
20	20.00'			
21	25.00'	88° 38' 46"	38.64'	24.28'
22	100.00'	47° 37' 32"	83.12'	44.13'
23	100.00'	16° 18' 27"	28.49'	14.84'
24				

BENCH MARK: CLV BOLT & PLATE IN TOP OF CURB AT NW CORNER OF LAMB BLVD. & CHARLESTON BLVD. ELEVATION 1752.97'

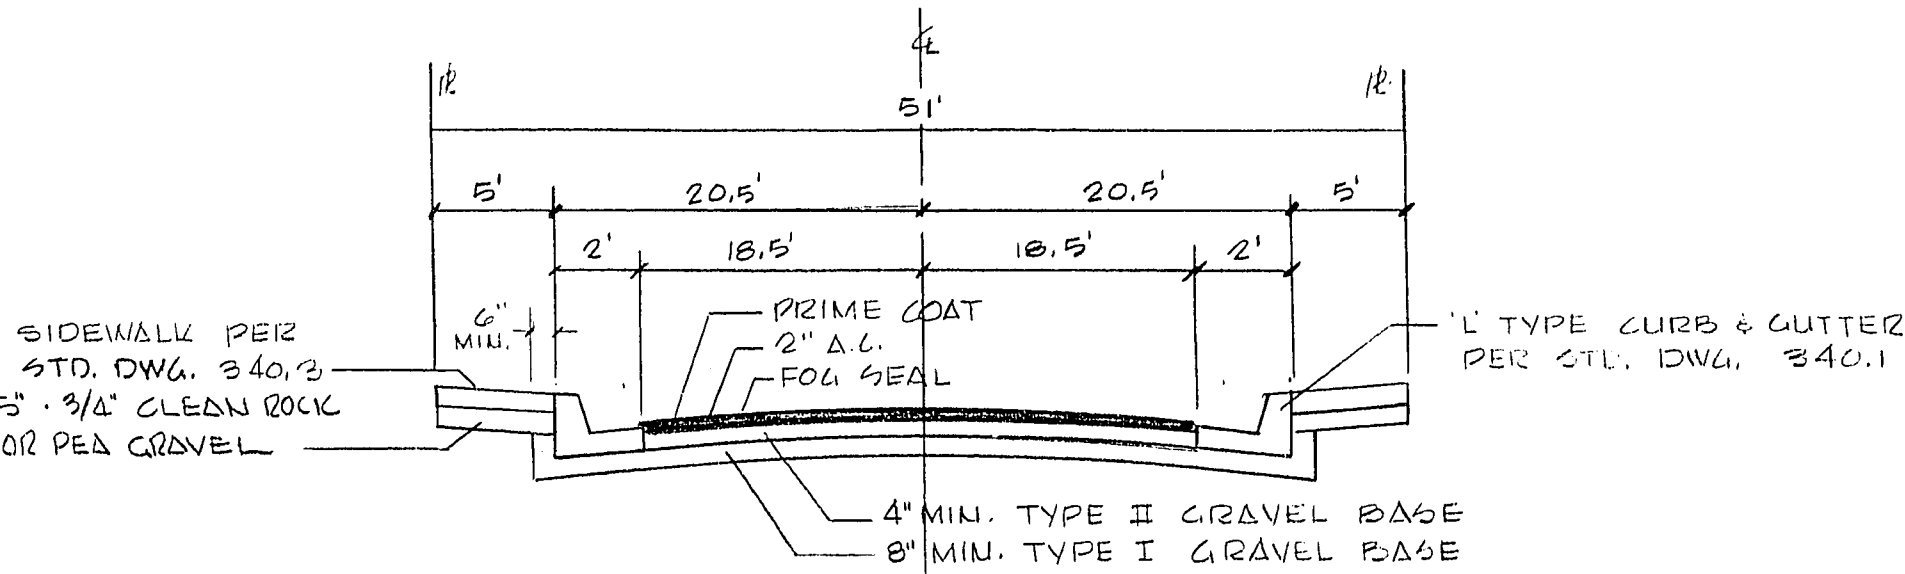

STREET SECTION
MOONLIGHT DRIVE.

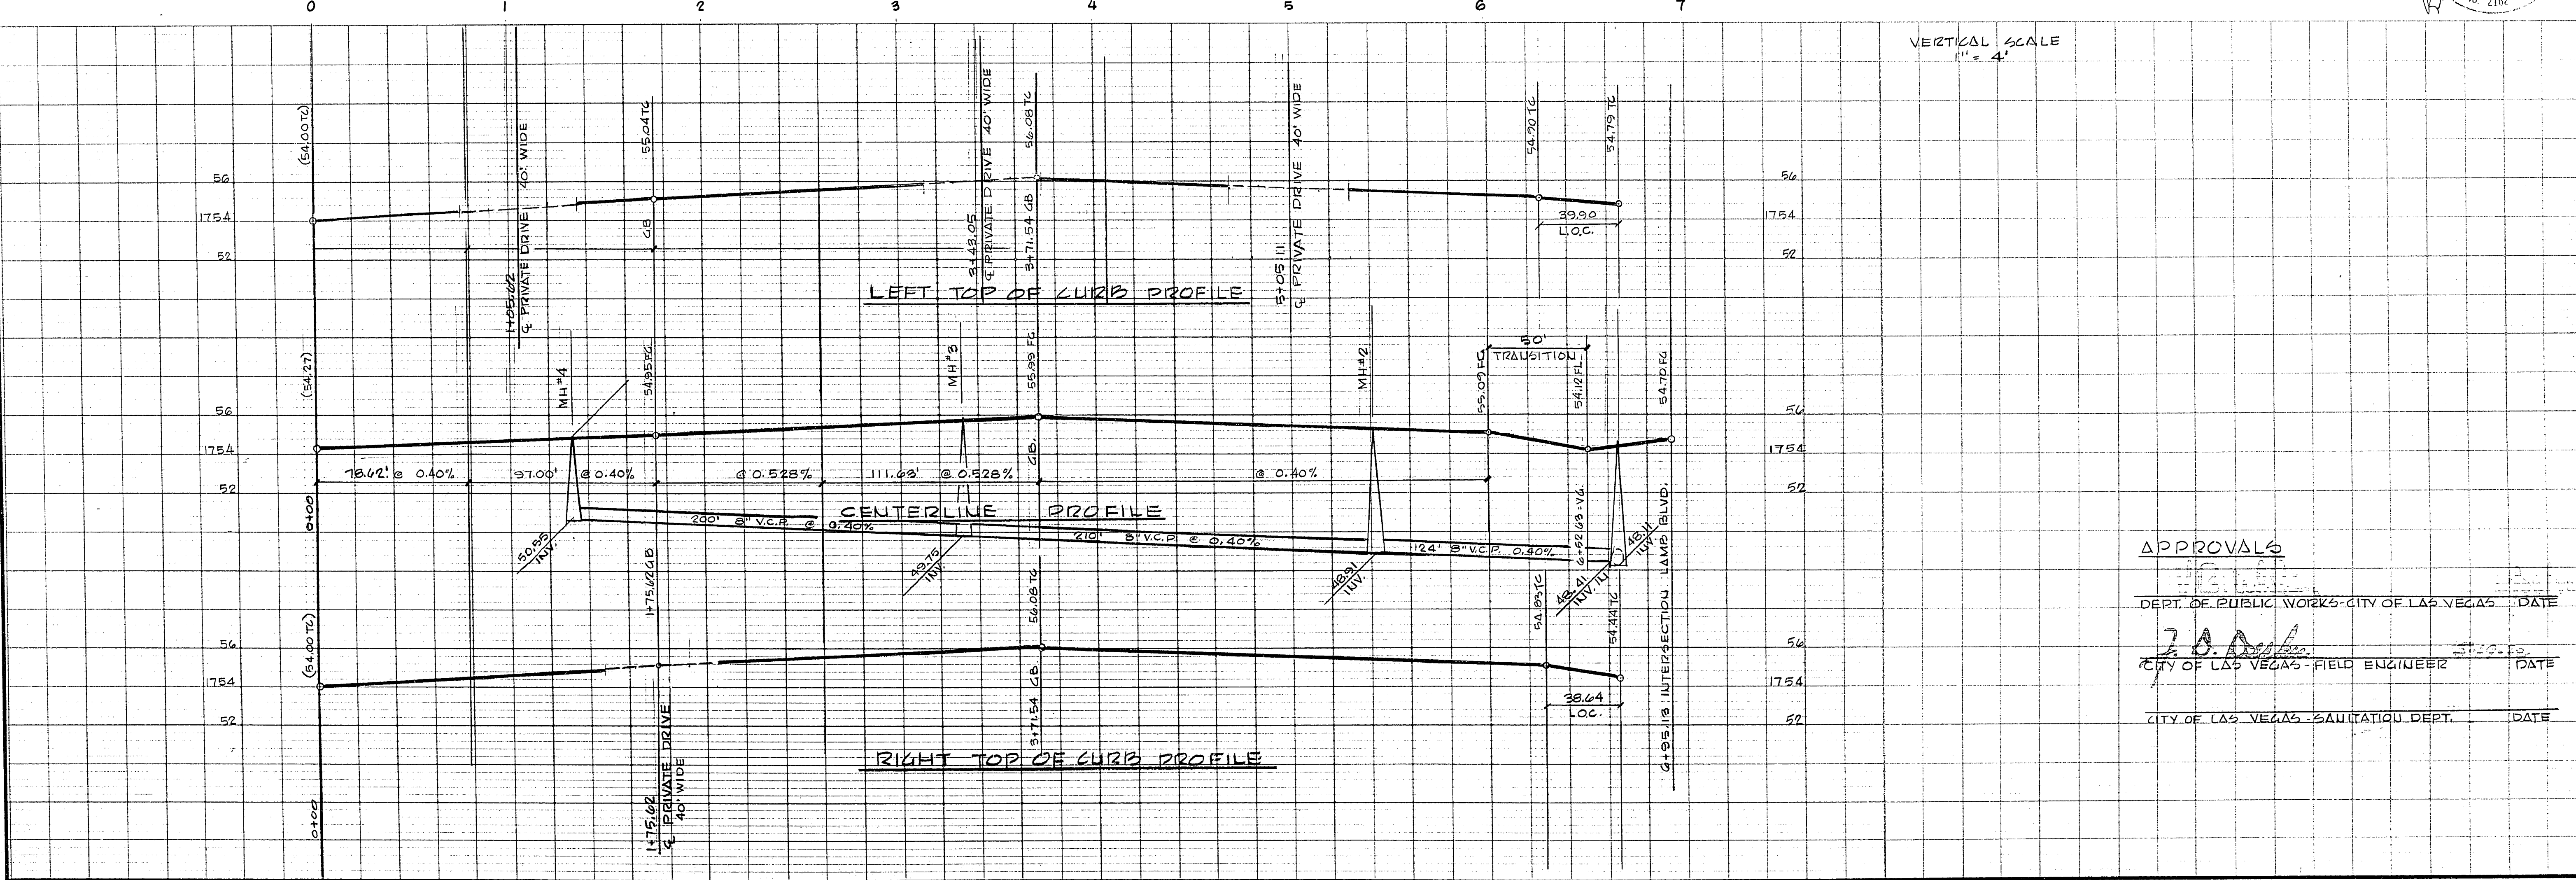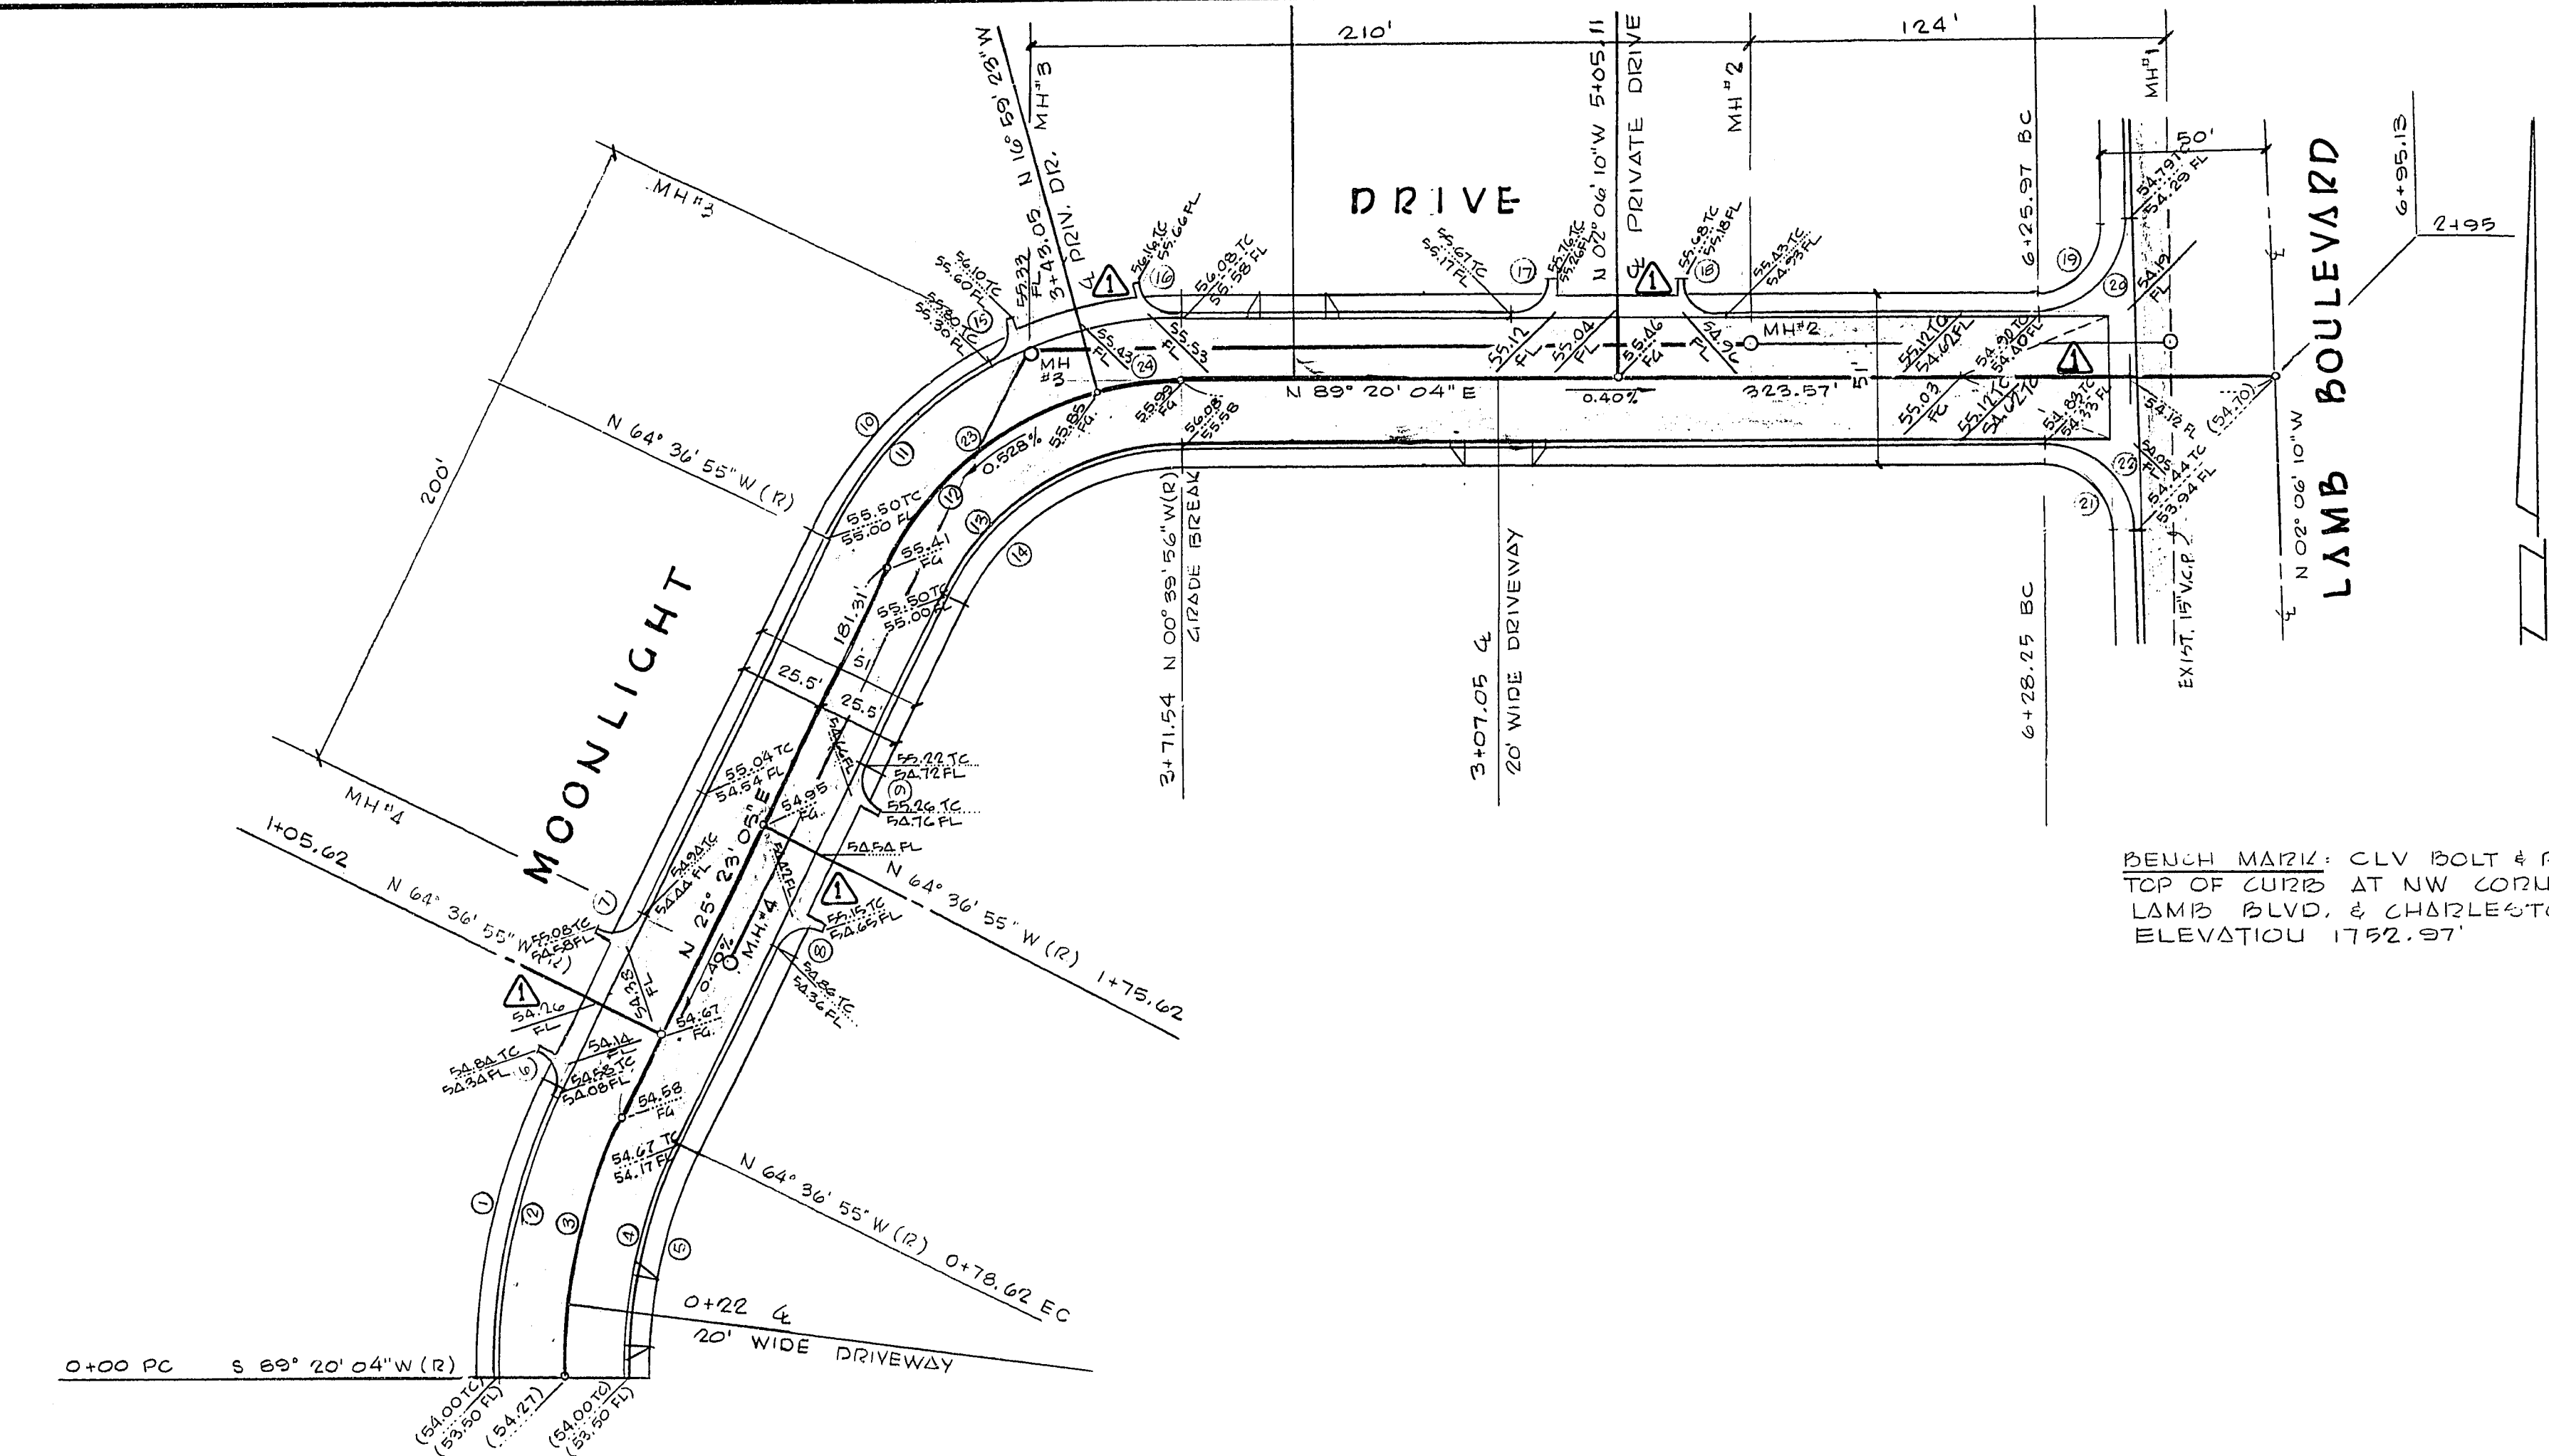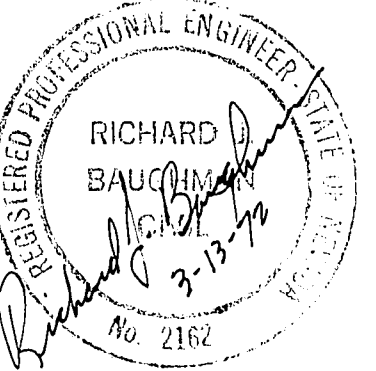


APPROVALS

DEPT. OF PUBLIC WORKS - CITY OF LAS VEGAS DATE

CITY OF LAS VEGAS - FIELD ENGINEER DATE

CITY OF LAS VEGAS - SANITATION DEPT. DATE

BAUGHMAN, HAUGHT & TURNER
CIVIL ENGINEERS
LAND SURVEYORS
2225 WEST CHARLESTON BOULEVARD
LAS VEGAS, NEVADA 89102

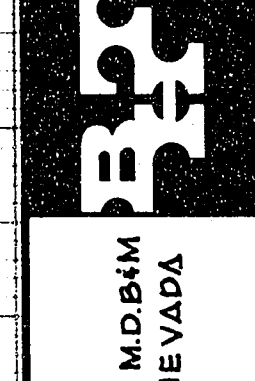

STREET DESIGN
SECTION 31, TOWNSHIP 20 SOUTH, RANGE 62 EAST, MDBM
CITY OF LAS VEGAS
NEVADA
MOONLIGHT DRIVE

SHEET
3
7
PROJ. NO.