

6-6-105

MONUMENT TIE MAP PINWOOD UNIT 2


- Legend**
- 28 LOT NUMBER
 - ⊙ BLOCK NUMBER
 - ⊙ CURVE NUMBER
 - ⊙ R.O.D. MONUMENT AS INDICATED
 - ⊙ SET D/C IN CONC. MONU. RLS 4046
 - ⊙ D.O.G. SET-BACK LINE 30' FRONT / 15' SIDE
 - ◆ SET REBAR W/L CAP, RLS 4046
 - SET BRASS NAIL IN LEAD IN TC, RLS 4046

NO.	Δ	R	L	T
1	100° 23' 10"	640.00	183.05	92.16
2	40° 12' 37"	640.00	47.05	25.55
3	40° 05' 36"	640.00	45.72	22.87
4	40° 05' 07"	640.00	45.26	22.64
5	40° 01' 50"	640.00	45.04	22.52
6	30° 50' 18"	741.00	51.28	25.65
7	30° 50' 18"	741.00	52.99	26.51
8	40° 27' 53"	325.50	53.78	26.95
9	70° 55' 29"	225.50	45.02	22.55
10	50° 25' 02"	225.50	19.72	9.92
11	78° 41' 58"	225.50	103.04	83.27
12	70° 10' 52"	582.00	22.81	11.41
13	70° 48' 51"	982.00	48.23	24.12
14	10° 07' 32"	982.00	13.29	6.65
15	80° 05' 00"	982.00	153.57	109.40
16	90° 00' 00"	15.00	25.56	15.00
17	150° 11' 32"	1082.00	21.76	10.93
18	70° 48' 51"	1082.00	53.14	26.58
19	10° 19' 52"	1082.00	75.14	12.57
20	80° 05' 00"	1082.00	152.68	76.47
21	30° 25' 02"	425.50	25.13	12.57
22	70° 55' 29"	425.50	58.85	29.47
23	80° 52' 29"	425.50	65.91	33.07
24	78° 00' 29"	425.50	208.74	106.52
25	99° 00' 28"	15.00	25.95	17.60
26	82° 24' 11"	15.00	21.57	13.13
27	40° 39' 24"	476.50	58.73	19.37
28	60° 00' 03"	476.50	49.91	24.98
29	0° 57' 32"	476.50	7.96	3.99
30	70° 57' 08"	476.50	246.33	125.99
31	30° 00' 16"	451.00	268.45	158.33
32	70° 10' 16"	1133.00	42.93	21.47
33	20° 35' 03"	1133.00	51.10	25.56
34	00° 44' 44"	1133.00	14.74	7.57
35	80° 05' 06"	1133.00	159.88	80.07
36	80° 05' 06"	1107.50	156.28	78.27
37	00° 44' 44"	1233.00	16.05	8.02
38	70° 35' 03"	1233.00	55.61	27.81
39	70° 10' 16"	1233.00	46.72	23.36
40	80° 05' 06"	1233.00	175.99	87.14
41	00° 57' 32"	576.50	9.65	4.82
42	60° 00' 03"	576.50	60.38	30.22
43	70° 16' 49"	576.50	73.25	36.68
44	30° 14' 53"	576.50	324.42	166.63
45	18° 31' 28"	960.00	310.38	156.50
46	00° 21' 51"	960.00	6.10	3.05
47	70° 41' 14"	960.00	45.05	22.52
48	70° 41' 38"	960.00	45.14	22.57
49	70° 42' 25"	960.00	45.36	22.68
50	40° 10' 55"	960.00	70.07	35.05
51	50° 55' 25"	960.00	98.69	49.34
52	00° 24' 24"	860.00	6.10	3.05
53	30° 00' 03"	860.00	45.05	22.52
54	30° 00' 54"	860.00	45.17	22.59
55	10° 08' 14"	860.00	17.07	8.54
56	70° 35' 12"	860.00	113.57	56.77
57	75° 07' 03"	25.00	10.96	5.57
58	14° 22' 25"	70.00	17.56	8.85
59	26° 56' 42"	70.00	32.51	16.56
60	30° 26' 35"	70.00	57.19	19.05
61	30° 26' 36"	70.00	37.19	19.05
62	32° 13' 05"	70.00	39.36	20.22
63	134° 09' 21"	70.00	163.82	105.27
64	26° 01' 30"	25.00	11.57	5.89
65	10° 44' 59"	25.00	4.69	2.35
66	15° 40' 31"	25.00	6.88	3.46
67	12° 50' 19"	300.00	67.22	33.75
68	12° 50' 19"	300.00	73.95	37.13
69	12° 50' 19"	270.00	60.50	30.38
70	60° 45' 57"	330.00	38.97	19.51
71	60° 44' 22"	330.00	34.98	17.51
72	70° 17' 10"	270.00	10.77	5.39
73	90° 36' 02"	270.00	45.23	22.69
74	5° 40' 12"	270.00	26.72	13.37
75	70° 10' 07"	270.00	63.78	16.91
76	30° 50' 03"	330.00	22.08	11.08
77	9° 00' 16"	330.00	51.86	25.98
78	81° 05' 33"	25.00	35.08	21.39
79	12° 10' 19"	800.00	176.33	88.50
80	50° 40' 58"	800.00	79.35	39.71
81	3° 03' 29"	800.00	45.03	22.52
82	80° 54' 27"	800.00	124.38	62.31
83	80° 57' 28"	25.00	34.25	24.98
84	90° 02' 32"	25.00	39.24	25.02
85	00° 56' 37"	270.00	4.45	2.22

SURVEYOR'S CERTIFICATE
 I, JERRY E. BARNESON, A REGISTERED LAND SURVEYOR, DO HEREBY CERTIFY THAT THE MONUMENTS HAVE BEEN SET AND THE TIES ESTABLISHED AS SHOWN HEREON.

JERRY E. BARNESON
 REG. LAND SURVEYOR
 NEV. CERT. NO. 4046

DATE

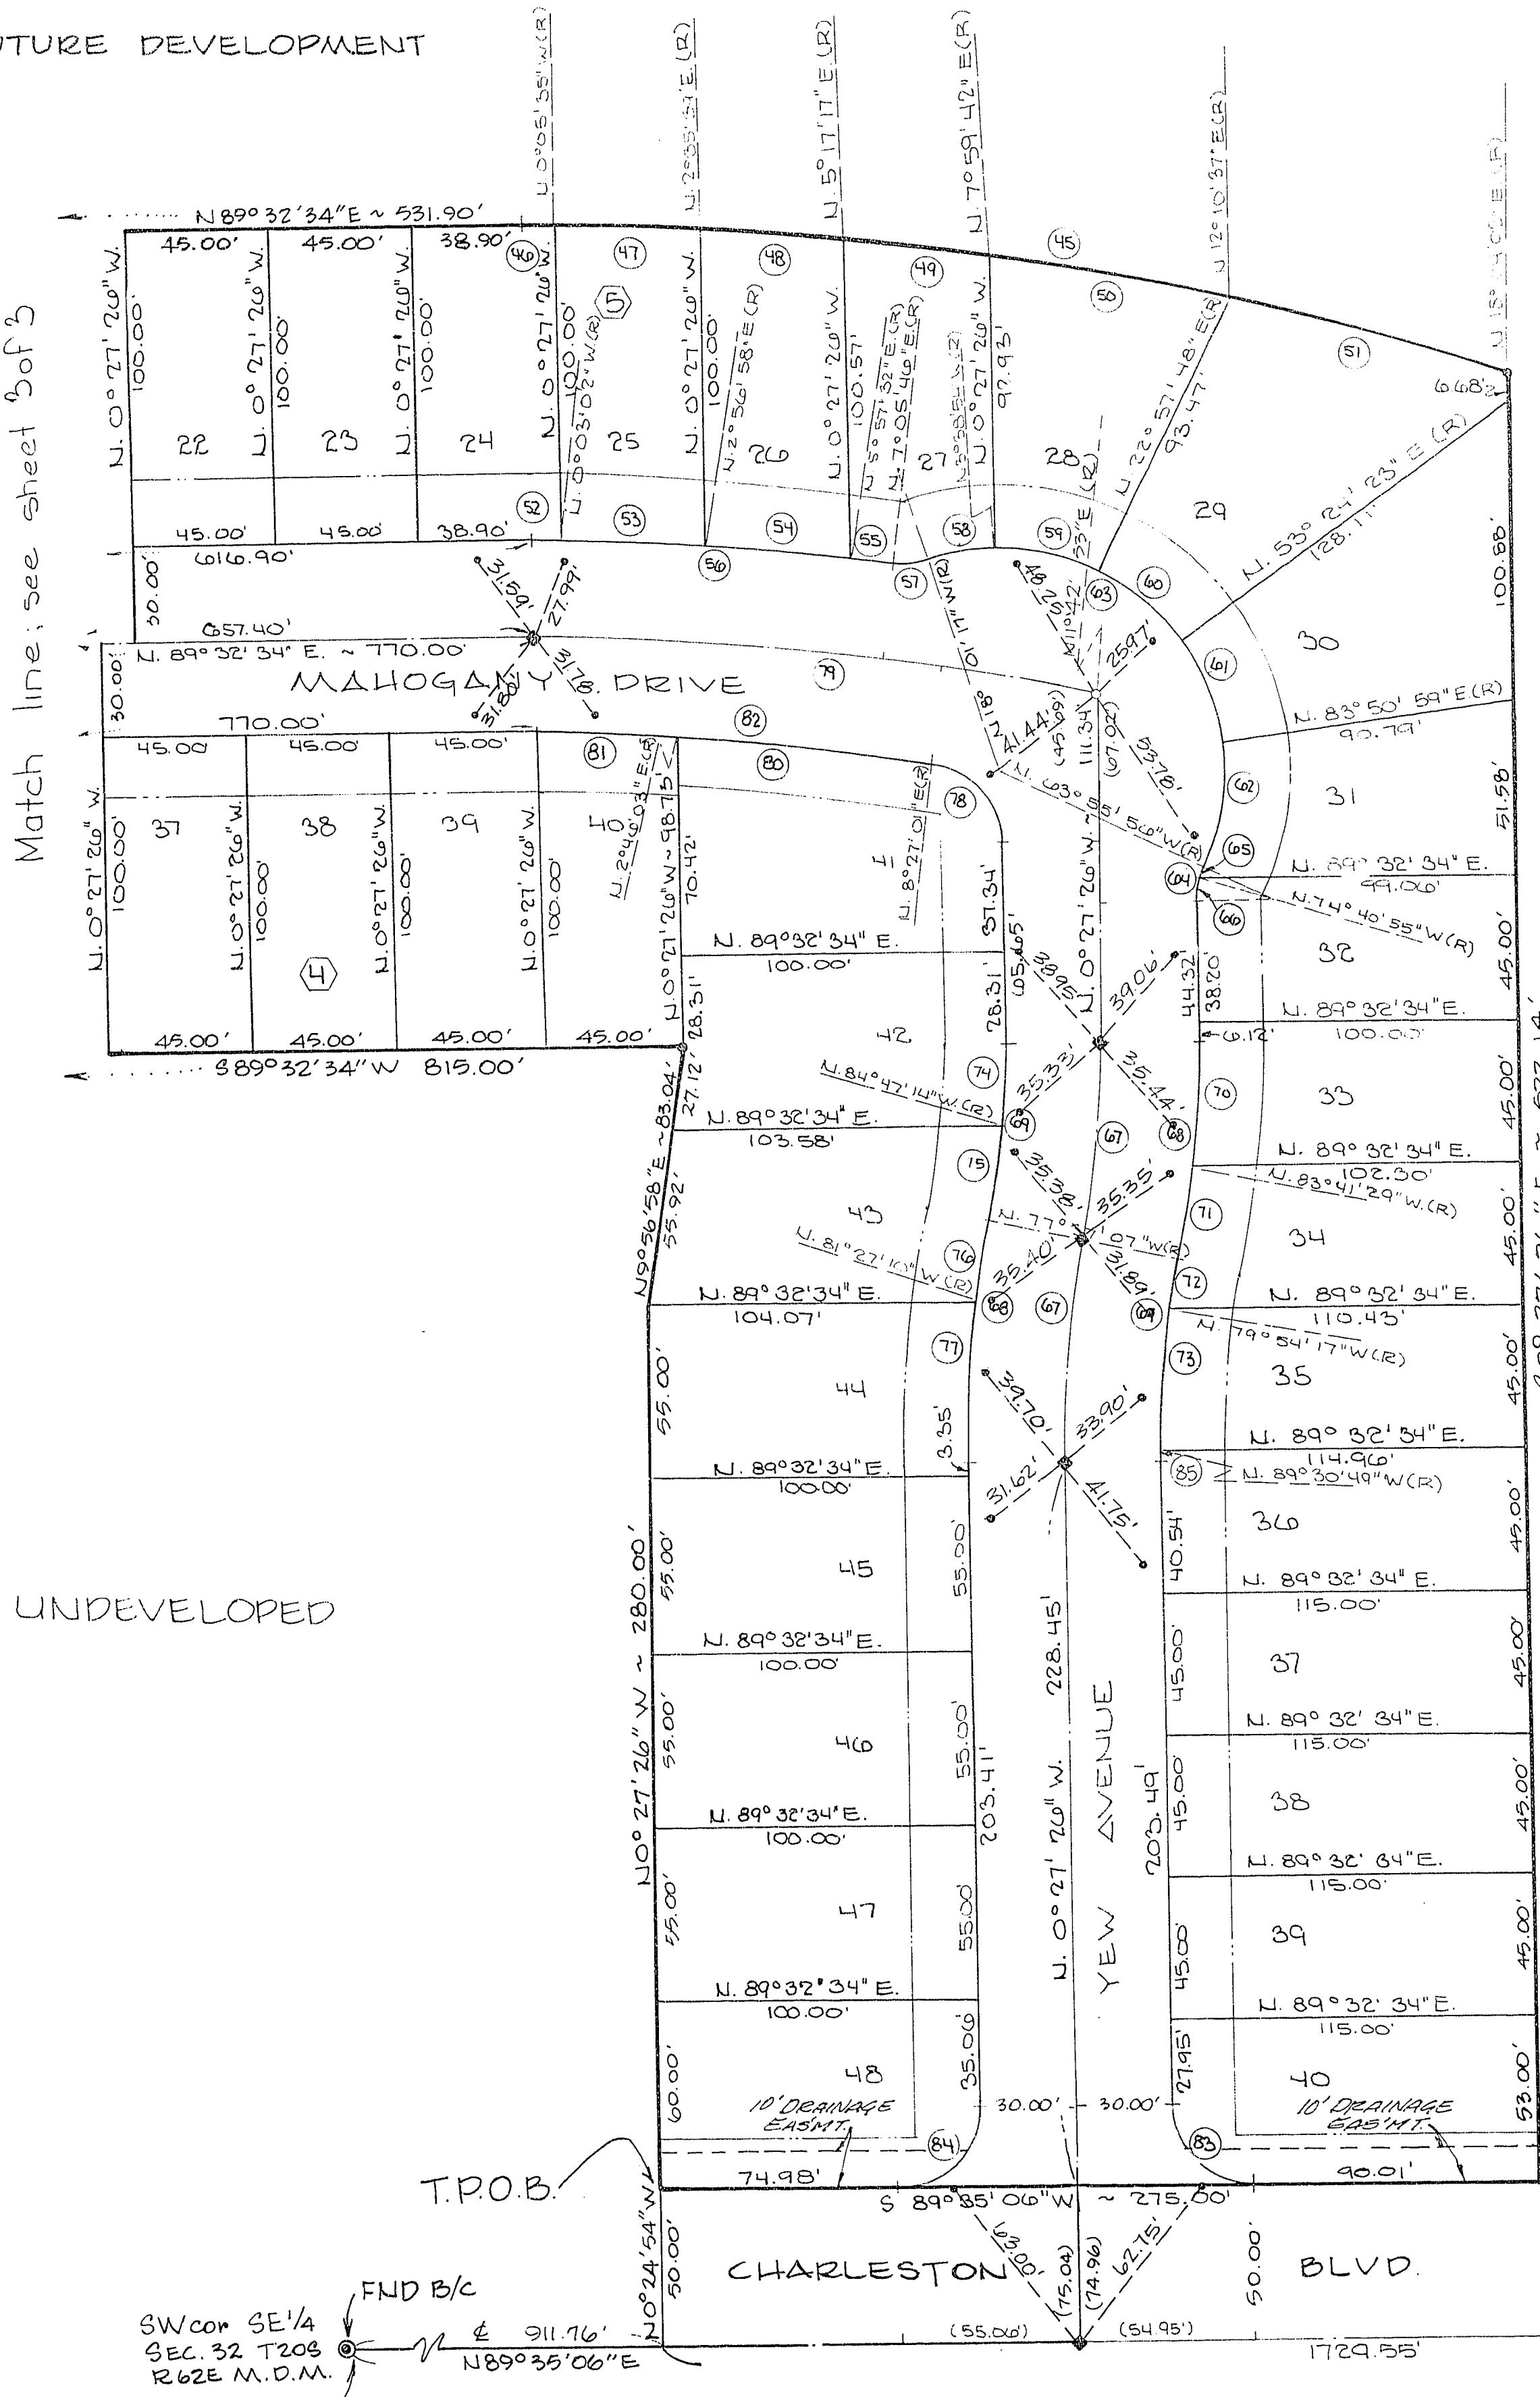

FUTURE DEVELOPMENT

UNDEVELOPED

SW cor. SE 1/4
 SEC. 32 T20S
 R62E M.O.M.
 FND B/C
 911.16'
 N89°35'06"E

SE cor., Sec. 32
 Fnd. B/C