6-6-123

PINEWOOD - UNIT No. 3

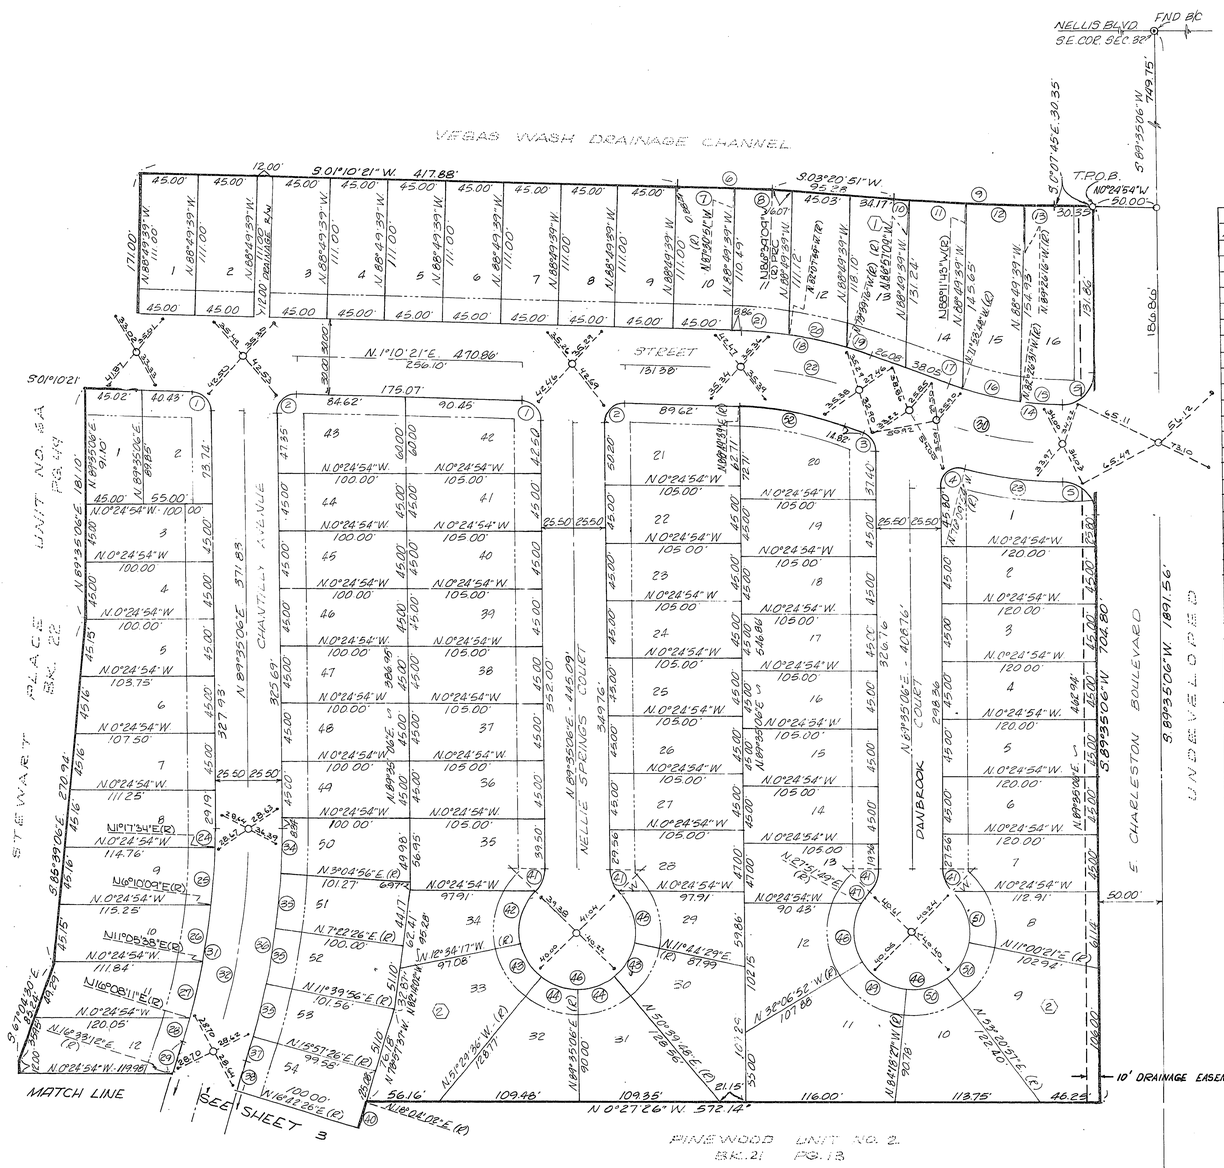

LEGEND

10 LOT NUMBER
(7) BLOCK NUMBER
(7) CURVE NUMBER
BUILDING SETBACK LINE
20' FRONT YARD
15' BACK YARD
BRASS CAP IN CURB
BRASS NAIL IN LEAD
O SET REBAR W/AL. CAP - R.L.S. # 4046
● CONCRETE MONUMENT

CURVE DATA				
NO	Δ	R	L.	T.
1	88°24'45"	15.00'	23.15'	14.59'
2	91°35'15"	15.00'	23.98'	15.42'
3	69°18'08"	15.00'	18.14'	10.37'
4	104°15'00"	15.00'	27.29'	19.29'
5	90°00'00"	25.00'	39.27'	25.00'
6	2°10'30"	1925.00'	73.08'	36.54'
7	1°18'48"	1925.00'	44.12'	22.06'
8	0°51'42"	1925.00'	28.95'	14.48'
9	3°28'36"	2075.00'	125.91'	62.97'
10	0°18'00"	2075.00'	10.86'	5.43'
11	1°14'34"	2075.00'	45.01'	22.50'
12	1°14'33"	2075.00'	45.00'	22.50'
13	0°41'29"	2075.00'	25.04'	12.52'
14	20°41'52"	250.00'	90.31'	45.65'
15	7°58'23"	250.00'	34.79'	17.42'
16	10°32'43"	250.00'	46.01'	23.07'
17	2°10'46"	250.00'	9.51'	4.76'
18	19°06'37"	310.00'	103.40'	52.18'
19	3°56'14"	310.00'	21.30'	10.66'
20	8°28'43"	310.00'	45.87'	22.98'
21	6°41'40"	310.00'	36.22'	18.13'
22	19°06'37"	280.00'	93.39'	47.13'
23	14°15'00"	310.00'	77.10'	38.75'
24	1°42'28"	530.29'	15.81'	7.90'
25	4°52'35"	530.29'	45.13'	22.58'
26	4°55'29"	530.29'	45.58'	22.80'
27	5°02'33"	530.29'	46.67'	23.35'
28	1°55'51"	530.29'	17.87'	8.94'
29	1°30'50"	1111.00'	29.36'	14.68'
30	20°41'52"	280.00'	101.15'	51.13'
31	18°28'56"	530.29'	171.06'	86.28'
32	18°28'56"	555.79'	179.28'	90.43'
34	3°29'50"	581.29'	35.48'	17.75'
35	4°17'30"	581.29'	43.54'	21.78'
36	18°28'56"	581.29'	187.51'	94.58'
37	2°06'36"	581.29'	21.41'	10.70'
38	1°21'36"	1060.00'	25.16'	12.58'
40	1°21'36"	960.00'	22.79'	11.39'
41	44°14'57"	25.00'	19.31'	10.16'
42	56°24'20"	45.50'	44.79'	24.40'
43	38°55'19"	45.50'	30.91'	16.08'
44	38°55'18"	45.50'	30.91'	16.08'
45	56°24'20"	45.50'	44.79'	24.40'
46	268°29'54"	45.50'	213.22'	∞
47	15°58'14"	45.50'	12.68'	6.38'
48	59°58'41"	45.50'	47.63'	26.26'
49	52°11'35"	45.50	41.45'	22.29'
50	42°20'36"	45.50'	33.63'	17.62'
51	55°40'12"	45.50'	44.21'	24.02'
52	19°06'37"	250.00'	83.38'	42.08'

SURVEYOR'S CERTIFICATE

I, JERRY E. BARNSON, A REGISTERED LAND SURVEYOR, DO HEREBY CERTIFY THAT THE MONUMENTS HAVE BEEN SET AND THE TIES ESTABLISHED AS SHOWN HEREON.

Jerry E. Barnson 9/1/86
JERRY E. BARNSON, R.L.S. DATE
NEVADA CERTIFICATE NO. 4046

S.W. COR., S.E. 1/4 SEC 32
T.20S., R.62E., M.D.M.
FND. B/C

NORTH
1" = 50'

SHEET 2 of 3

PINE UL 3

088-2495-3