



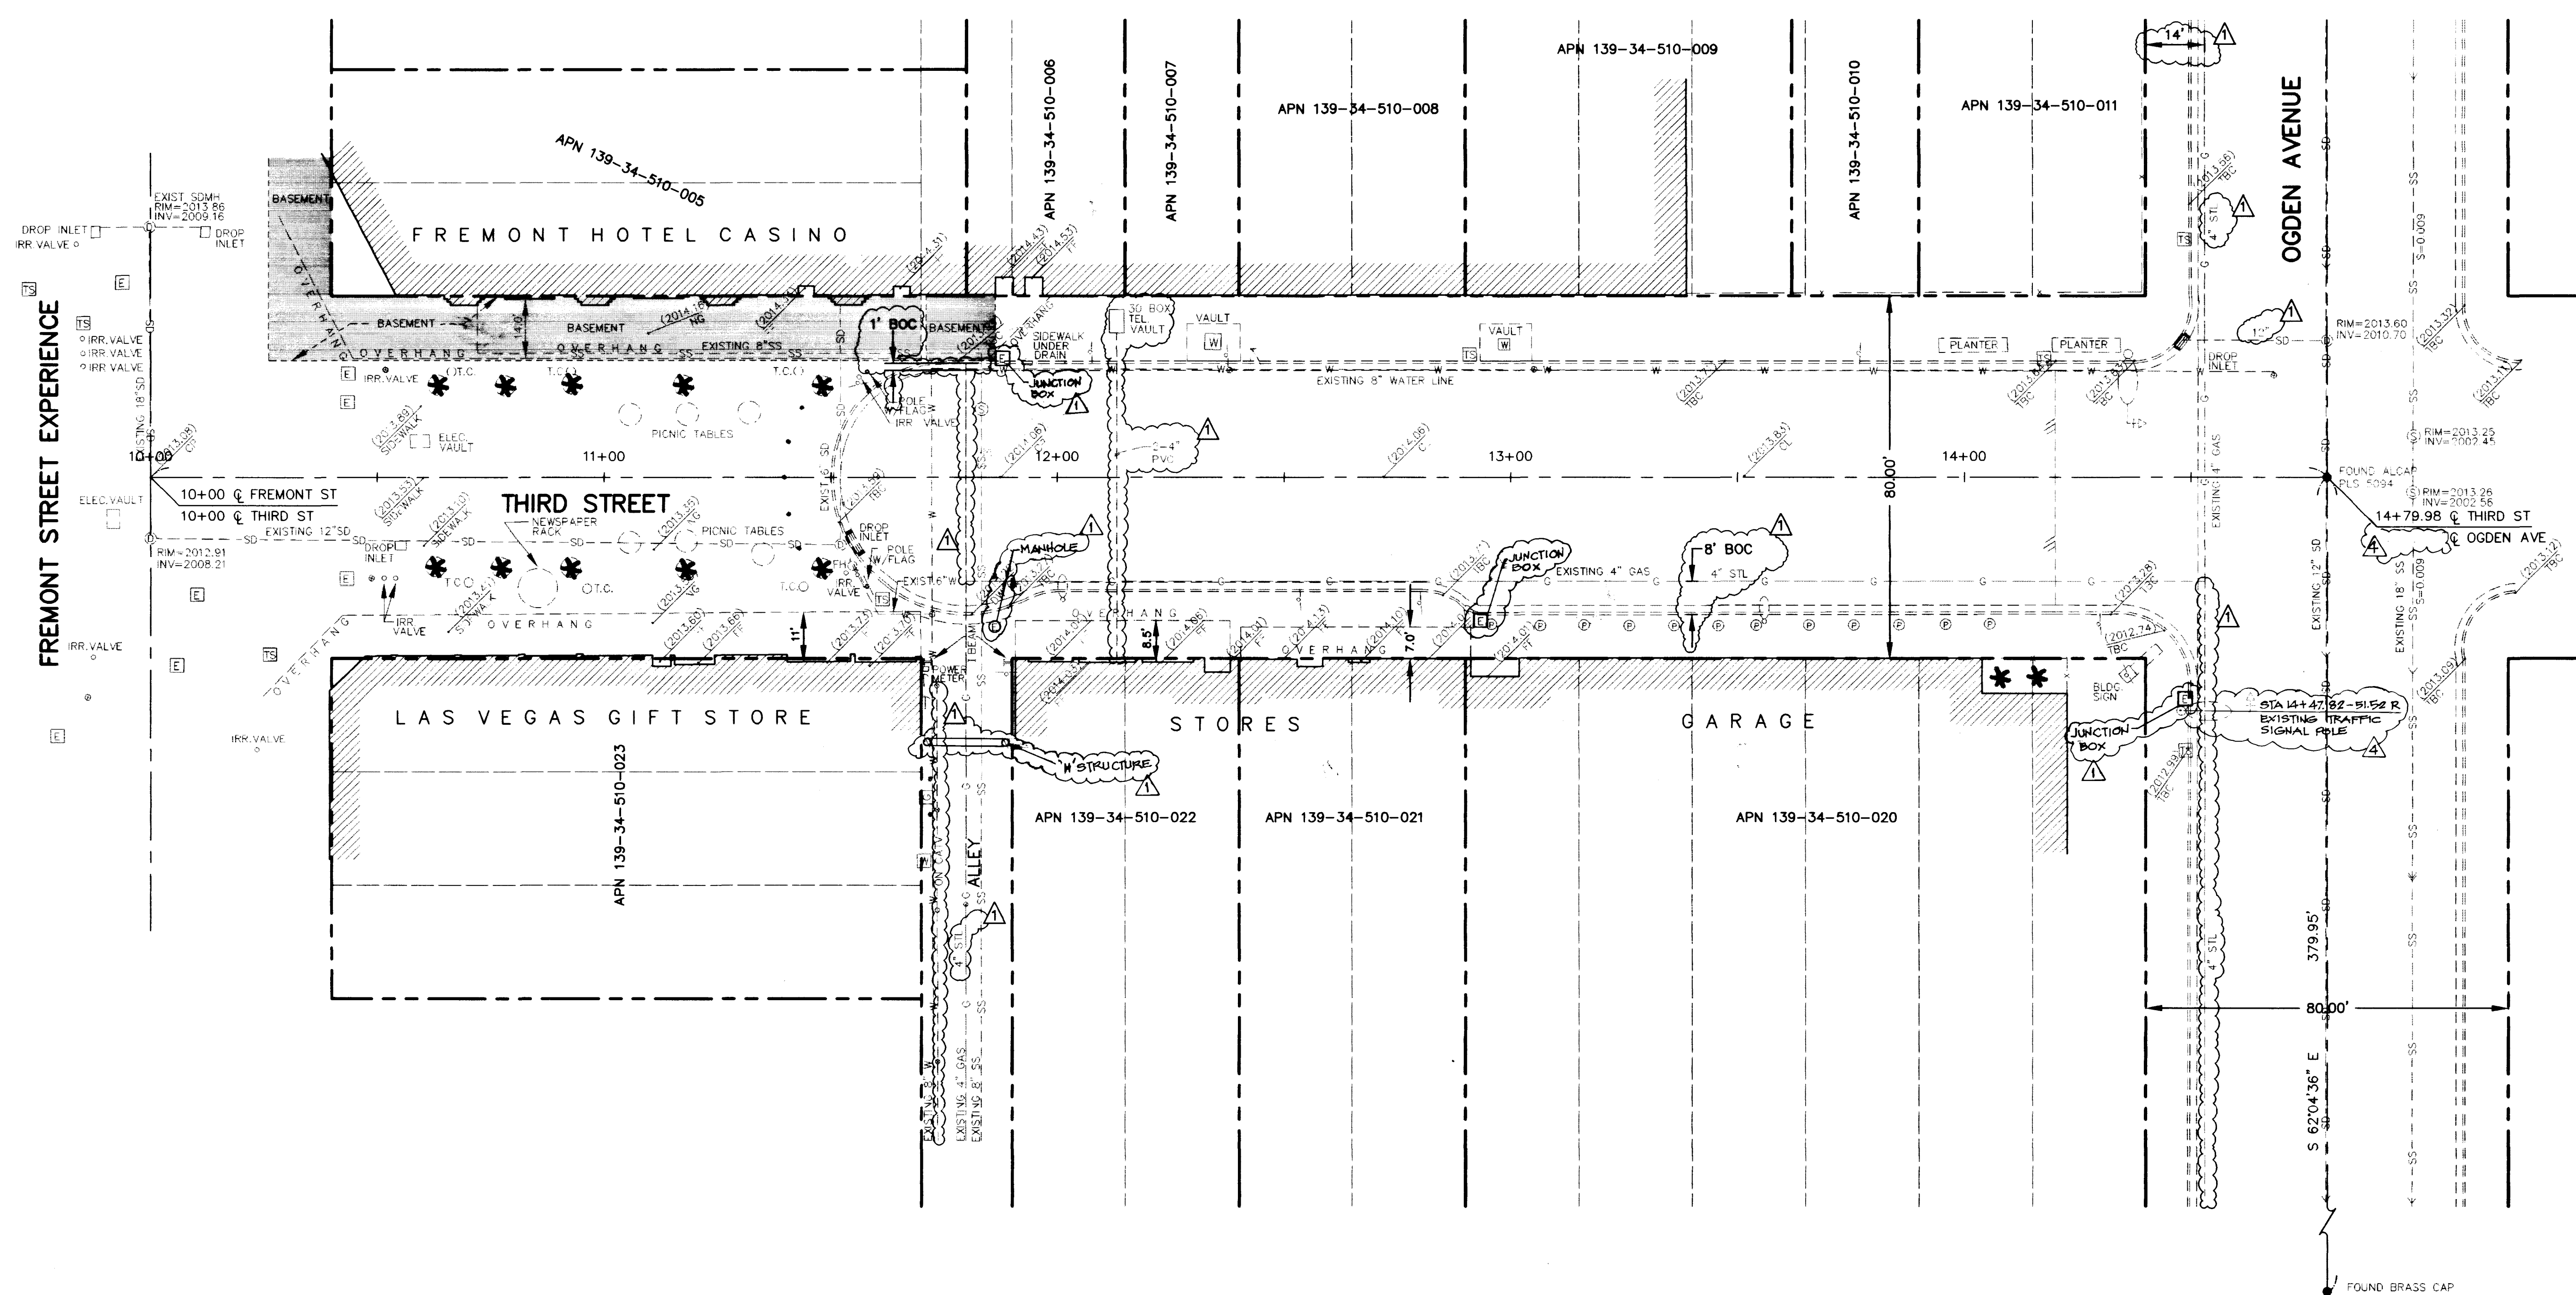

EXISTING UTILITIES ARE SHOWN ON THIS PLAN FROM THE BEST AVAILABLE INFORMATION. INFORMATION. POGGEMEYER DESIGN GROUP ASSUMES ON RESPONSIBILITY FOR UTILITY LOCATIONS AND ELEVATIONS. FIELD VERIFY ALL EXISTING UTILITY LOCATIONS AND ELEVATIONS AND IMMEDIATELY NOTIFY ENGINEER IN WRITING OF ANY VARIATIONS BETWEEN THE EXISTING UTILITIES SHOWN HERON AND FIELD CONDITIONS.

BEING THE CENTERLINE OF THIRD STREET BETWEEN FREMONT STREET AND
ODGEN AVENUE. TAKEN AS SOUTH 27°54'33" WEST PER RECORD OF SURVEY
FILE 67, PAGE 79.

FREMONT 5, RIVET AND PLATE IN TOP OF CURB NORTHEAST RETURN FREMONT STREET AND LAS VEGAS BOULEVARD. ELEVATION 2007.32 FEET. (611.8322 METERS)

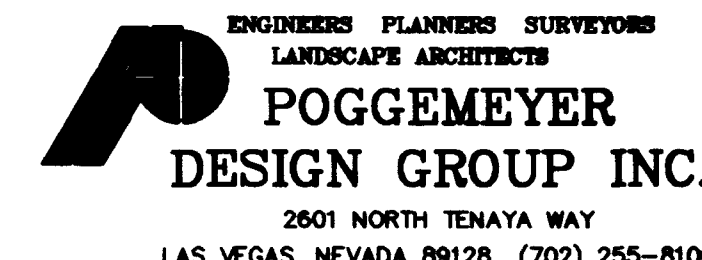

0	ISSUED FOR CONSTRUCTION	00/00/00
REV No:	NOTE	DATE
1	REQUIRED FOR UTILITY/CITY APPROVAL	05/08/98
4	CLARIFICATION REQUESTED BY CITY ENGINEER	06/09/98

SCALE: AS NOTED
SHEET 2 OF 24
DRAWING No:
C2.01

THIS DOCUMENT DOES NOT DESCRIBE AN INSTALLABLE SYSTEM UNTIL IT IS PROVIDED WITH THE NECESSARY COMPLEMENTARY COMPLIANCE WITH CONSTRUCTION STANDARDS BY A CERTIFIED ENGINEER. ALTHOUGH EVERY EFFORT HAS BEEN MADE TO PRODUCE A COMPLETE AND CODE-COMPLIANT DESIGN "FREMONT STREET EXPERIENCE LLC." SPECIFICALLY DISCLAIMS ANY RESPONSIBILITY FOR CODE COMPLIANCE. THESE DRAWINGS AND THE CONCEPTS THEY REPRESENT ARE THE EXCLUSIVE PROPERTY OF FREMONT STREET EXPERIENCE LLC. ANY REPRODUCTION OF THESE DRAWINGS OR ANY PART THEREOF DISCUSSED IN THE PROPERTY CONFERENCE AND SHALL NOT BE REPRODUCED, COPIED OR USED IN ANY PART WITHOUT PRIOR WRITTEN PERMISSION OF FREMONT STREET EXPERIENCE LLC.

FREMONT STREET EXPERIENCE


425 FREMONT STREET, LAS VEGAS, NV. 89101
TEL: (702) 678-5600 FAX: (702) 678-5611

JOB No:	98046C
DESIGNED BY:	JJD
DRAWN BY:	DRF
DATE:	4.29.98
FILE NAME:	C201-TOPO

PROJECT TITLE:
FREMONT STREET EXPERIENCE
3rd STREET MALL EXPANSION

SHEET TITLE:

TOPOGRAPHIC SURVEY

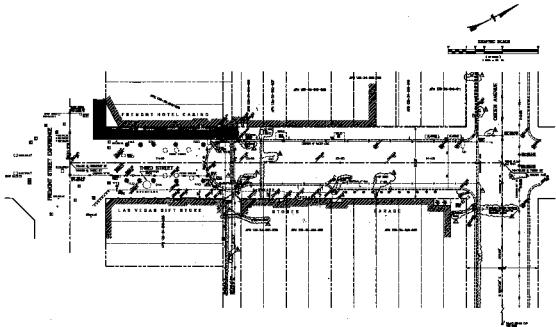

11















**FREMONT STREET
EXPERIENCE**


[illegible]













