
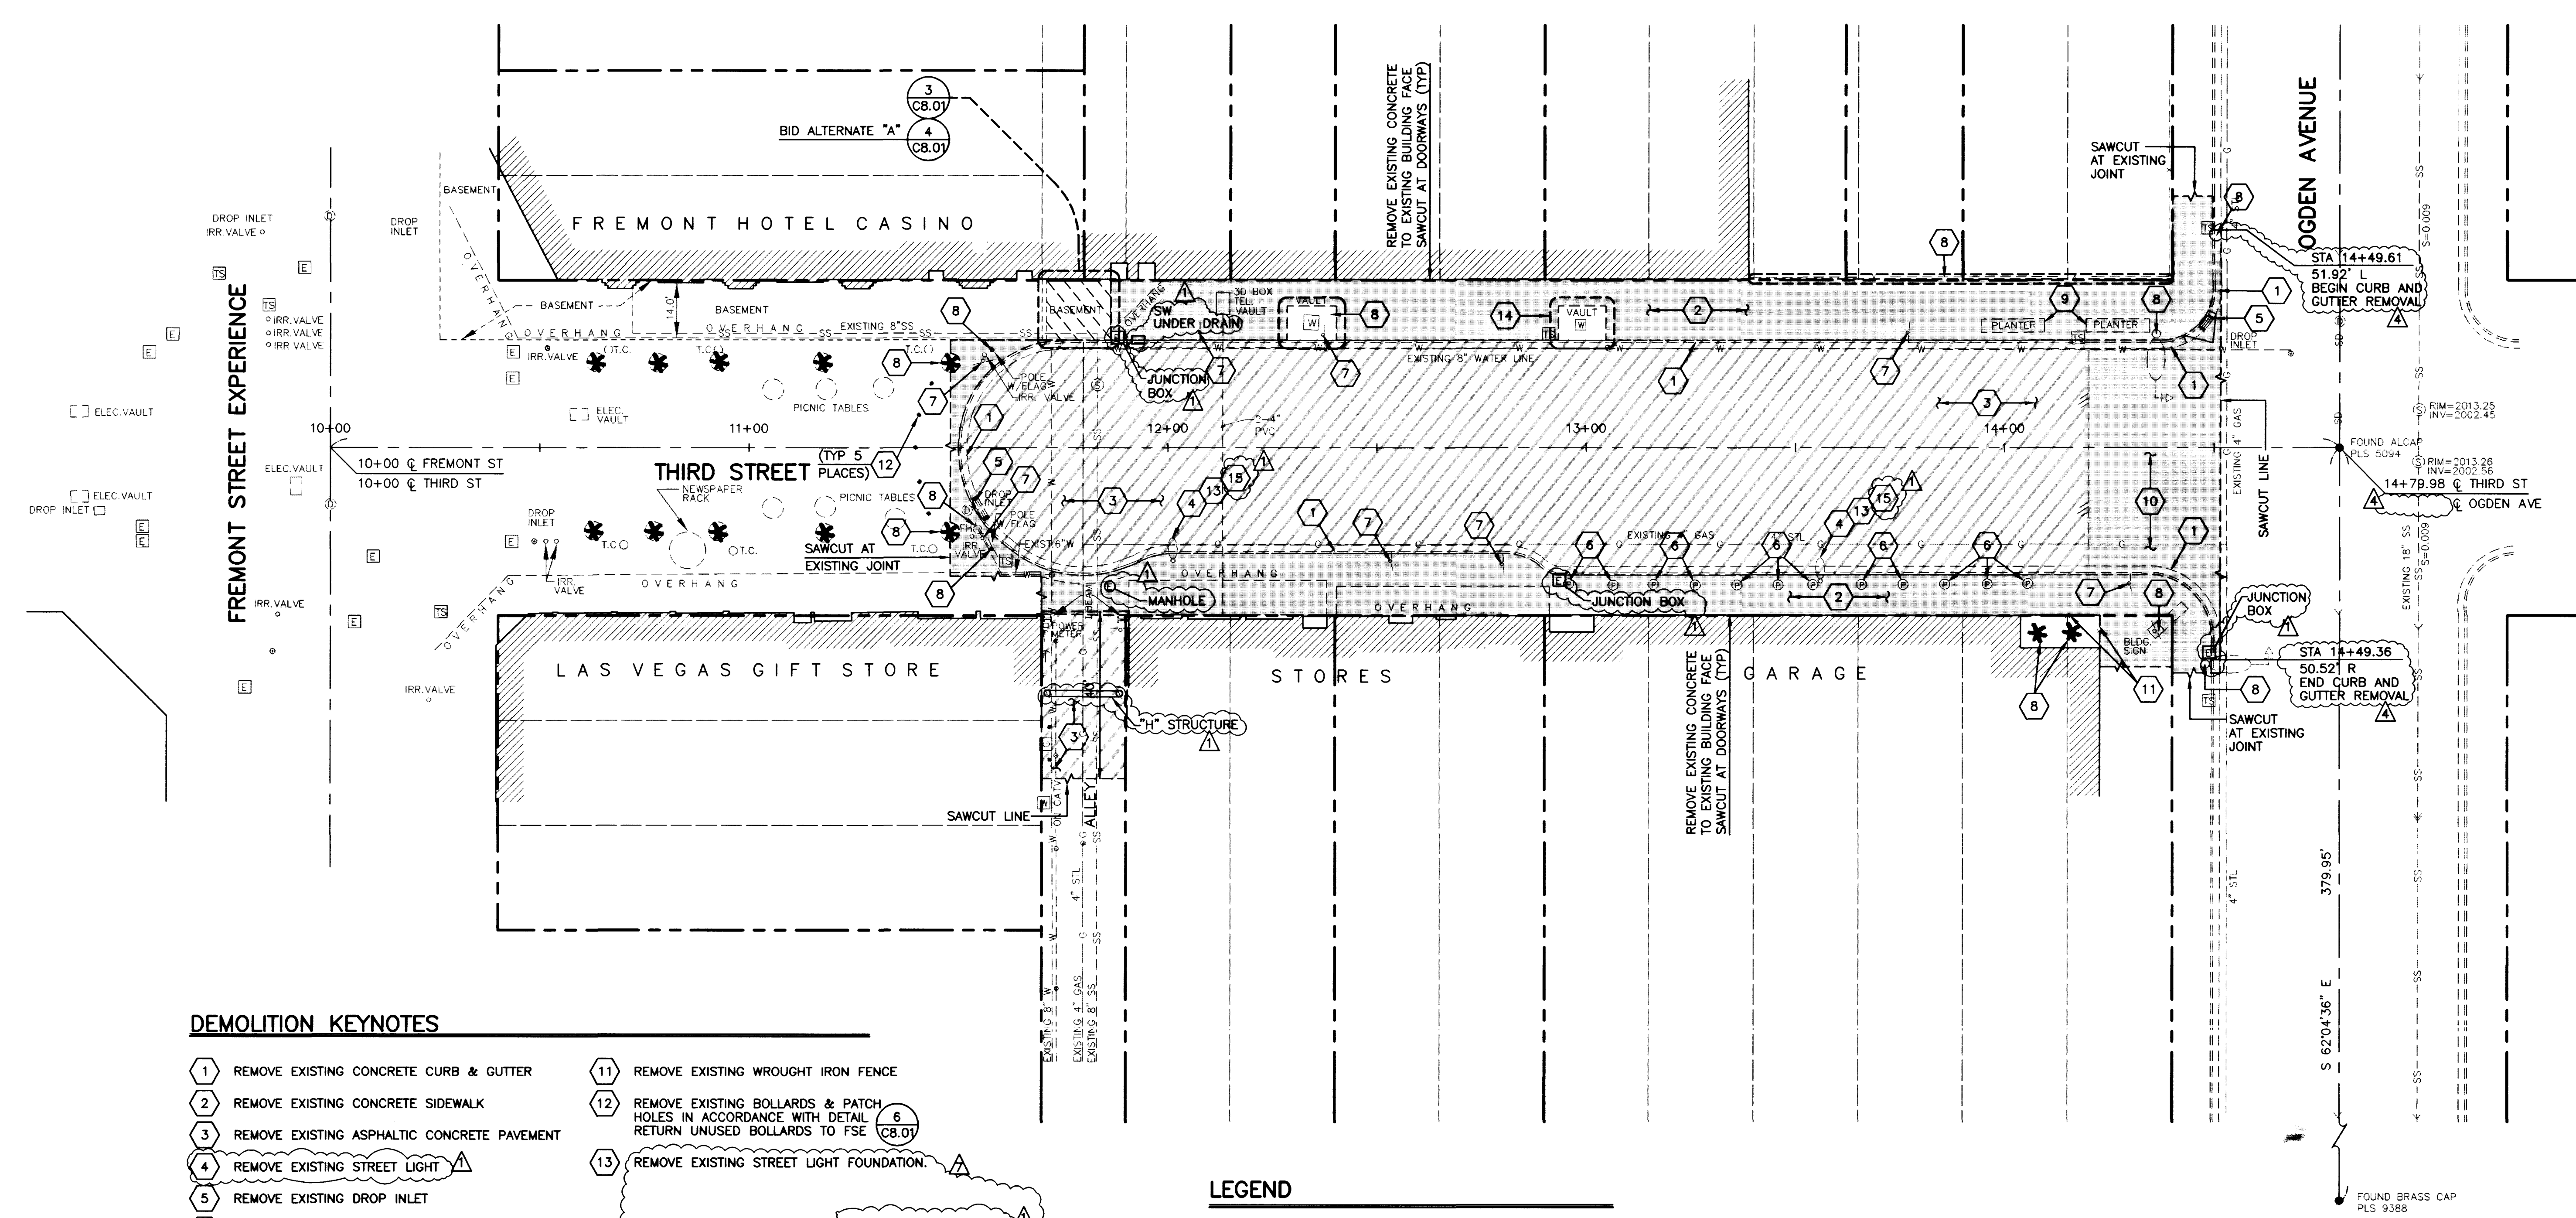


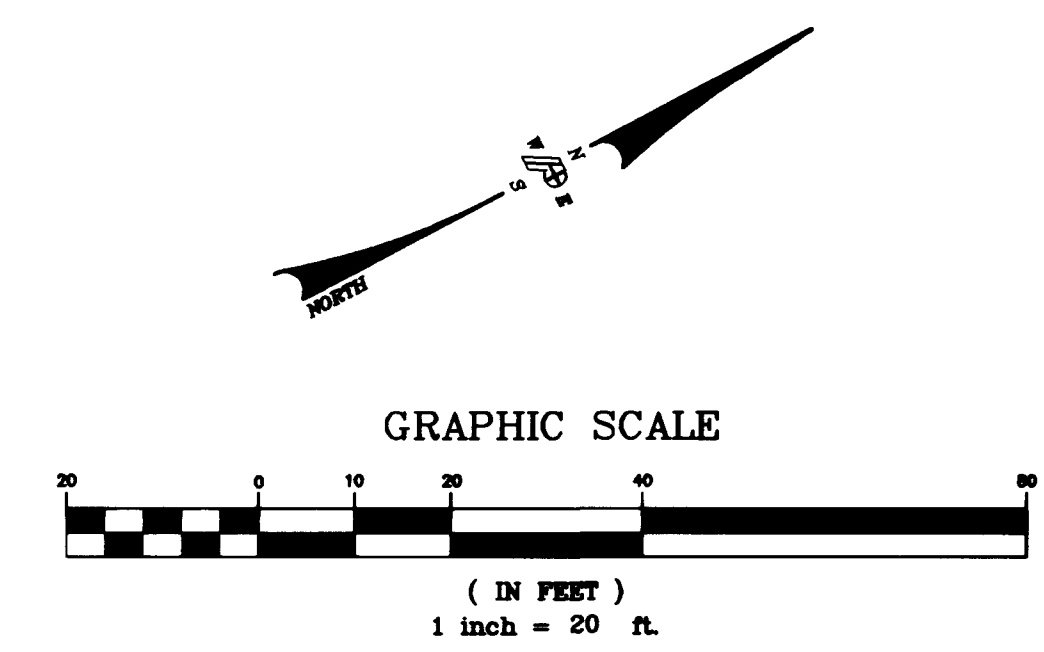

DEMOLITION KEYNOTES

- | | |
|---|--|
| 1 REMOVE EXISTING CONCRETE CURB & GUTTER | 11 REMOVE EXISTING WROUGHT IRON FENCE |
| 2 REMOVE EXISTING CONCRETE SIDEWALK | 12 REMOVE EXISTING BOLLARDS & PATCH HOLES IN ACCORDANCE WITH DETAIL RETURN UNUSED BOLLARDS TO FSE |
| 3 REMOVE EXISTING ASPHALTIC CONCRETE PAVEMENT | 13 REMOVE EXISTING STREET LIGHT FOUNDATION |
| 4 REMOVE EXISTING STREET LIGHT | 14 REMOVE VAULT ROOF SLAB. REPLACE IN ACCORDANCE WITH UNIFORM DESIGN & CONSTRUCTION STANDARDS FOR WATER DISTRIBUTION SYSTEMS PLATE C-475 TRAFFIC BEARING VAULT PLAN. PROTECT EXISTING METER DURING CONSTRUCTION. |
| 5 REMOVE EXISTING DROP INLET | 15 REMOVE STREET LIGHT CONDUIT AND WIRE |
| 6 REMOVE EXISTING PARKING METER & FOUNDATION | |
| 7 REMOVE EXISTING TRAFFIC SIGN & FOUNDATION | |
| 8 PROTECT IN PLACE | |
| 9 REMOVE EXISTING PLANTER (CUT & CAP ASSOCIATED IRRIGATION LINES) | |
| 10 REMOVE EXISTING CONCRETE STREET APRON | |


LEGEND

- DENOTES EXISTING ASPHALTIC CONCRETE PAVEMENT & EXISTING CURB & GUTTER TO BE REMOVED
- DENOTES EXISTING CONCRETE SIDEWALK & CONCRETE STREET TO BE REMOVED

STREET LIGHT REMOVAL
ALL EXISTING STREETLIGHTS THAT ARE REMOVED SHALL BE RETURNED TO THE CITY OF LAS VEGAS YARD AT 3104 E. BONANZA ROAD (CALL 229-6331, GEORGE LEVINS, BEFORE RETURNING)

PARKING METER REMOVAL
ALL EXISTING PARKING METER THAT ARE REMOVED SHALL BE RETURNED TO THE CITY (CALL 229-6431, MERLE JENSE, BEFORE REMOVAL)

Call before you Dig.
1-800-227-2000

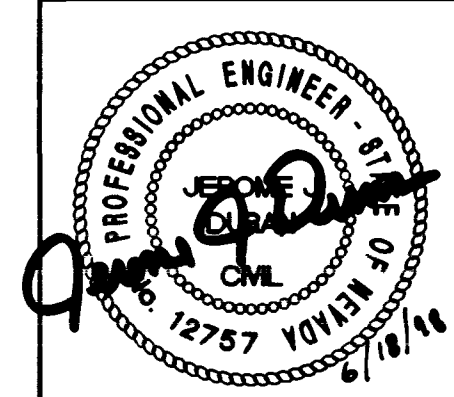

POGGE MEYER DESIGN GROUP INC.
2601 NORTH TENAYA WAY
LAS VEGAS, NEVADA 89128 (702) 255-8100

ISSUED FOR CONSTRUCTION	00/00/00
NOTE	DATE
REQUIRED FOR UTILITY/CITY APPROVAL	05/08/98
CLARIFICATION REQUESTED BY CITY ENGINEER	06/09/98


SCALE: AS NOTED
SHEET 3 OF 24
DRAWING No: C3.01

FREMONT STREET EXPERIENCE

JOB No: 9846C
DESIGNED BY: JJD
DRAWN BY: DRF
DATE: 6.18.98
FILE NAME: C301-DEMO

PROJECT TITLE: FREMONT STREET EXPERIENCE
3rd STREET MALL EXPANSION
SHEET TITLE: DEMOLITION PLAN

THIS DOCUMENT DOES NOT DESCRIBE AN INSTALLABLE SYSTEM UNTIL IT HAS BEEN REVIEWED FOR CODE COMPLIANCE AND COMPLIANCE WITH CONSTRUCTION STANDARDS BY A CERTIFIED ENGINEER. COMPLETE REVIEW OF THIS DOCUMENT IS THE RESPONSIBILITY OF THE USER. AND CODE COMPLIANT DESIGN. FREMONT STREET EXPERIENCE, LLC, SPECIFICALLY DISCLAIMS ANY RESPONSIBILITY FOR CODE COMPLIANCE. THESE DRAWINGS AND THE CONCEPTS THEY REPRESENT ARE THE PROPERTY OF FREMONT STREET EXPERIENCE, LLC. THEY SHALL NOT BE REPRODUCED, COPIED OR USED IN ANY PART WITHOUT PRIOR WRITTEN PERMISSION OF FREMONT STREET EXPERIENCE, LLC.

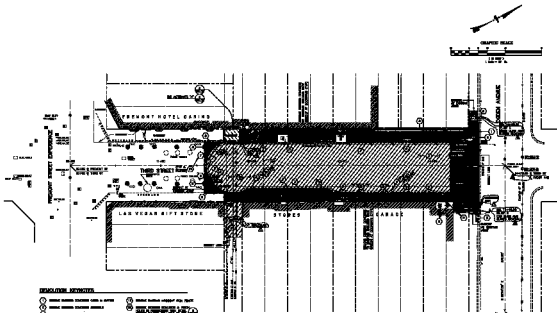






















FREMONT STREET EXPERIENCE 3rd STREET MALL EXPANSION


DEMOLITION PLAN



