


FREMONT STREET EXPERIENCE

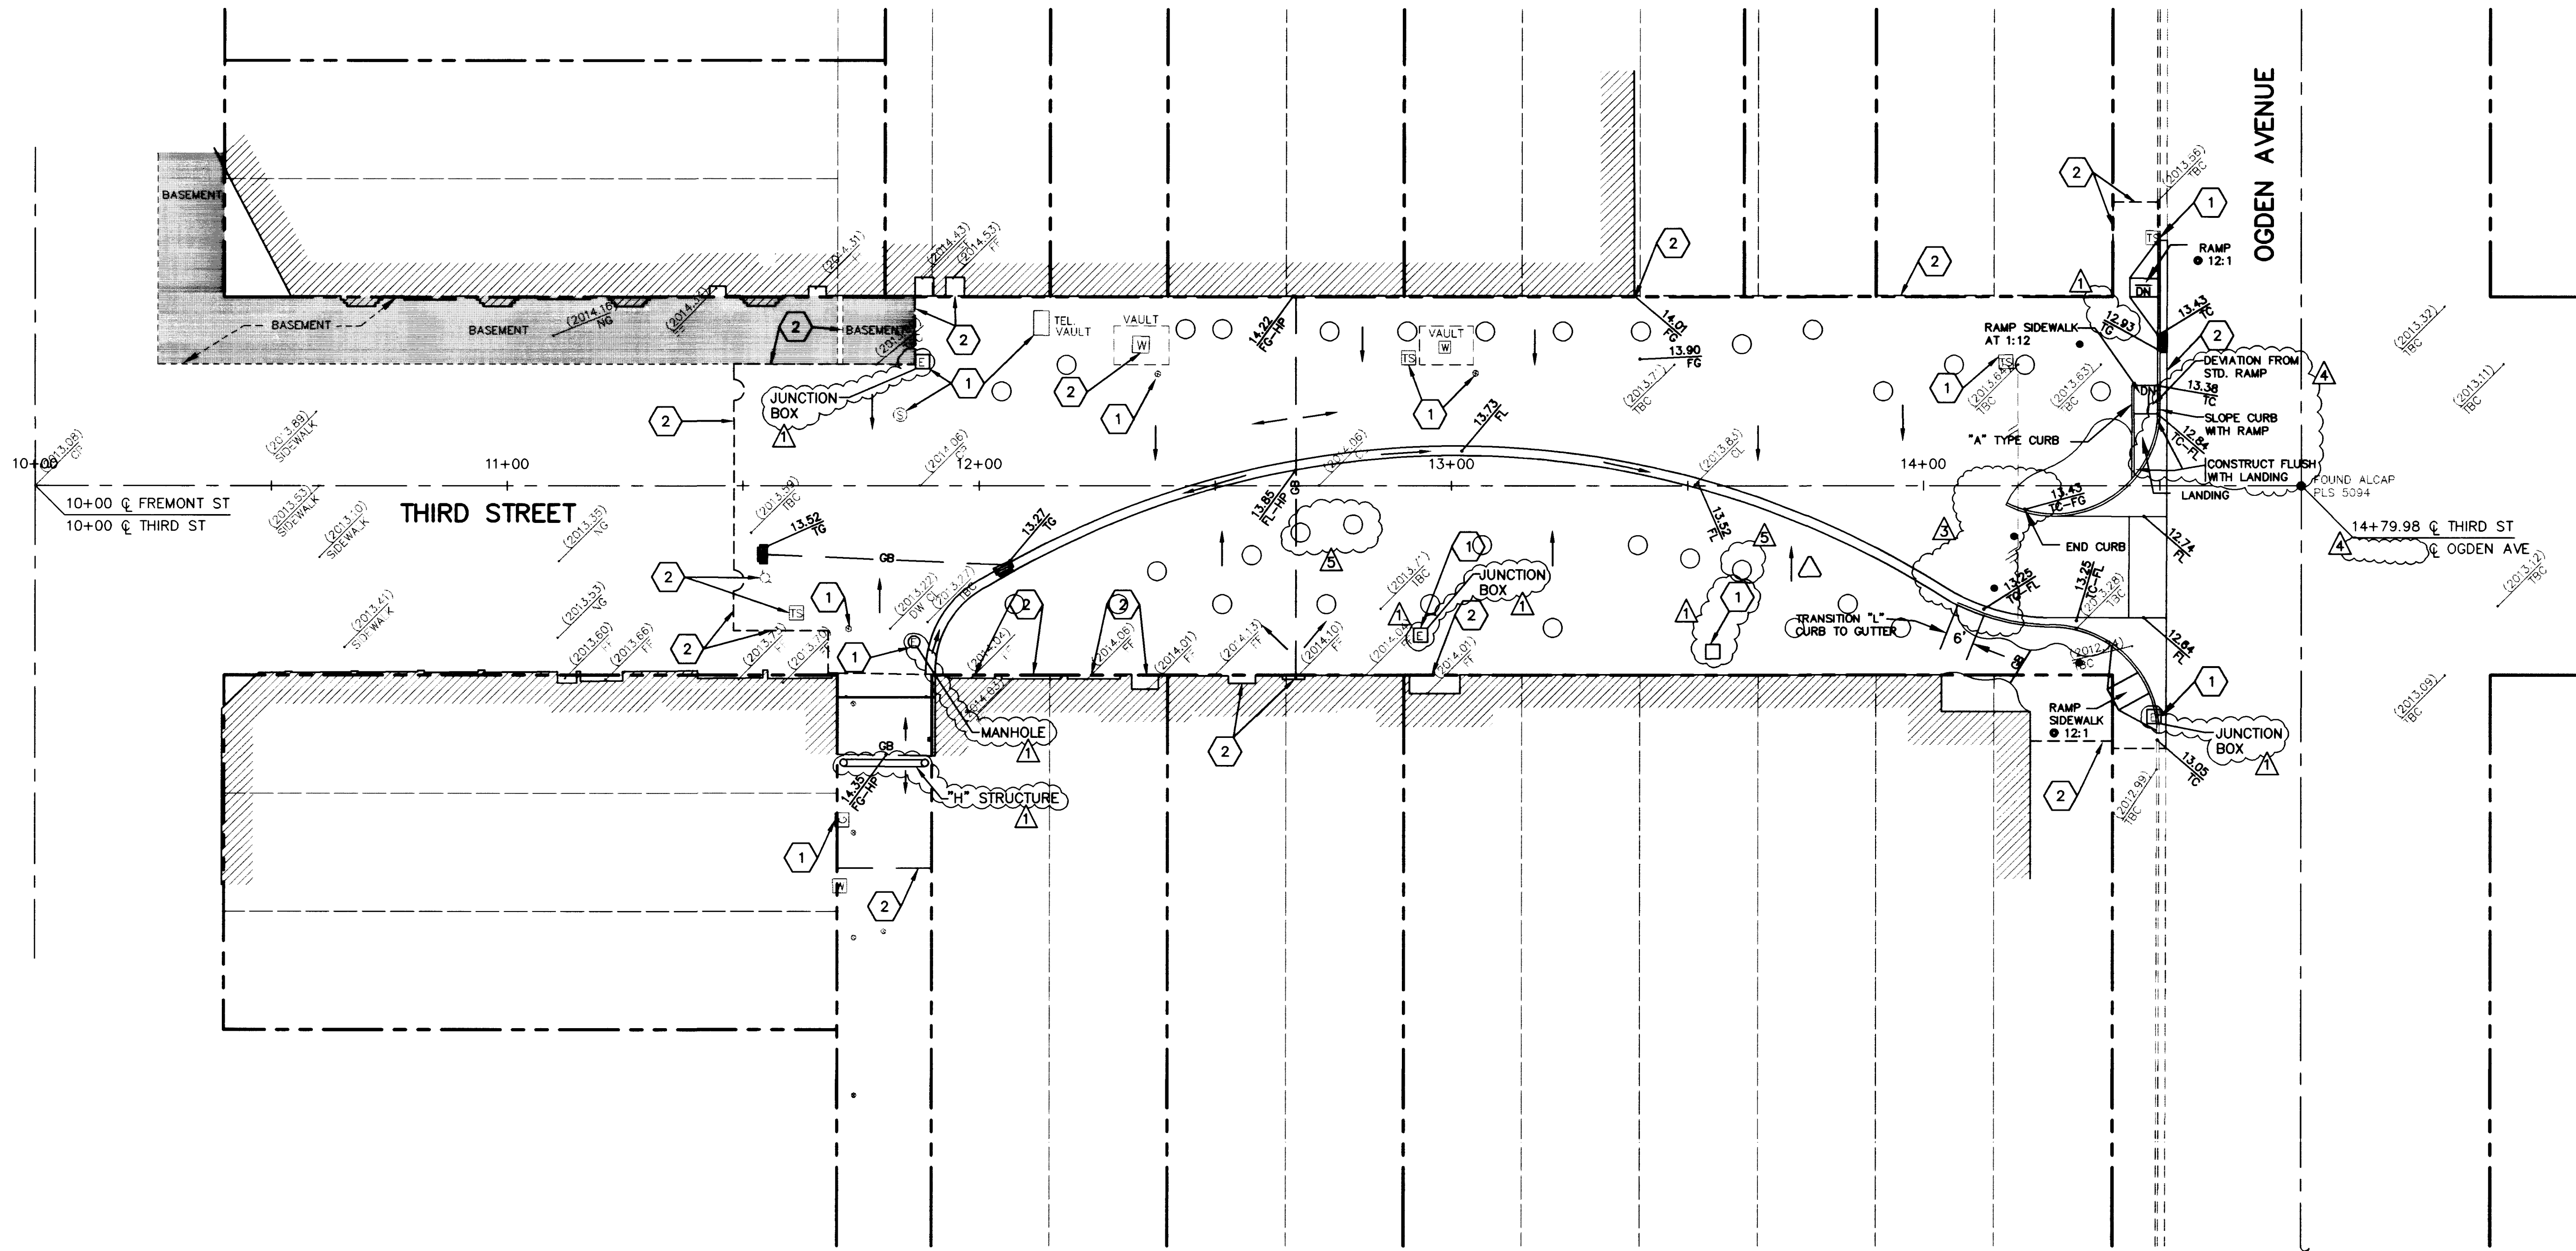

GRADING PLAN KEYNOTES


- 1 ADJUST TO GRADE PER USD NO. 408 (MANHOLES), NO. 517 (VALVE BOXES), AND NO. 404.140 (PULL BOX STREET COVERS)
- 2 MATCH FLUSH TO EXISTING GRADE

BASIS OF BEARINGS

BEING THE CENTERLINE OF THIRD STREET BETWEEN FREMONT STREET AND OGDEN AVENUE. TAKEN AS SOUTH 27°54'33" WEST PER RECORD OF SURVEY FILE 67, PAGE 79.

BASIS OF ELEVATION

FREMONT 5, RIVET AND PLATE IN TOP OF CURB NORTHEAST RETURN FREMONT STREET AND LAS VEGAS BOULEVARD. ELEVATION 2007.32 FEET. (611.8322 METERS)

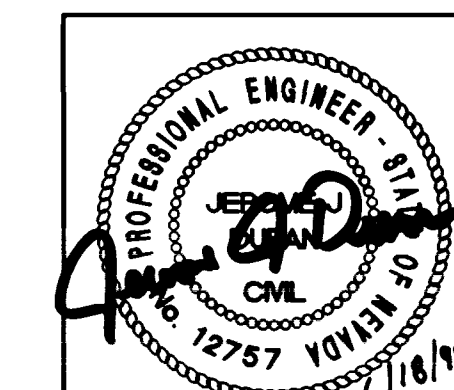

POGGE MEYER DESIGN GROUP INC. 2601 NORTH TENAYA WAY LAS VEGAS, NEVADA 89128 (702) 255-8100		
ISSUED FOR CONSTRUCTION	00/00/00	DATE
REQUIRED FOR UTILITY/CITY APPROVAL	05/08/98	DATE
REMOVE GATE ADD BOLLARDS	05/21/98	DATE
CLARIFICATION REQUESTED BY CITY ENGINEER	06/09/98	DATE

THIS DOCUMENT DOES NOT DESCRIBE AN INSTALLABLE SYSTEM UNTIL IT HAS BEEN REVIEWED FOR CODE COMPLIANCE AND COMPLIANCE WITH CONSTRUCTION STANDARDS BY A CERTIFIED ENGINEER. ALTHOUGH EVERY EFFORT HAS BEEN MADE TO PRODUCE A COMPLETE AND CODE-COMPLIANT DESIGN "FREMONT STREET EXPERIENCE LLC" SPECIFICALLY DISCLAIMS ANY RESPONSIBILITY FOR CODE COMPLIANCE. THESE DRAWINGS AND THE CONCEPTS THEY REPRESENT ARE THE EXCLUSIVE PROPERTY OF FREMONT STREET EXPERIENCE LLC. ANY REPRODUCTION, COPIED OR USED IN ANY MANNER WITHOUT PRIOR WRITTEN PERMISSION OF FREMONT STREET EXPERIENCE LLC.

FREMONT STREET EXPERIENCE


425 FREMONT STREET, LAS VEGAS, NV. 89101
 TEL: (702) 678-5600 FAX: (702) 678-5611

JOB No:	98046C
DESIGNED BY:	JJD
DRAWN BY:	CWP
DATE:	6.18.98
FILE NAME:	C501-GRD

PROJECT TITLE:
 FREMONT STREET EXPERIENCE
 3rd STREET MALL EXPANSION

SHEET TITLE:
 GRADING PLAN

SCALE:	1" = 20'
SHEET	5 OF 24
DRAWING No:	C5.01

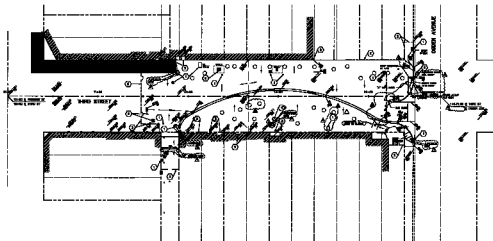**GRADING PLAN KEYNOTES**


1999





