




FREMONT STREET EXPERIENCE

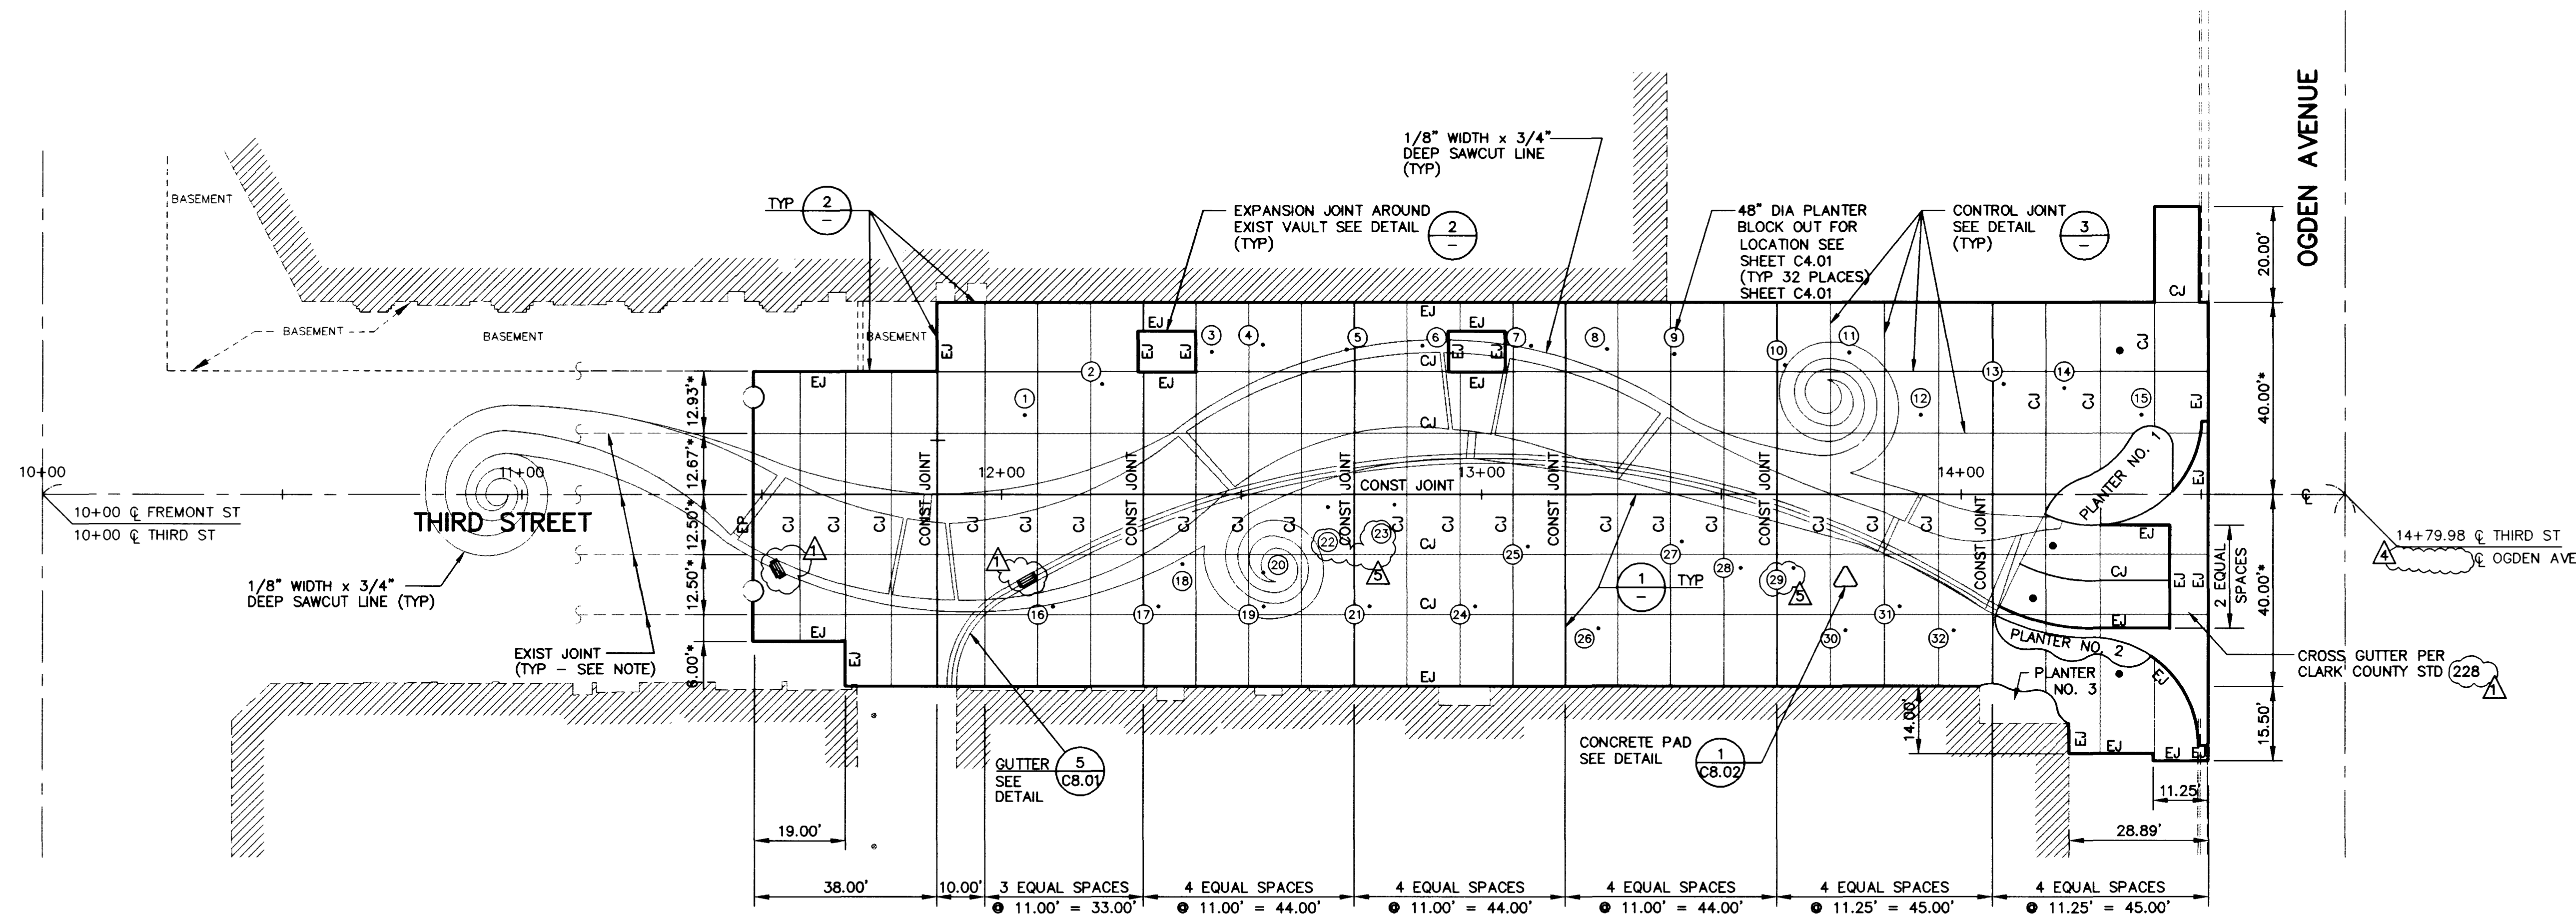


NOTE:
WHEN A DIMENSION WITH "*" APPEARS, THE DIMENSION
MAY HAVE TO BE ADJUSTED BASED ON THE EXISTING
LONGITUDINAL JOINT SPACING.

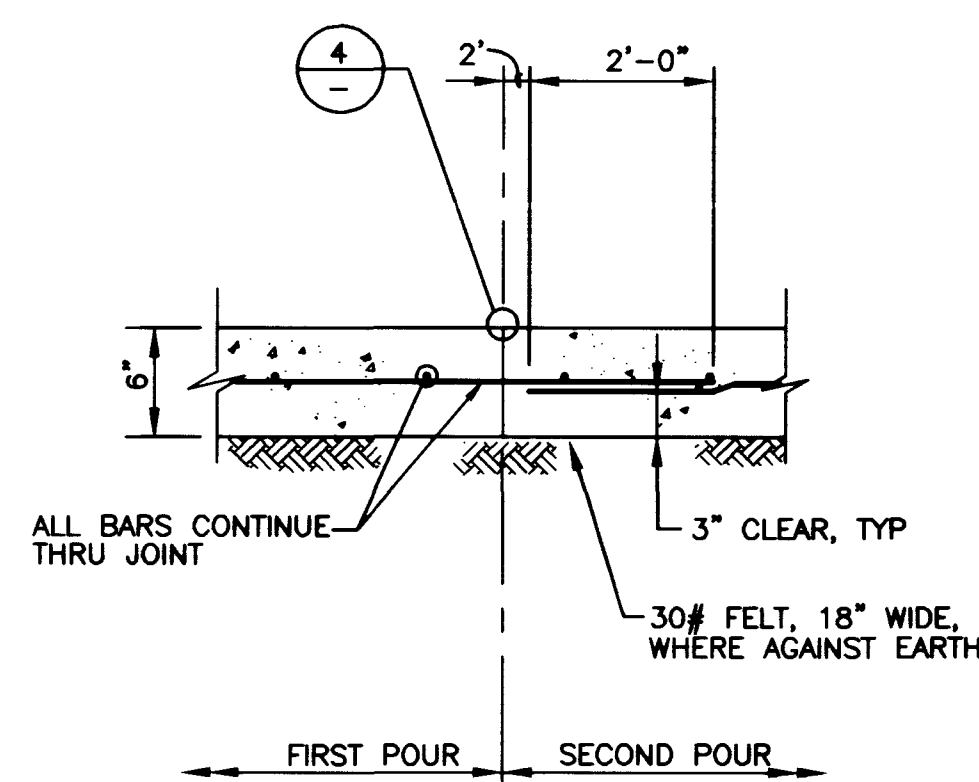


CONSTRUCTION JOINT DETAIL (1)

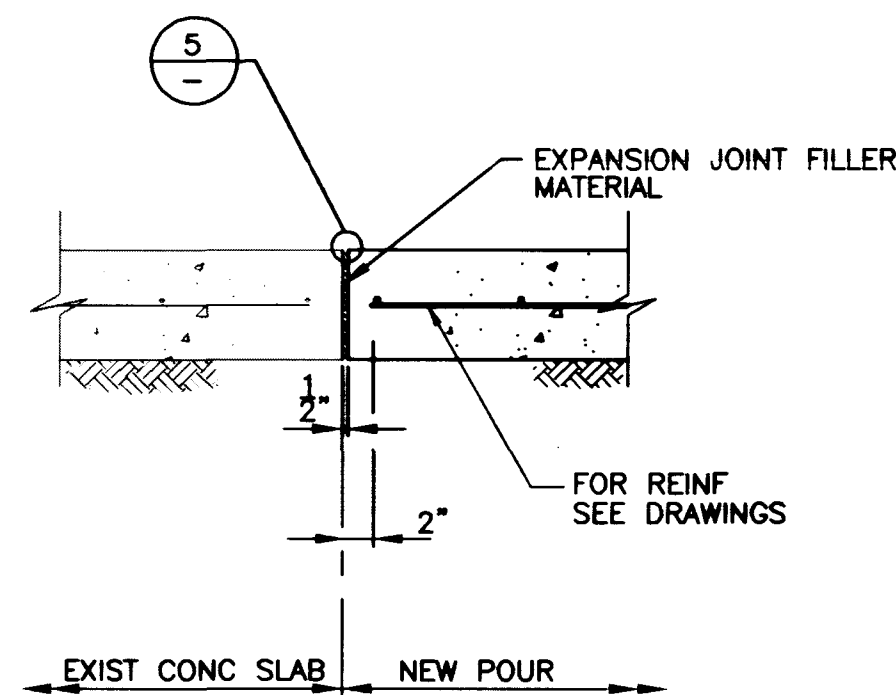


EXPANSION JOINT DETAIL (2)

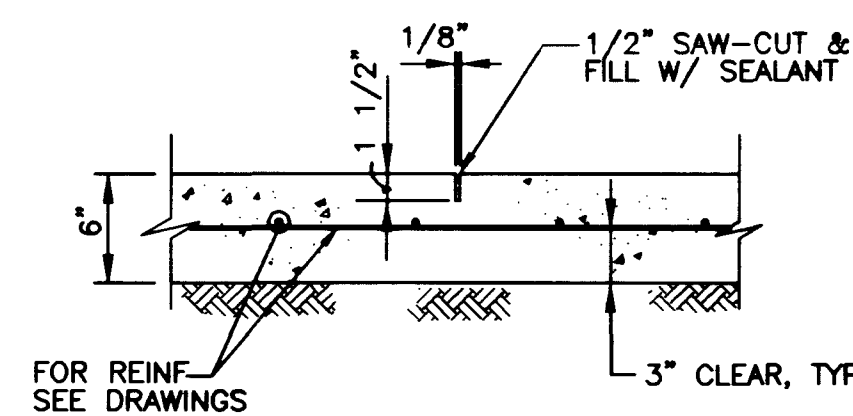

CONTROL JOINT DETAIL (3)

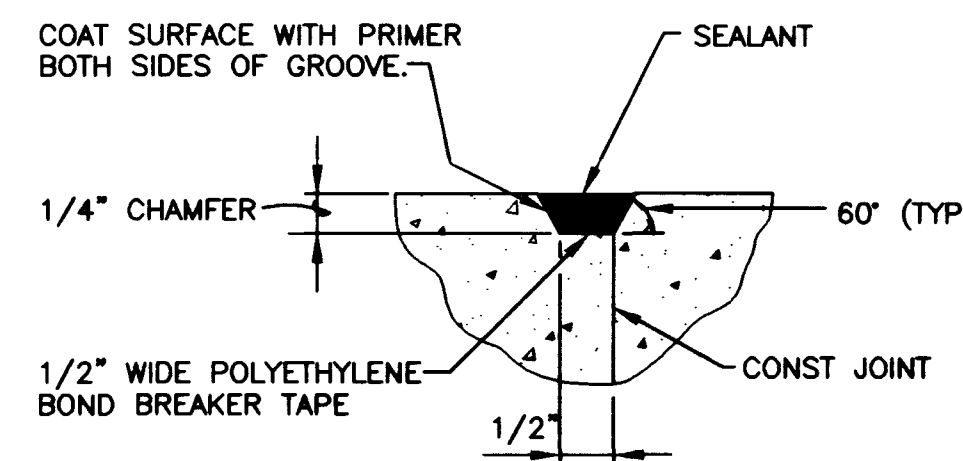


DETAIL (4)

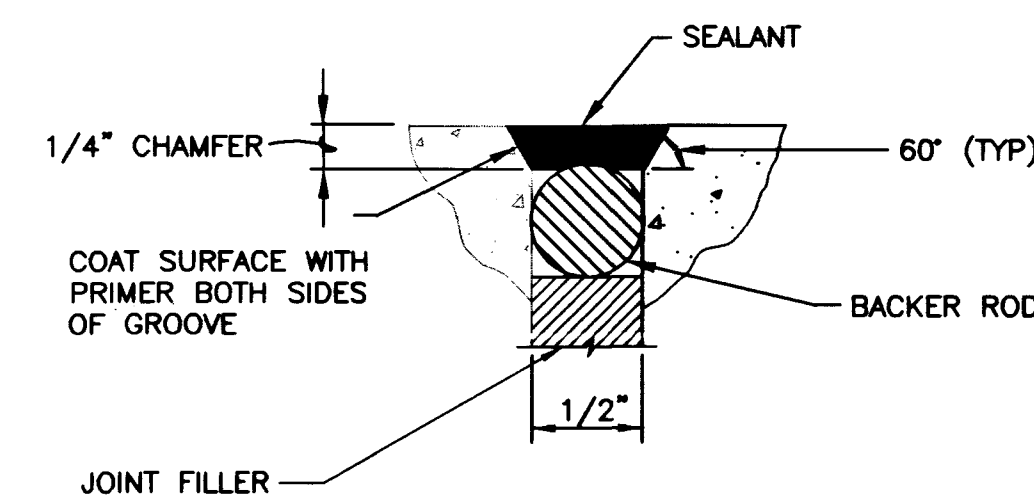

DETAIL (5)



Call
before you
Dig.
1-800-227-2600

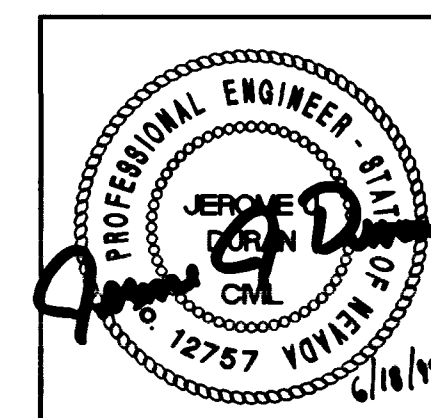

POGGEMEYER DESIGN GROUP INC. 2601 NORTH TENAYA WAY LAS VEGAS, NEVADA 89128 (702) 255-8100		
ISSUED FOR CONSTRUCTION	00/00/00	DATE
REQUIRED FOR UTILITY/CITY APPROVAL	05/08/98	DATE
CLARIFICATION REQUESTED BY CITY ENGINEER	06/09/98	DATE
LVWMD CHANGES FOR APPROVAL	06/18/98	DATE

SCALE: AS NOTED
SHEET 7 OF 24
DRAWING No:
C7.01

FREMONT STREET EXPERIENCE

425 FREMONT STREET, LAS VEGAS, NV. 89101
TEL: (702) 678-5600 FAX: (702) 678-5611

PROJECT TITLE:
FREMONT STREET EXPERIENCE
3rd STREET MALL EXPANSION

SHEET TITLE:
JOINTING PLAN



