

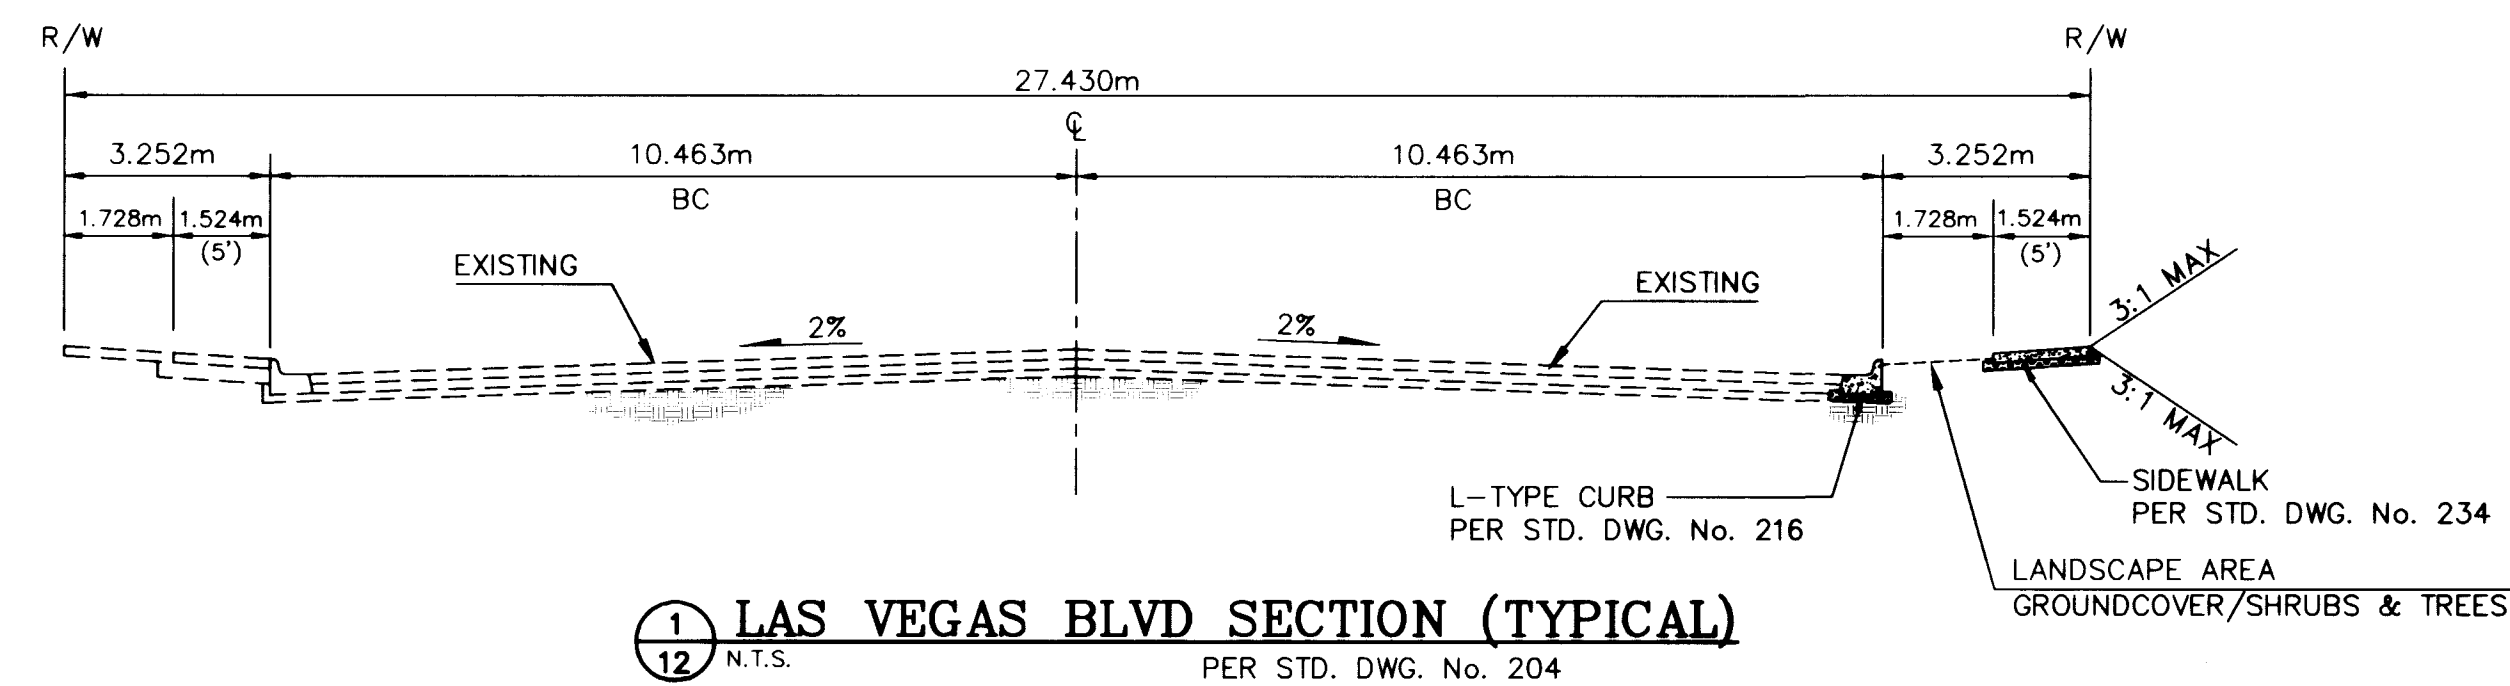
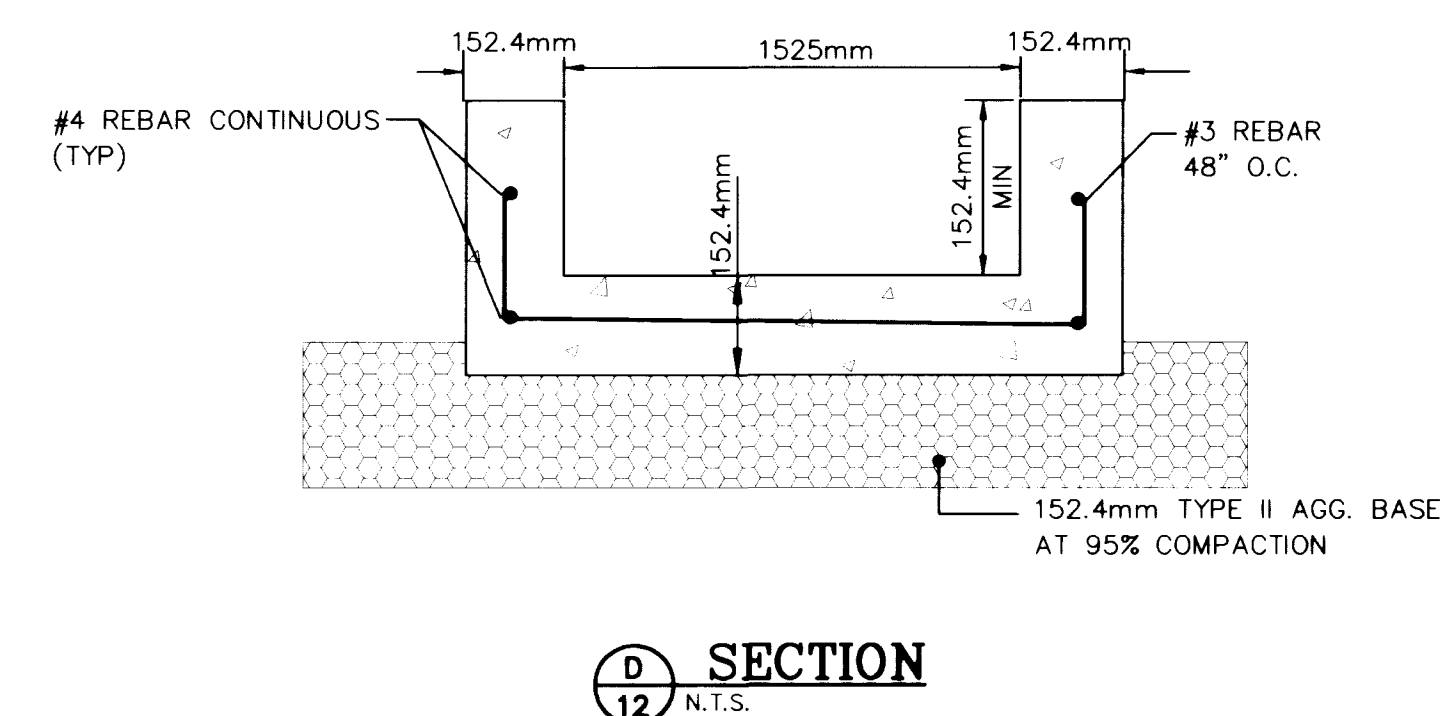
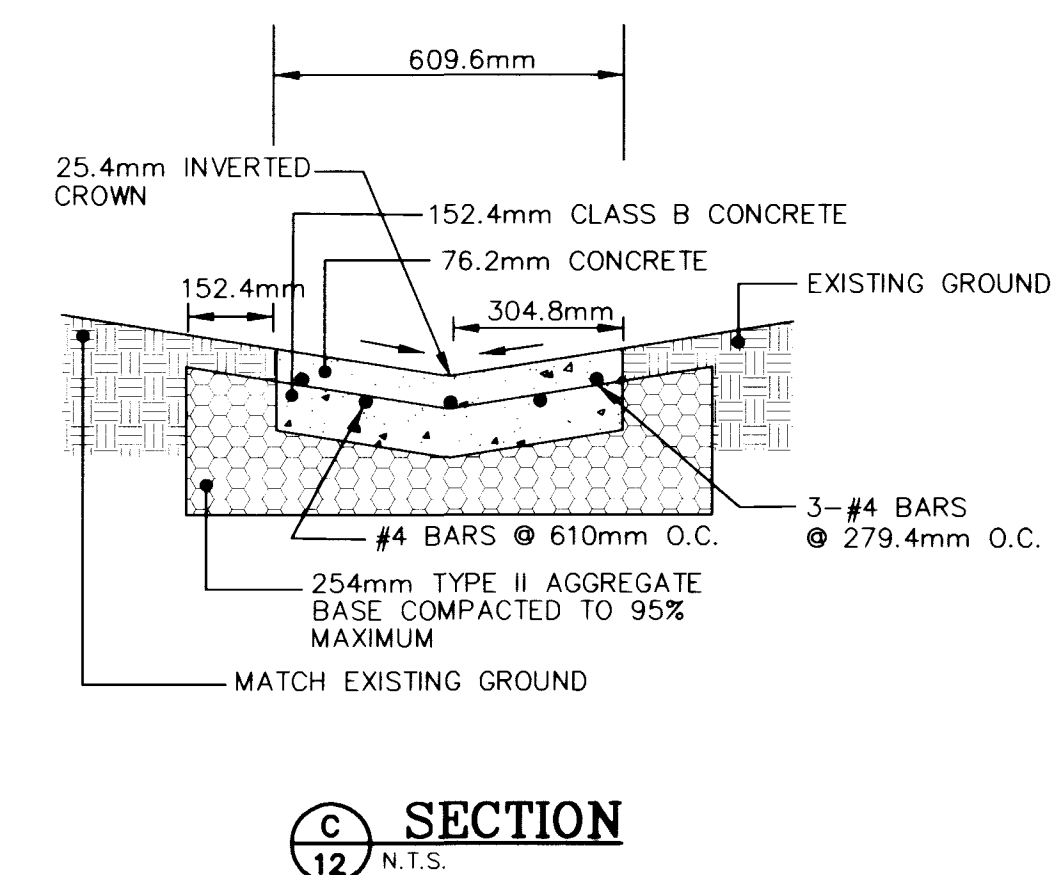
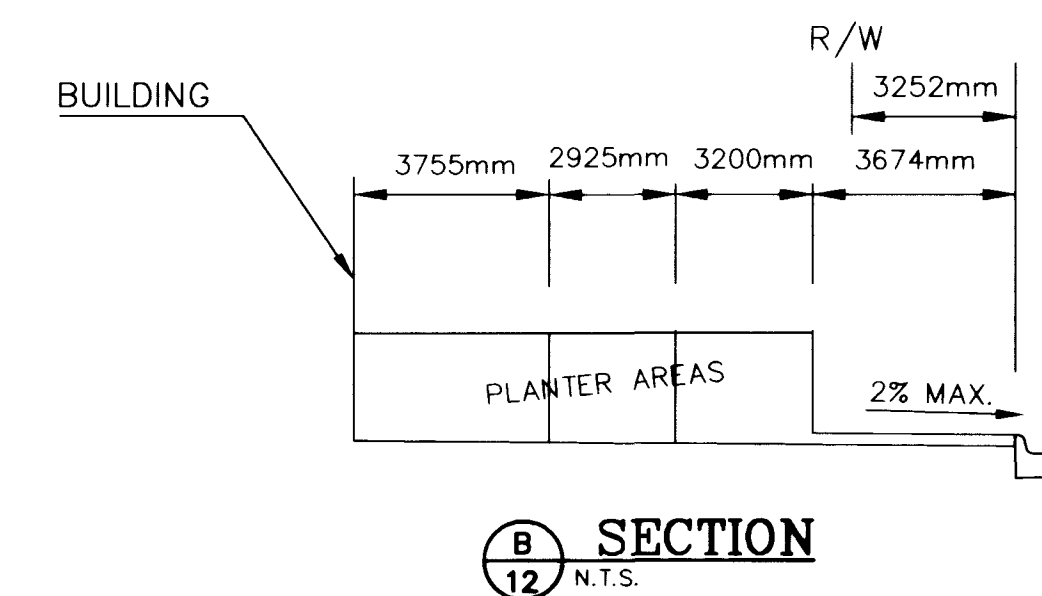
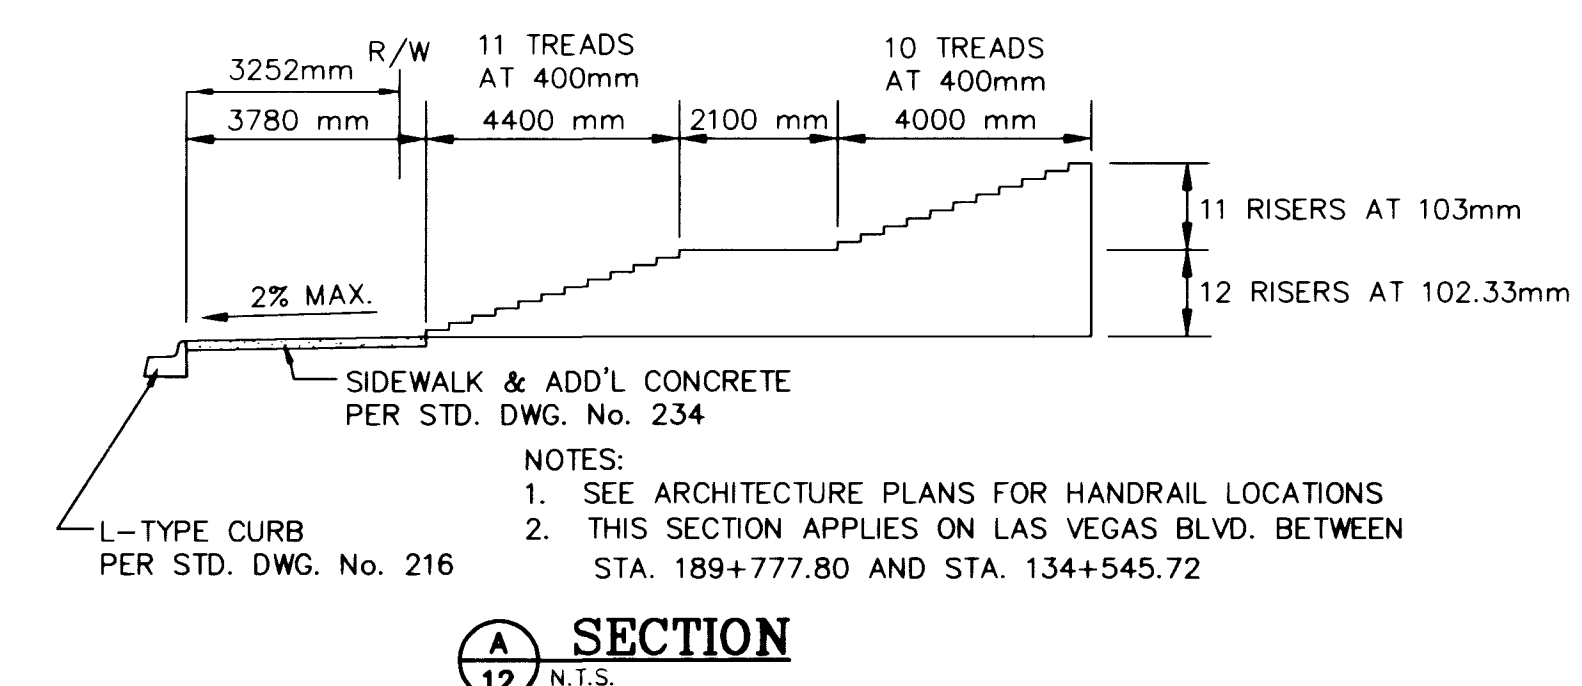
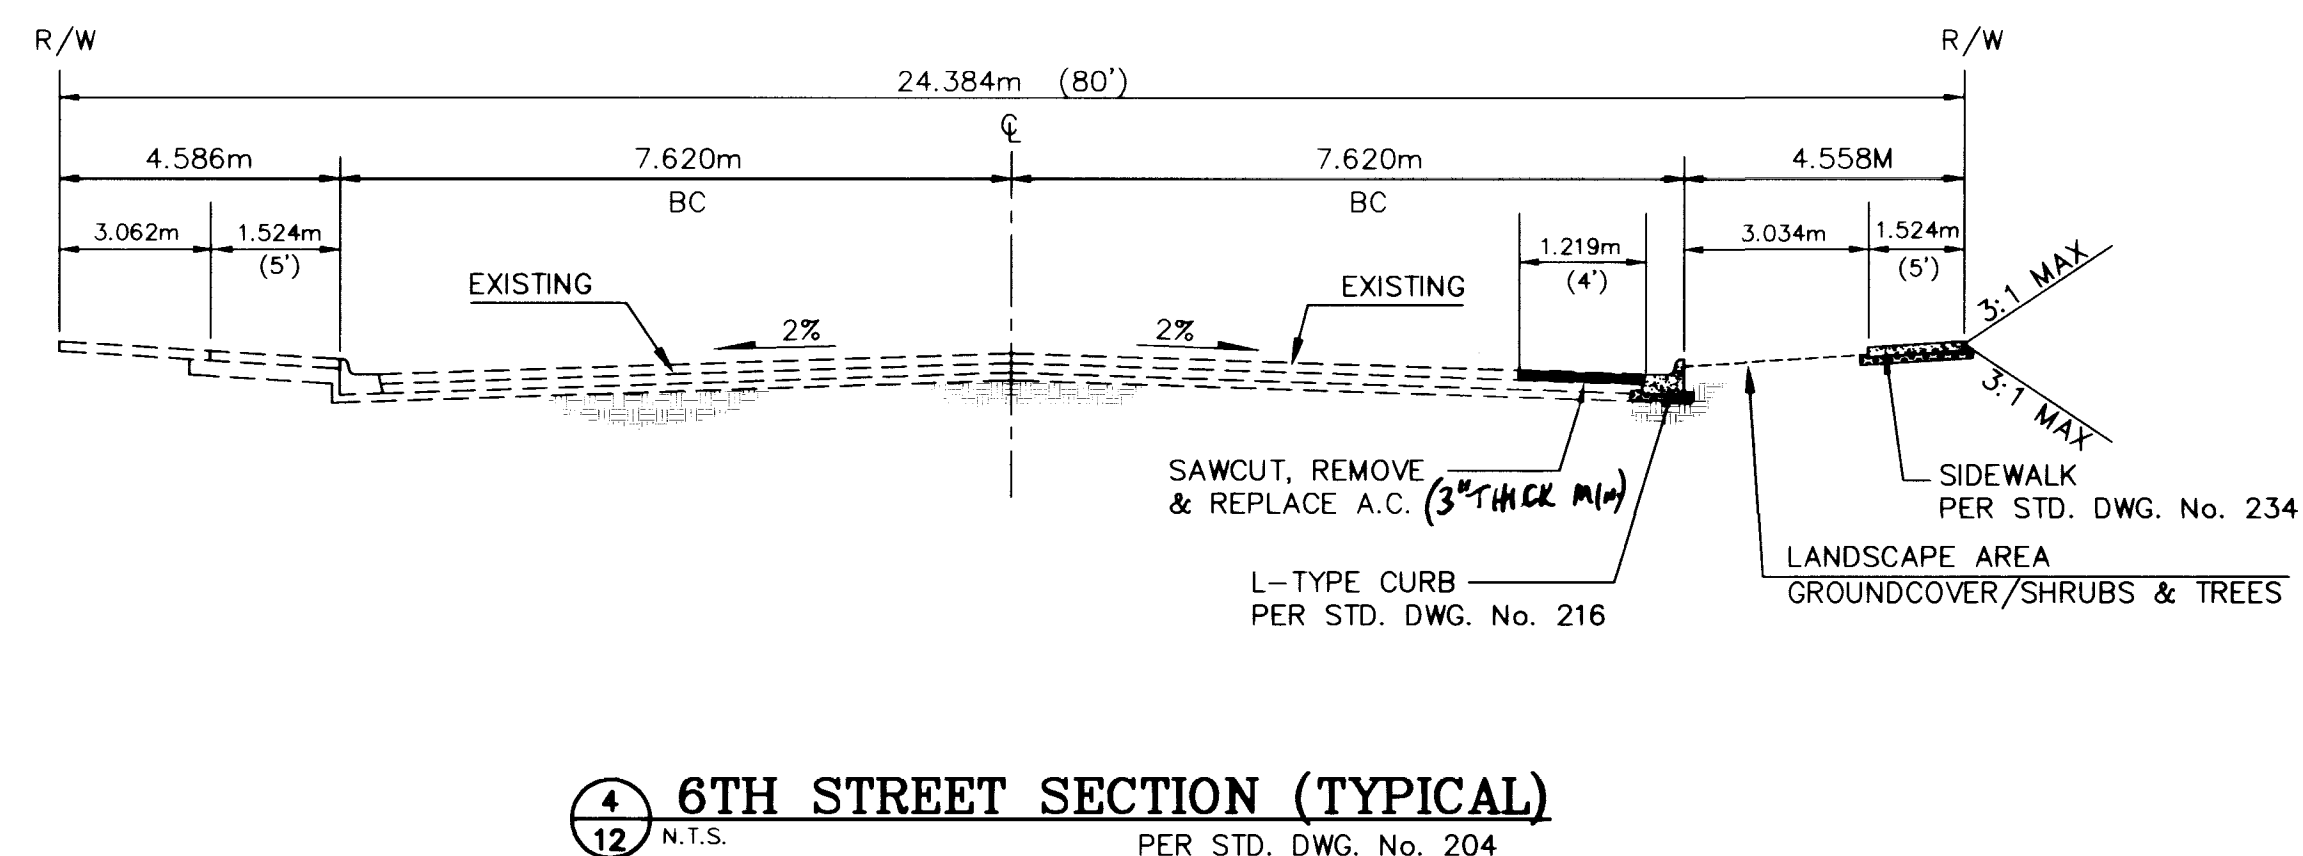


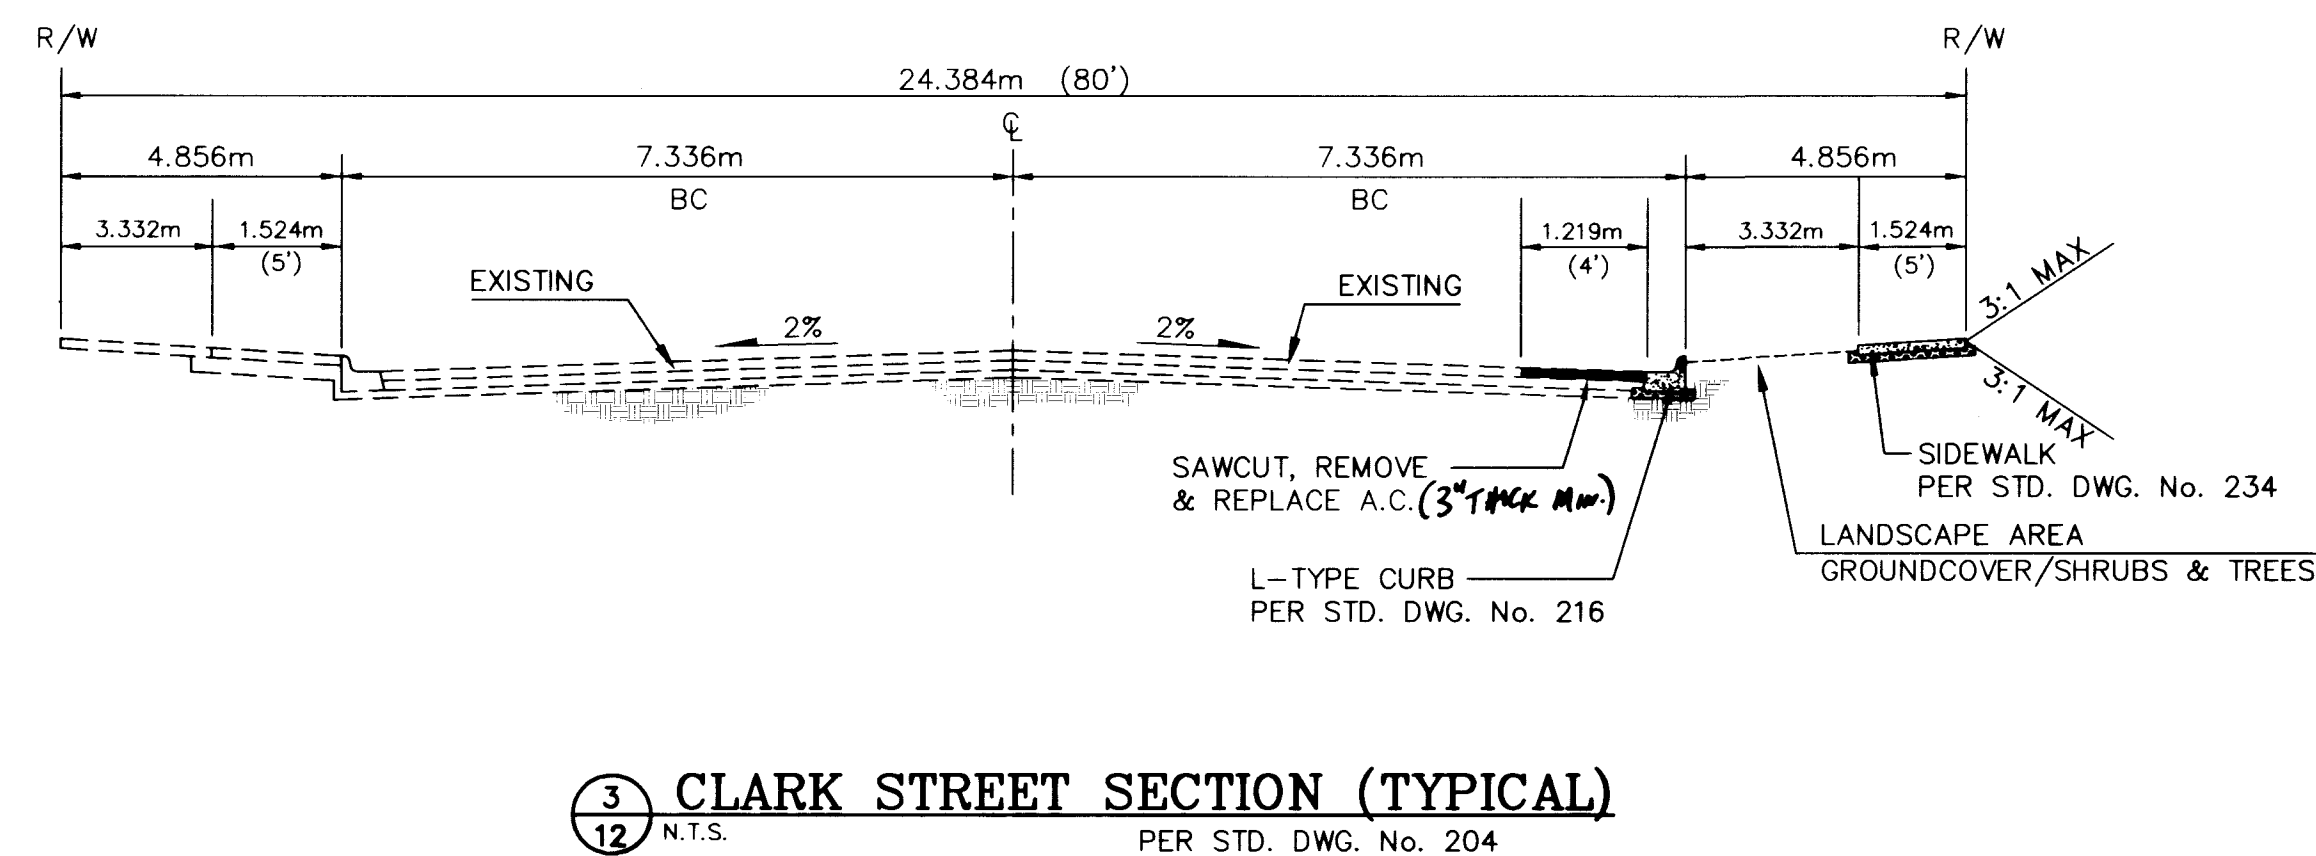

REMOVE DRIVEWAY AND REPLACE WITH CURB, GUTTER AND SIDEWALK AT THESE STATIONS:
87+447.80 TO 95+822.24 , 101+954.55 TO 114+300.31 , 136+358.80 TO 188+591.30 ,
220+629.20 TO 229+446.30 AND 246+882.20 TO 264+812.80

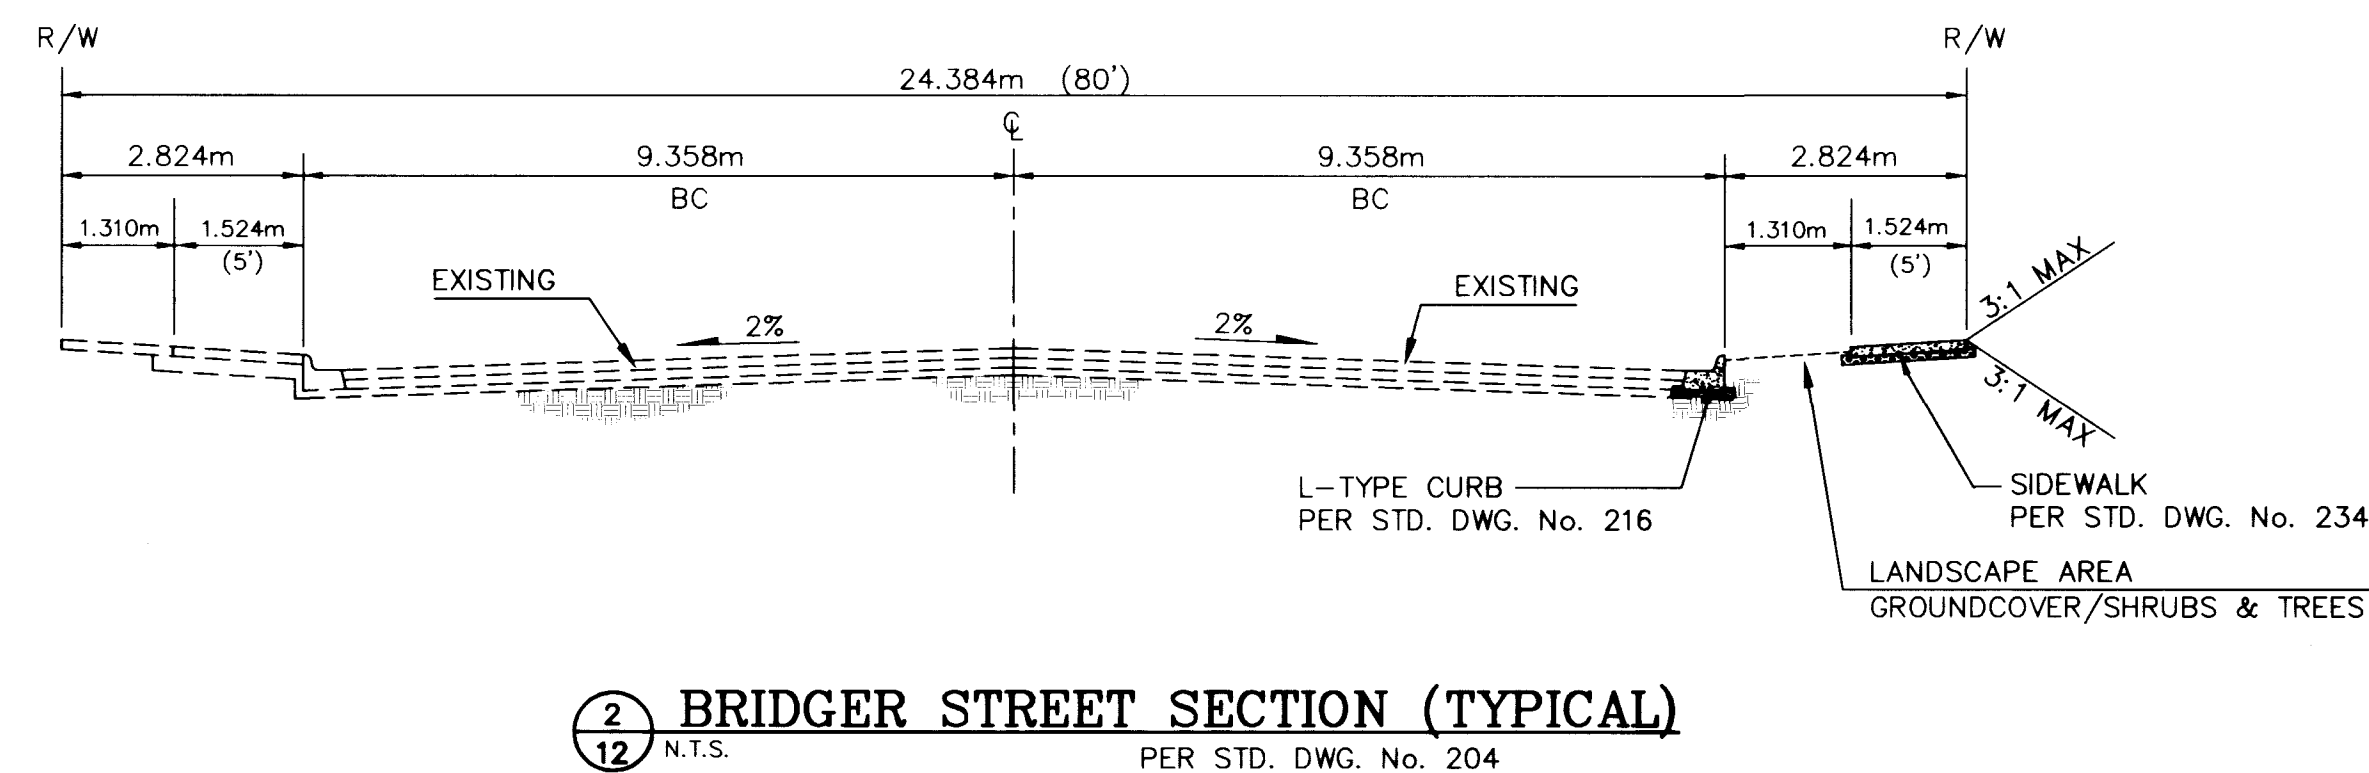

LANGDON
WILSON
ARCHITECTURE
PLANNING

1055 WILSHIRE BOULEVARD
SUITE 1500
LOS ANGELES, CALIFORNIA 90017-2449
(213) 250-1186



Kimley-Horn ©1998
and Associates, Inc.
Engineering, Planning, and Environmental Consultants

1050 East Flamingo Road
Suite S-210
Las Vegas, Nevada 89119
Tel. No. (702) 734-5666
Fax No. (702) 735-4949

**FEDERAL BUILDING AND
UNITED STATES COURTHOUSE
LAS VEGAS, NEVADA**

DESIGNED BY:	DJM	01/99
CHECKED BY:	DPL	01/99
PROJECT NO:	092209.00	SCALE:
		NO SCALE



SHEET
C12
12 OF 13 SHEETS
C.L.V. DRAWING NO.
07-V2952

SAFETY ALERT

Call Before You Overhead
1-702-593-6111





Avoid cutting underground utility lines. It's costly.

**Call
before you
Dig**

1-800-227-2600



NOTE: STREET AND SIDEWALK ARE NOT SHOWN AND LOCATIONS OF THESE STRUCTURES SHALL BE DETERMINED BY FIELD SURVEY. DIMENSIONS TO STRUCTURES ARE SHOWN TO CENTERLINE.

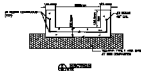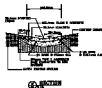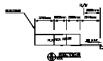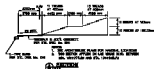

SAFETY ALERT




DETAILS

