


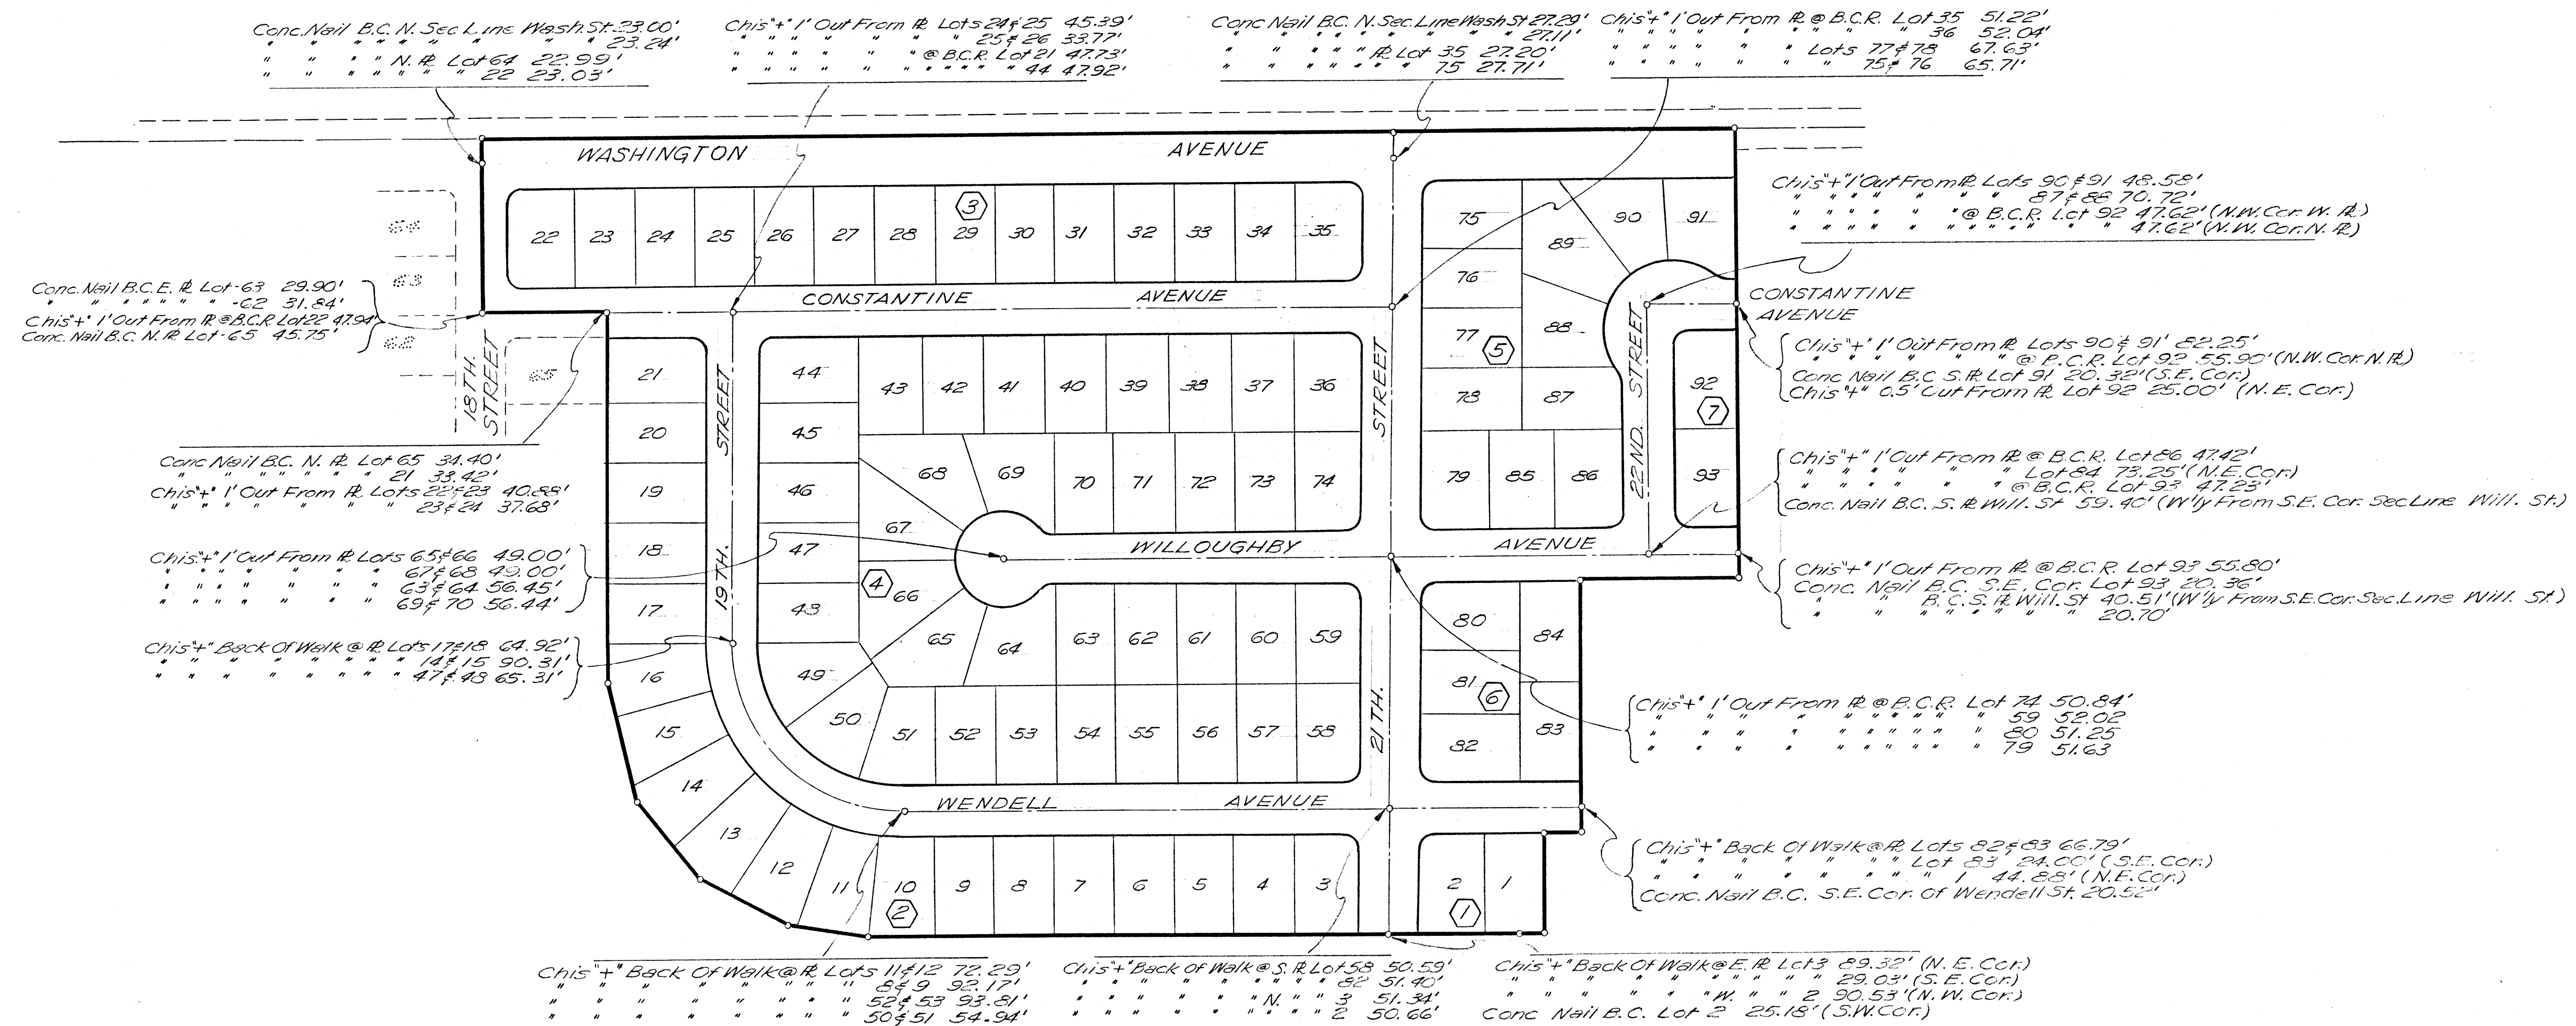

GREATER LAS VEGAS - 3
UNIT - 2
MAP OF MONUMENT TIES

DESIGNED	WESTERN ENGINEERS, INC.	SHEET
DRAWN	LAS VEGAS	NEVADA
CHECKED	APPROVED	DATE

4-6-47

058-1640-3-2