

MONUMENTATION MAP HIGHLAND INDUSTRIAL PARK

Being a portion of the NE1/4 of Section 8, and the SW1/4 of the NW1/4 of Section 9, T.21S., R.61E., M.D.M.
City of Las Vegas, County of Clark, State of Nevada.

INTERSTATE ROUTE 15

EXISTING N.S.H.D. RIGHT - OF - WAY

EXISTING CHAIN LINK FENCE

SCALE: 1" = 60'

BASIS OF BEARING:


The South Line of the SE1/4 NE1/4, Section 8, T.21S., R.61E., M.D.M.; Said Line Bears N.88°50'26"W. as per File 21, Page 40, Official Records Book No. 130, Clark County, Nevada, Records.

LEGEND:

- Found Monument as Designated
- Set Brass Cap in Concrete Monument Well, R.L.S. 4142
- Set 5/8" Rebar, R.L.S. 4142
- Record Bearing and/or Distance
- Lot Number
- P.U.E. Public Utility Easement
- TIE FROM REFERENCE POINT TO SET BC (RP SETAS DESCRIBED)

TOTAL PARCEL AREA: 17.702 ACRES±

TOTAL LOTS: 15

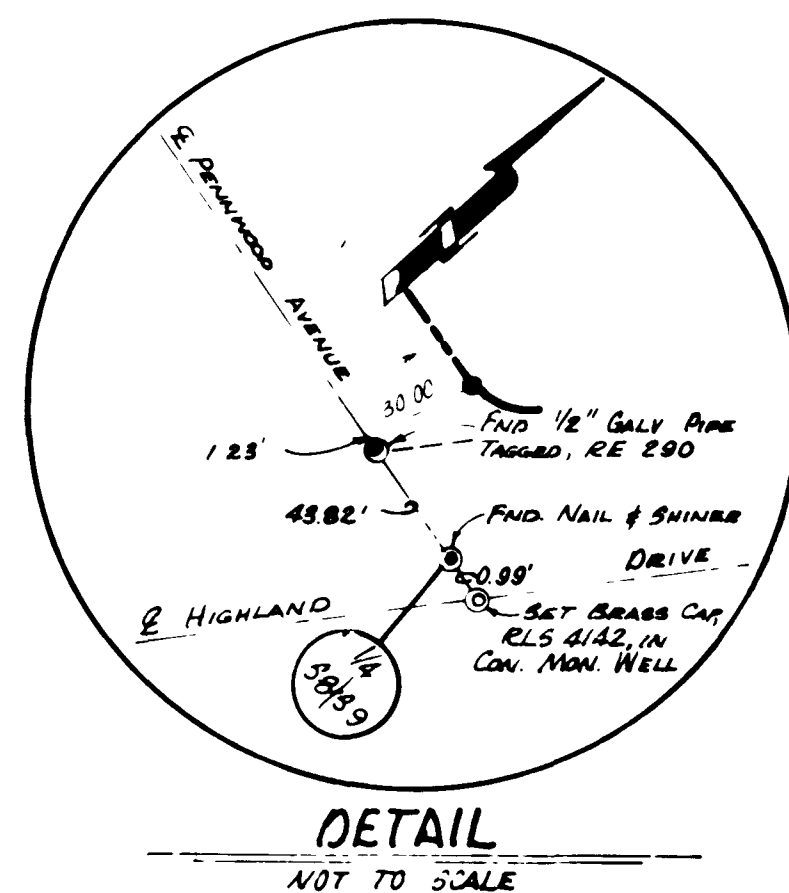

SURVEYOR'S CERTIFICATION

I, WILLIAM D. JACOBSEN, A DULY REGISTERED LAND SURVEYOR IN THE STATE OF NEVADA, DO HEREBY CERTIFY THAT THE STREET AND REFERENCE MONUMENTS SHOWN ON THIS MAP HAVE BEEN MEASURED AND ESTABLISHED IN THE FIELD BY ME OR UNDER MY DIRECT SUPERVISION, AND COMPLETED ON THIS 6TH DAY OF OCTOBER, 1978.

William D. Jacobsen
WILLIAM D. JACOBSEN
REGISTERED LAND SURVEYOR NO. 4142



MONUMENTATION MAP		
HIGHLAND INDUSTRIAL PARK		
Being a port. of NE1/4, Sec. 8, & SW1/4 NW1/4, Sec. 9, T.21S., R.61E., M.D.M.		
LAS VEGAS,	CLARK COUNTY,	NEVADA
SEA ENGINEERS PLANNERS	SLUTE NO. 890	JOB NO. 2-0122-00-77(3)
	FREE TRIPICANA AVE LAS VEGAS, NEVADA 89109	DESIGNED: GAS
		DRAWN: KEH
		COMP: WDJ
		CHECKED: W. 5/9/77
	DATE: OCT. 6, 1978	
	SHEET NO. 1 OF 1 SHEETS	
Phone (702) 739-8630		