



NOTE: FOR DESIGN ON WASH. AVE. - SEE WASH. AVE. DESIGN
BY TYSON ENG. CO. DATED NOV. 6, 1958. CLY. NO. 1071-1080-4 & 308Y-1060-1

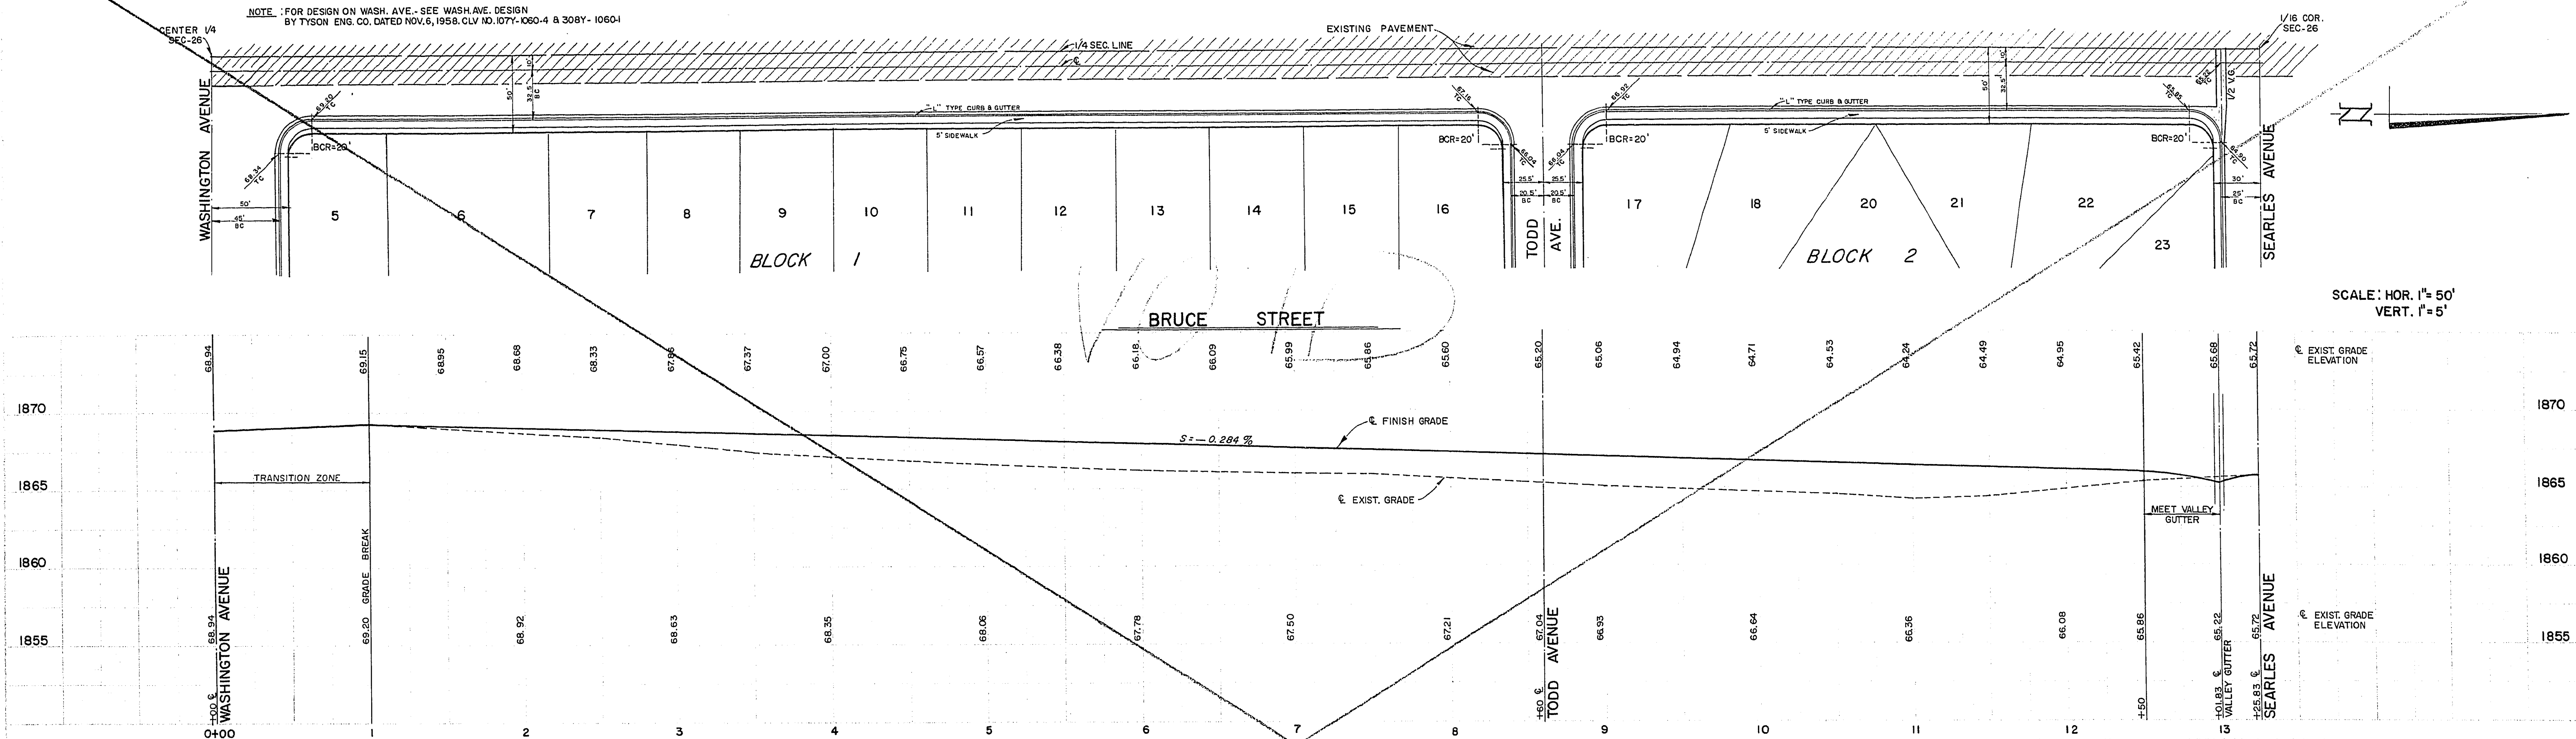

ENTIRE SHEET IS VOID - SEE DESIGNS BY WESTERN ENG - SHEETS #

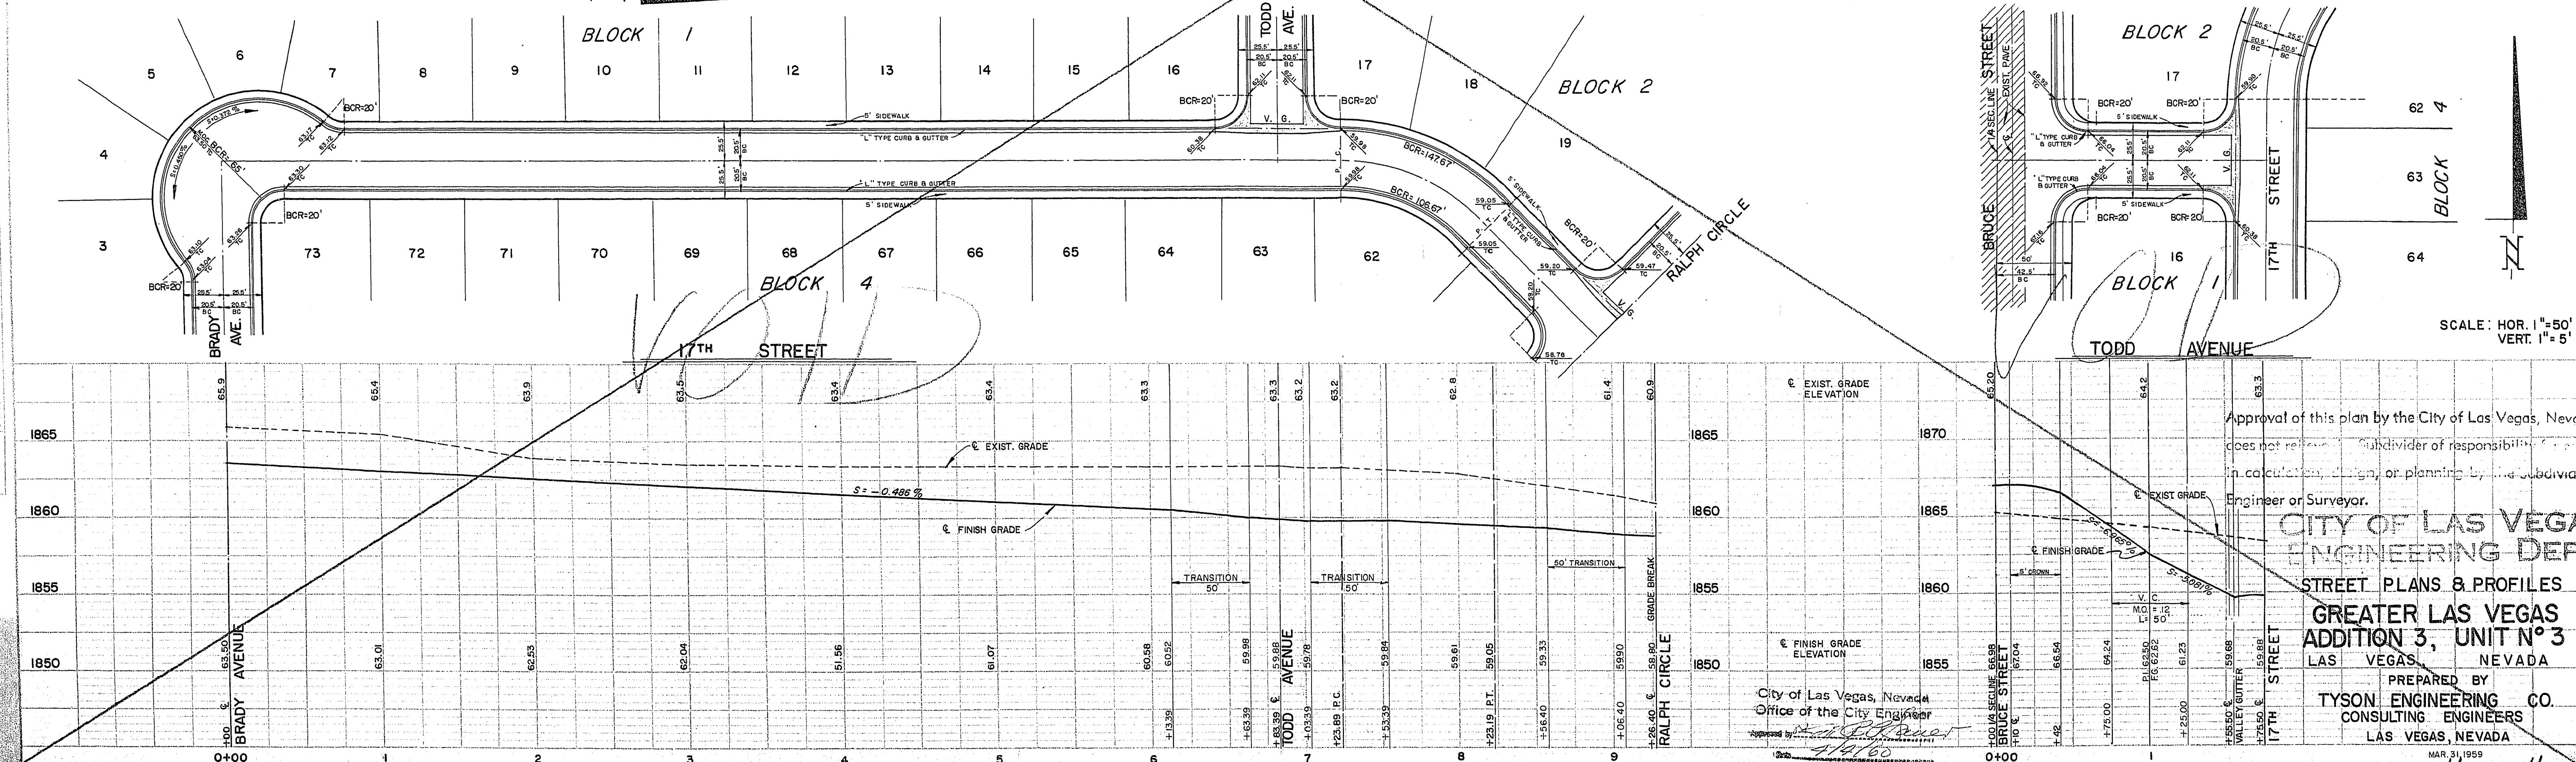

Approval of this plan by the City of Las Vegas, Nevada
does not relieve the subdivider of responsibility for
in calculation, design, or planning by the subdivider's
Engineer or Surveyor.

CITY OF LAS VEGAS
ENGINEERING DEPT.

STREET PLANS & PROFILES
GREATER LAS VEGAS
ADDITION 3, UNIT N°3
LAS VEGAS, NEVADA

PREPARED BY
TYSON ENGINEERING CO.
CONSULTING ENGINEERS
LAS VEGAS, NEVADA

MAR 31 1959
SHEET 2 OF 4

1071-1640-3-3