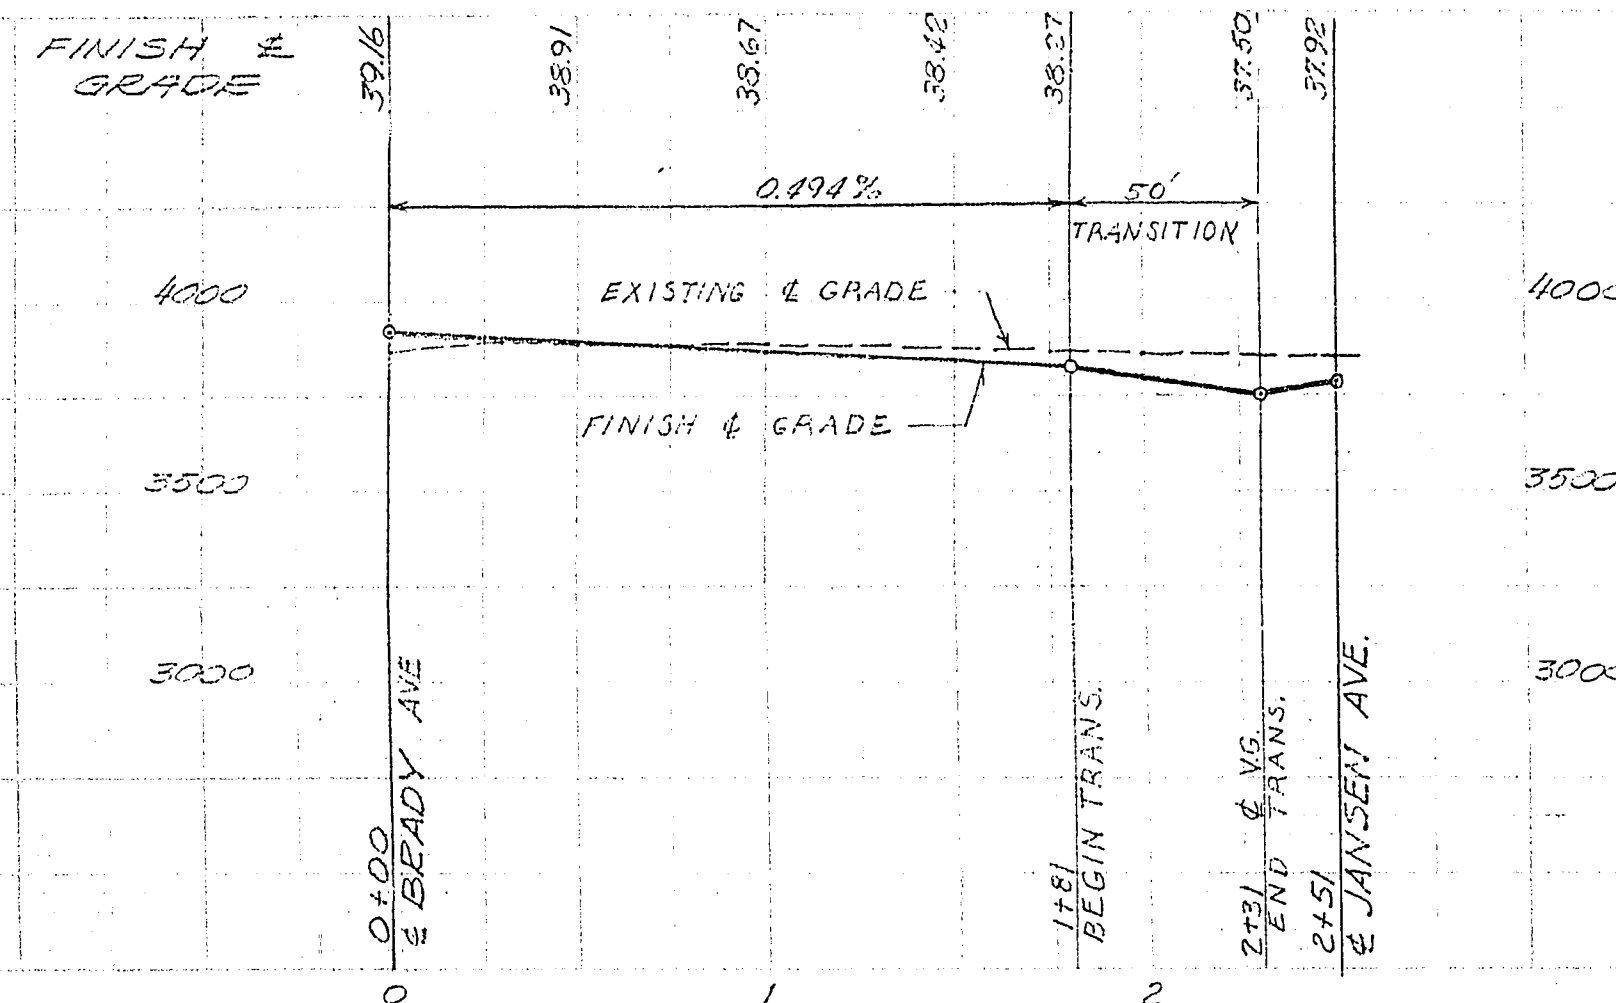


18.40

1835

APPROVALS

CITY ENGINEER

DATE

FIELD ENGINEER

DATE

12-30-64 C.B.G. C.B.G. C.B.G.	D 25 th ST. Modifications	RGA	JRM
	E REVG GRADES 25 th WASHINGTON	M	W.H.
	F Curb/gas grading at 25 th Street	23	11/9/64
	A Changed grades on 25 th to Meet Existing	DEF	W.H.
	REV. DESCRIPTION	BY	APPR
GREATER LAS VEGAS			
ADDITION N ^o 3 UNIT 5A			
STREET PLAN & PROFILE			
SCALE		HORIZ 1"=50'	VERT 1"=5'
DESIGNED	WESTERN ENGINEERS, INC.		SHEET 3
DRAWN	LAS VEGAS NEVADA		
CHECKED	APPROVED <i>William Miller</i> DATE 12/15/64		

1074-164035A