



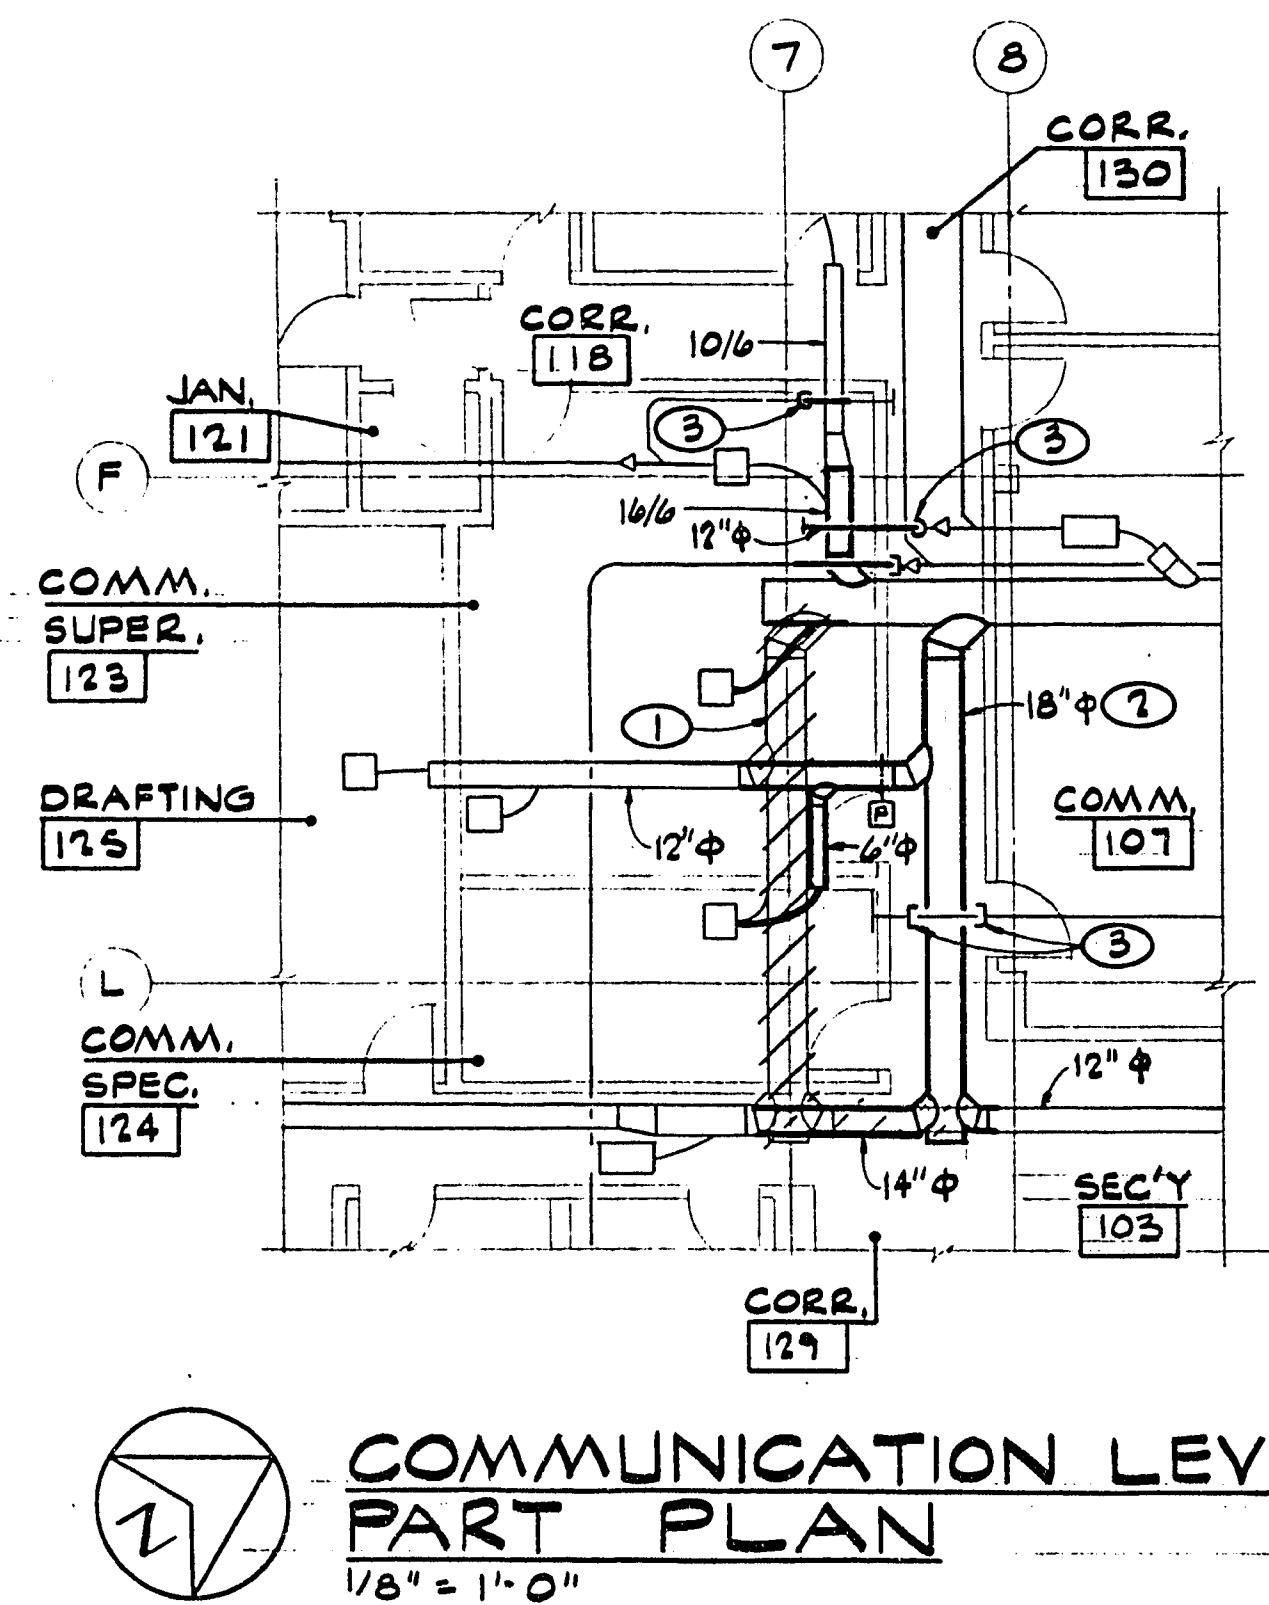

- NOTES**
- 18" ϕ DUCT TO BE RELOCATED.
 - RELOCATED 18" ϕ DUCT.
 - RISE BETWEEN WIDE FLANGE SIZE OF DUCTWORK TO REMAIN AS SHOWN ON ORIGINAL BID SET OF PLANS.
- GENERAL NOTES**
- REVISED DUCTWORK SHOWN HEAVY, LIGHT DUCTWORK AS SHOWN ON ORIGINAL BID SET.
 - REFER TO ORIGINAL BID SET OF PLANS FOR SIZES AND CONDITIONS NOT SHOWN ON THIS PART PLAN.

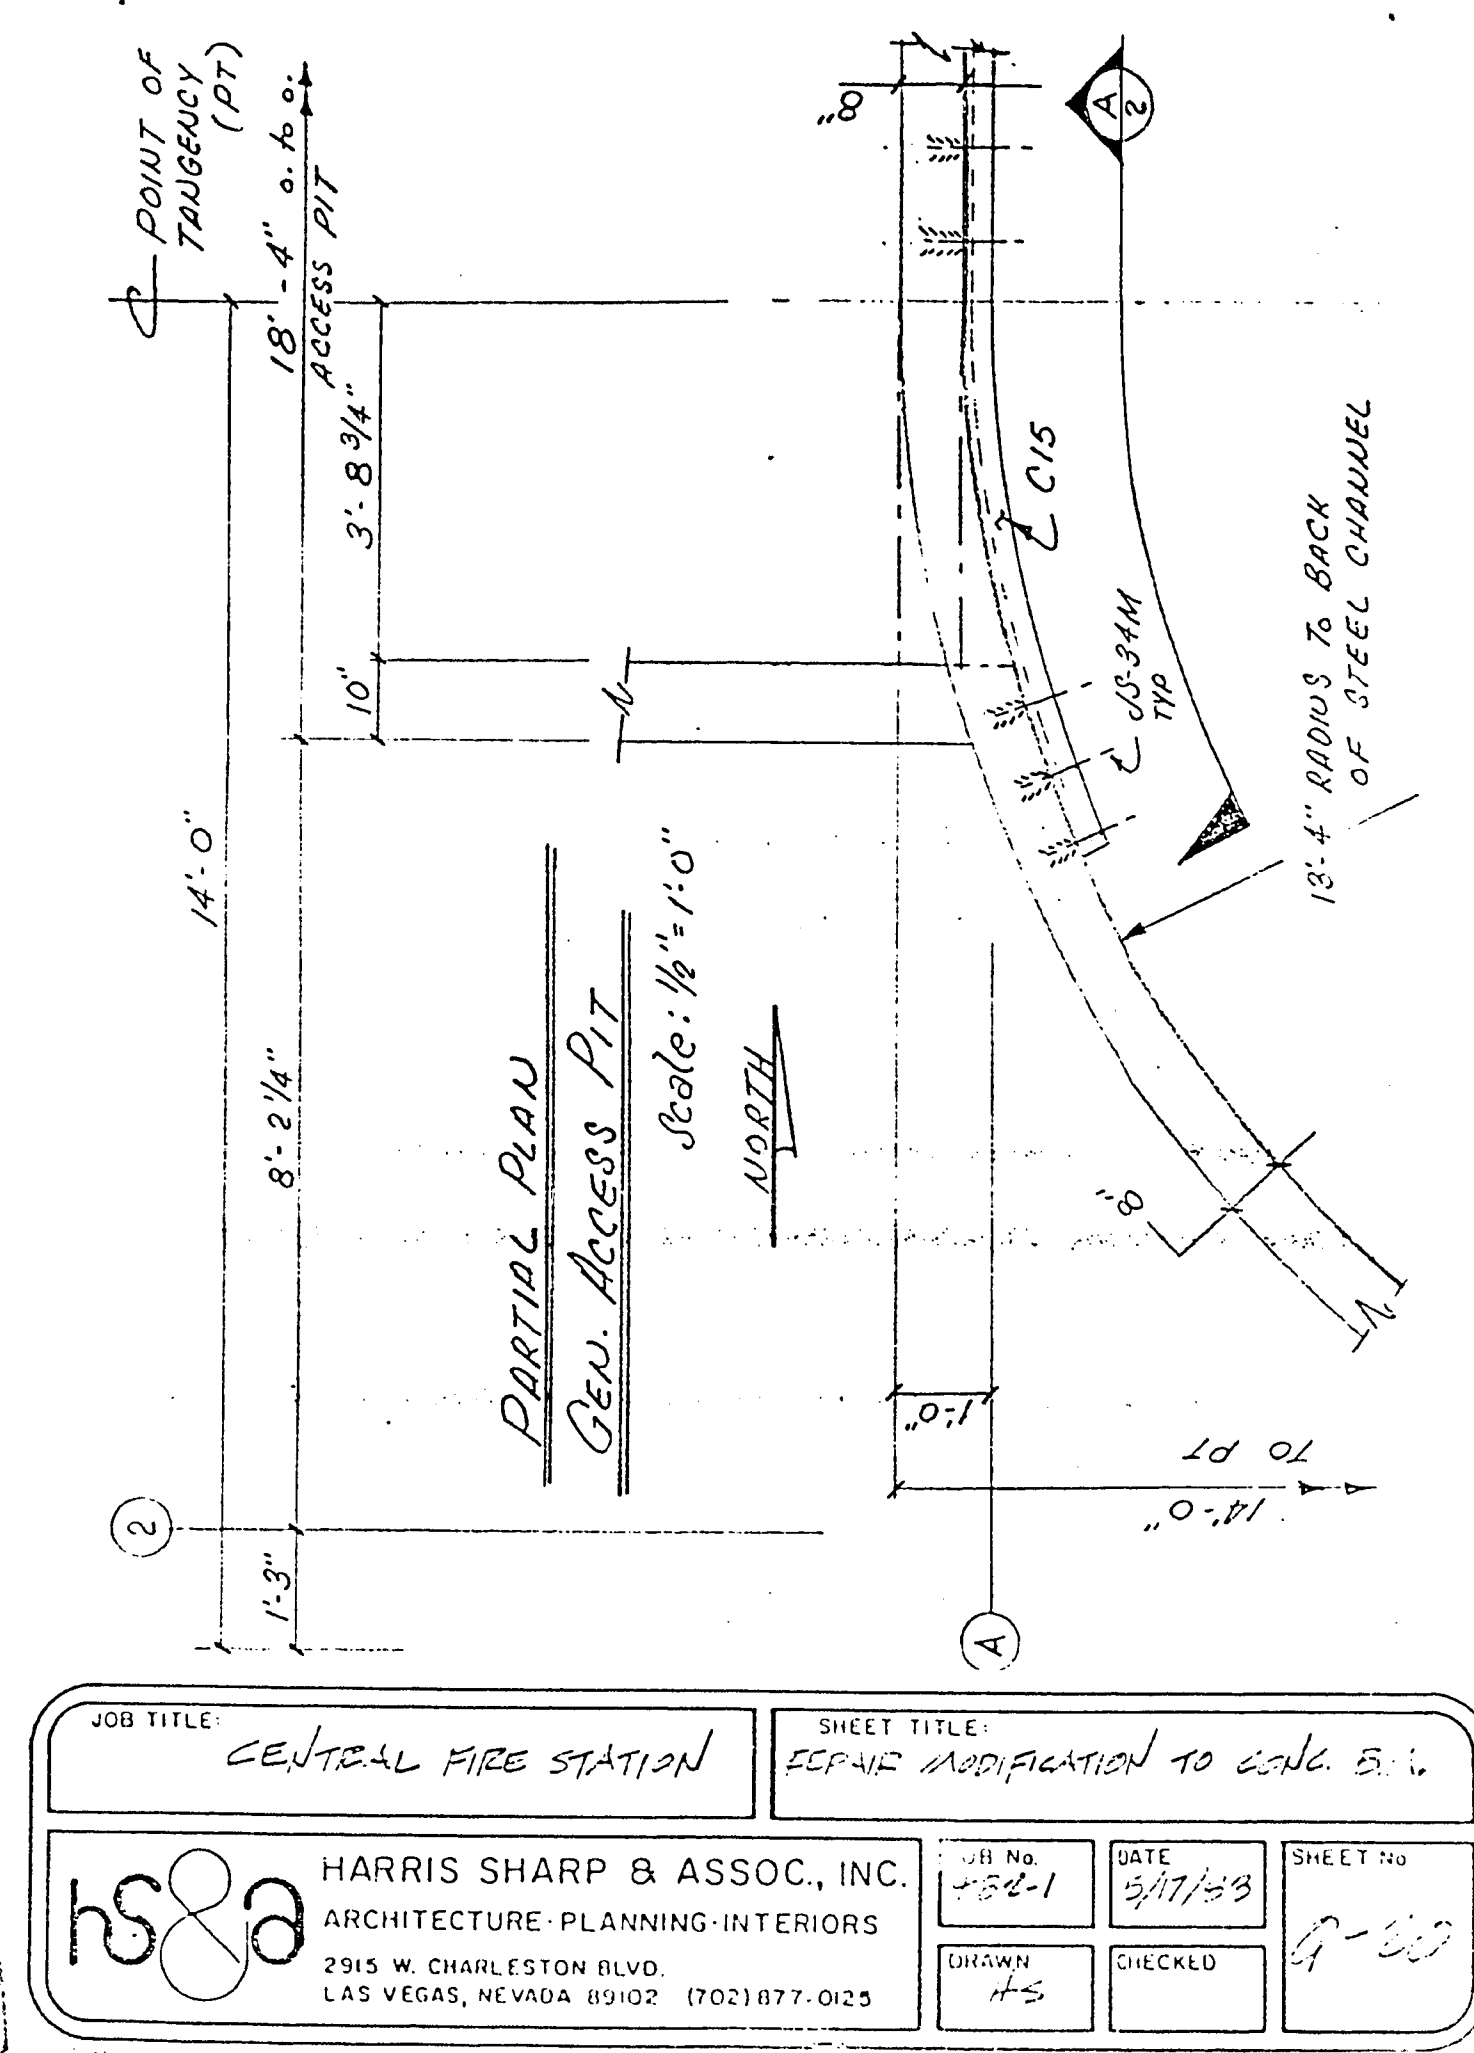

JOB TITLE: CENTRAL FIRE STATION		SHEET TITLE: REPAIR MODIFICATION TO CONC. B.I.L.	
HARRIS SHARP & ASSOC., INC. ARCHITECTURE-PLANNING-INTERIORS 2915 W. CHARLESTON BLVD. LAS VEGAS, NEVADA 89102 (702) 877-0125		DESIGNED BY: HS CHECKED BY: HS	DATE: 3/17/83 SHEET NO: 9-50

CENTRAL FIRE STATION	REVISED COMM. LEVEL A/C PART. PLAN	DATE: 6-10-83 SHEET NO: 482-1	DESIGNED BY: LE CHECKED BY: EPB
HARRIS SHARP & ASSOC., INC. ARCHITECTURE-PLANNING-INTERIORS 2915 W. CHARLESTON BLVD. LAS VEGAS, NEVADA 89102 (702) 877-0125			

jba CONSULTING ENGINEERS		Job No. 3115	
Job Title: CENTRAL FIRE STATION AIR CONDITIONING REVISION		By: L.E. Checked: E.P.B. Sheet: 1	Date: 6-6-83 Date: 6-6-83 Of: 1

Department of Design and Development

CENTRAL FIRE STATION

REVISIONS AND/OR CLARIFICATION

Revisions	Date

Civil Engineering Division

Scale (h)	Scale (v)	W.A.
Fid. bk. no.	Date	
Design by	Drawn by	
Approved by		Date

Revisions

Revisions	Date

City of Las Vegas

CLERK OF THE CITY

630-74

830-74