

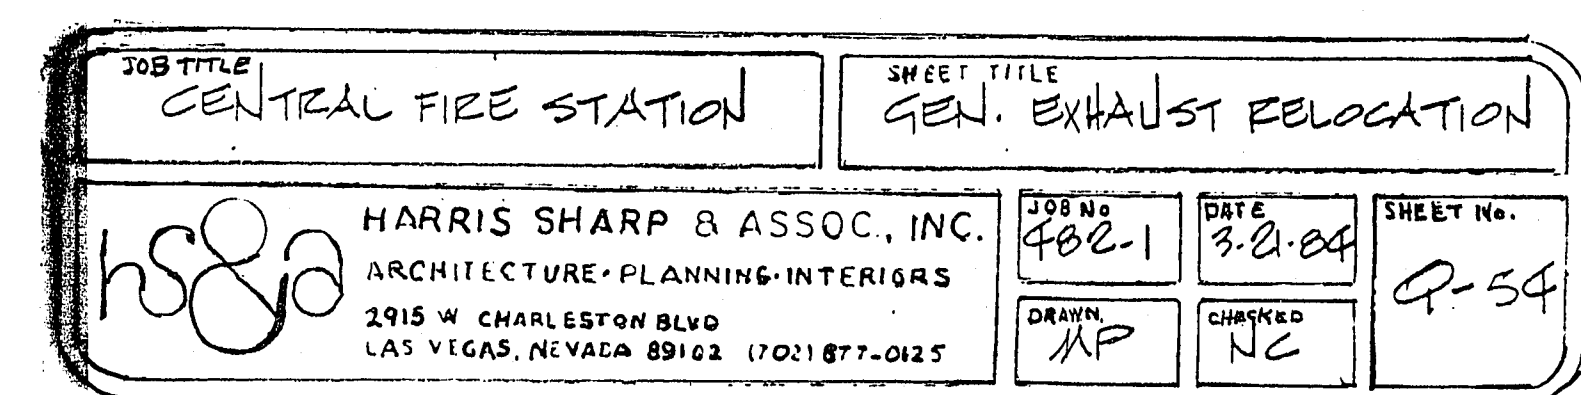
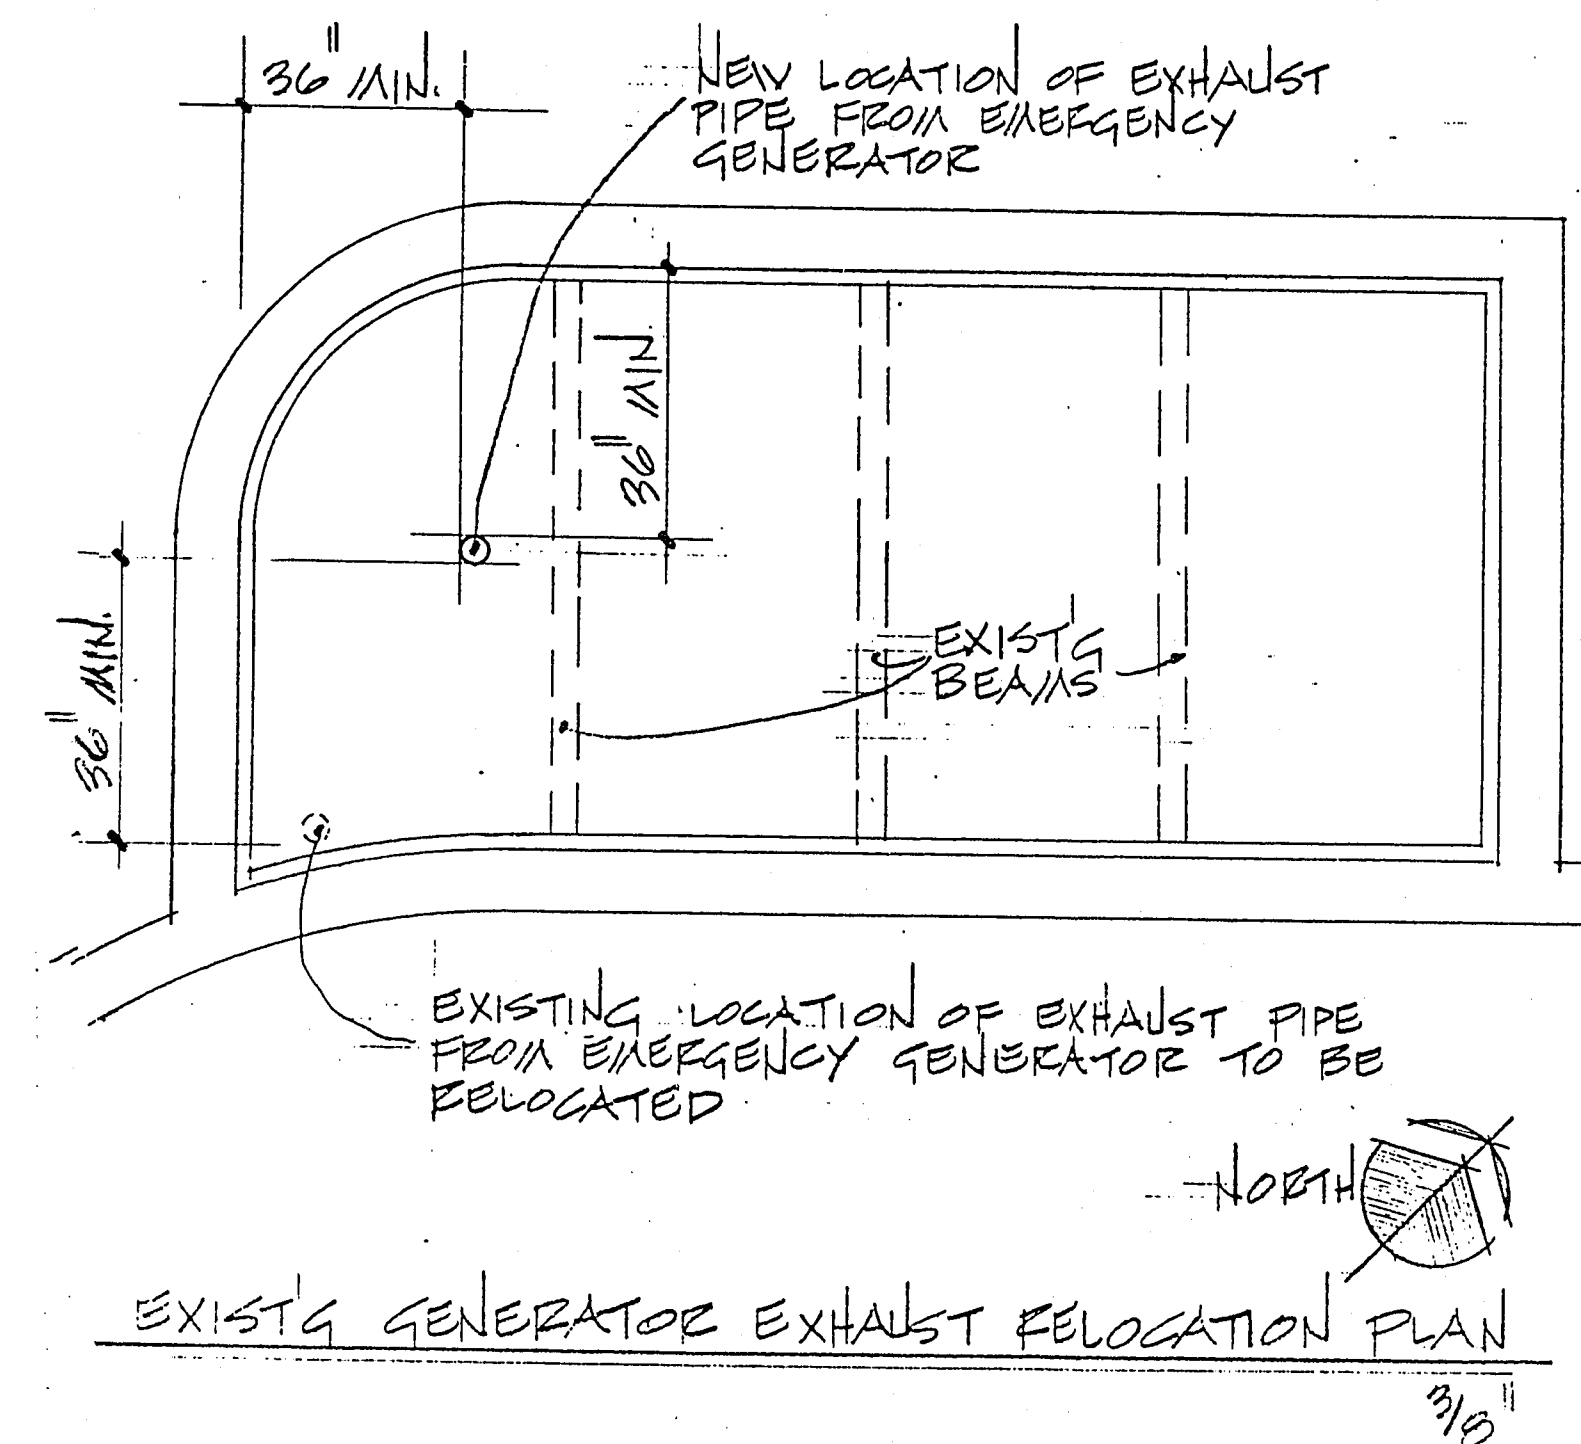


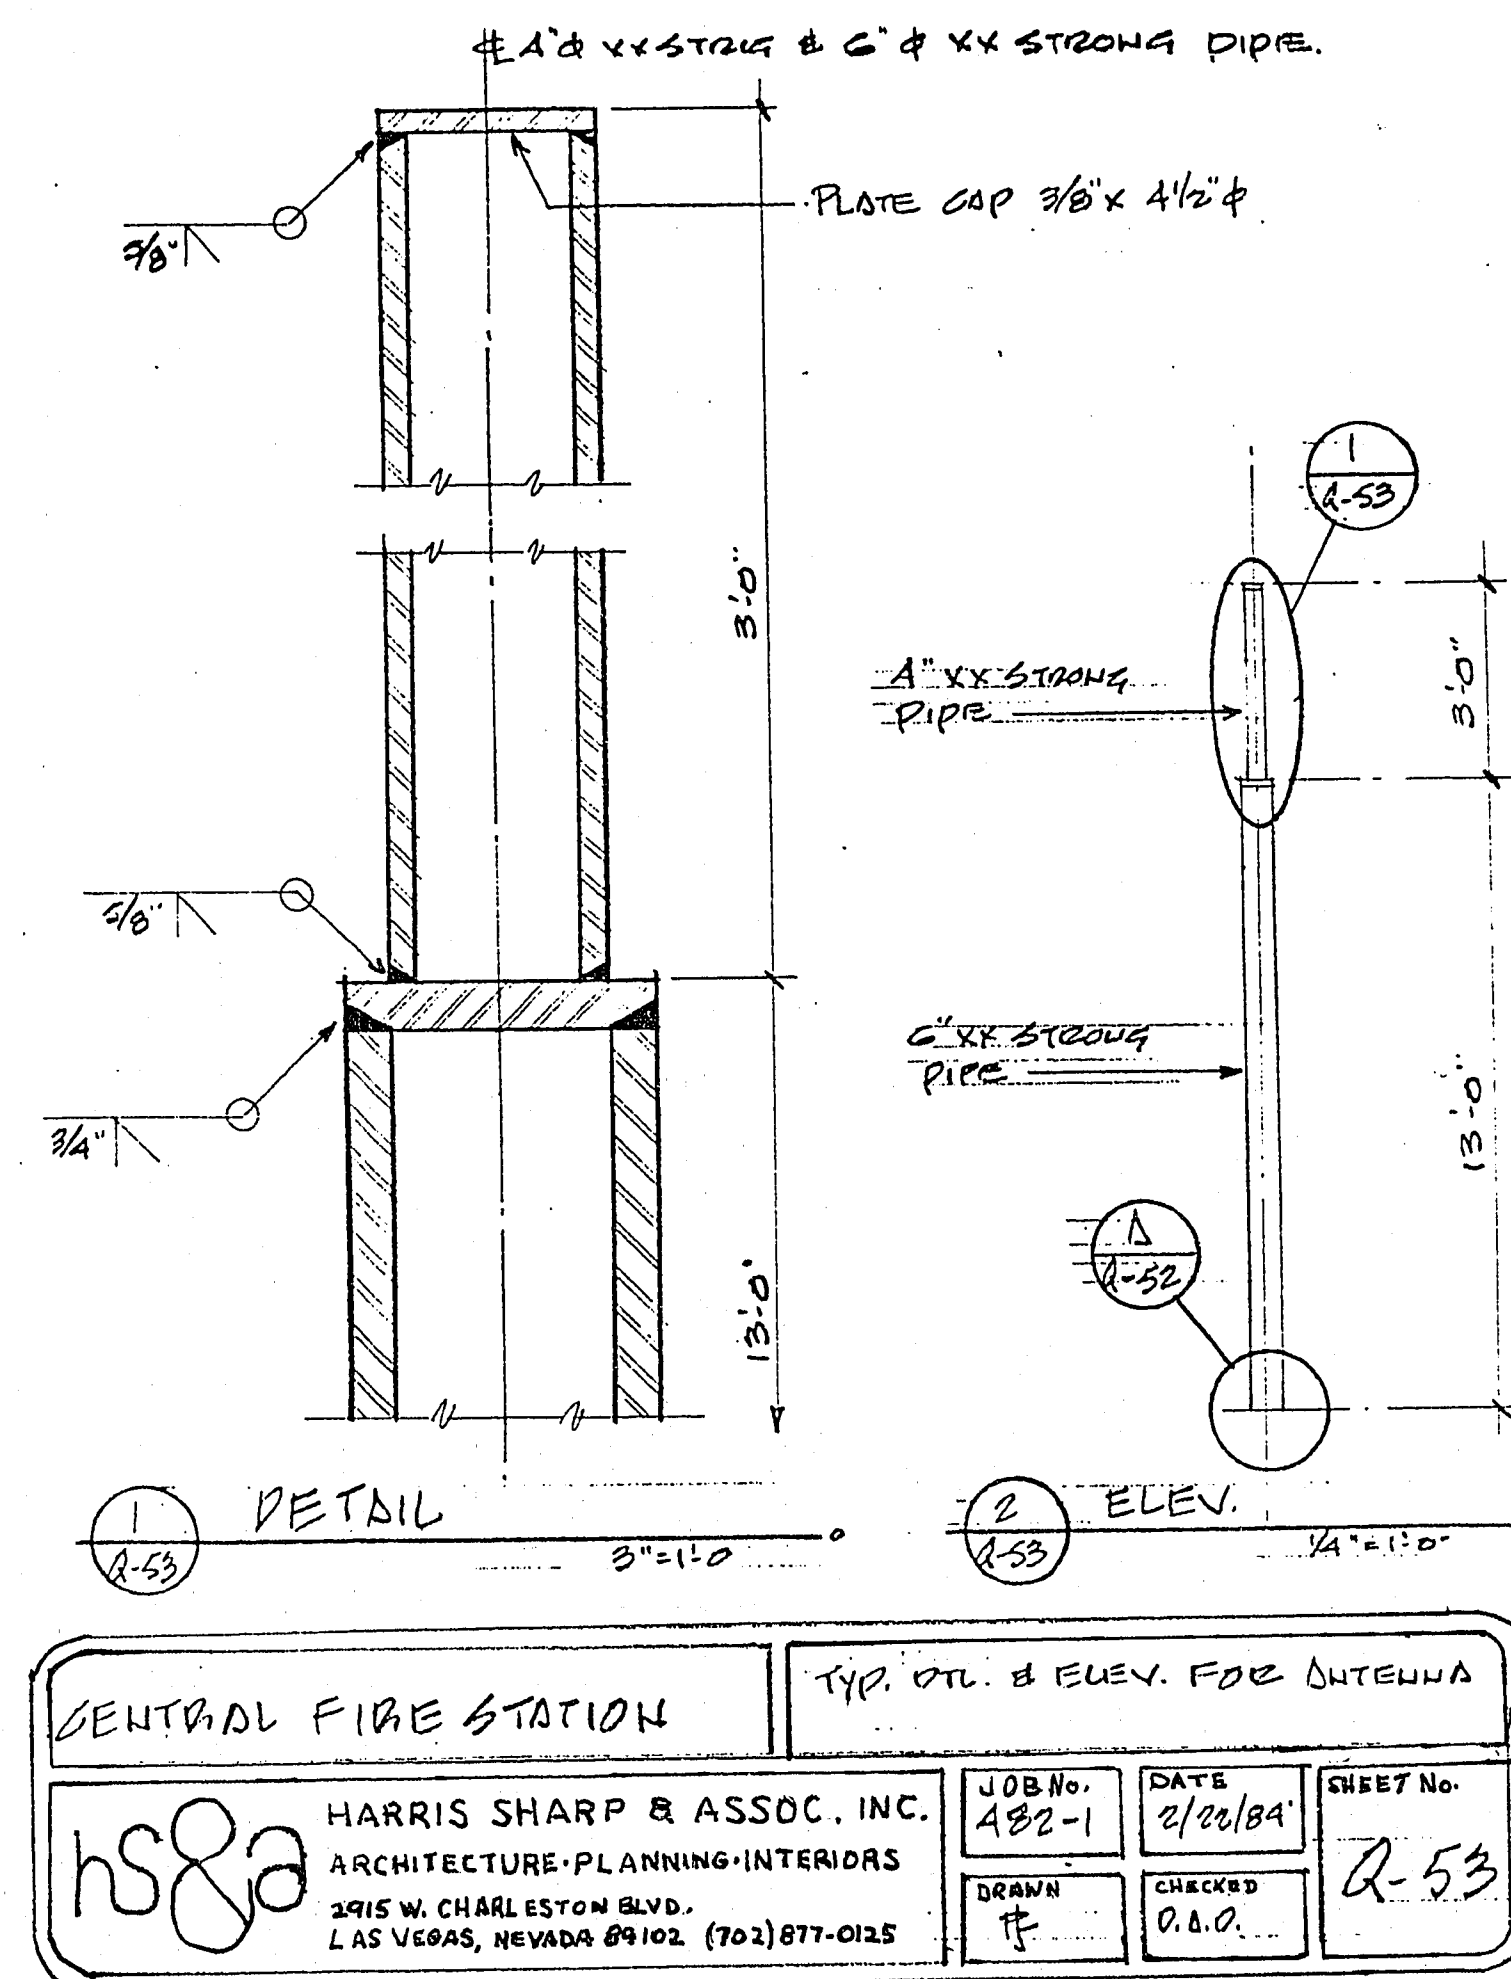

 Drawing no. 630-74	Department of Public Works Engineering Design Division				Scale (h)	Scale (v)	W.A.	
	CENTRAL FIRE STATION		REVISIONS AND/OR CLARIFICATION		Fid. bk. no.	Date		
					Design by		Drawn by	
							Revisions	Date

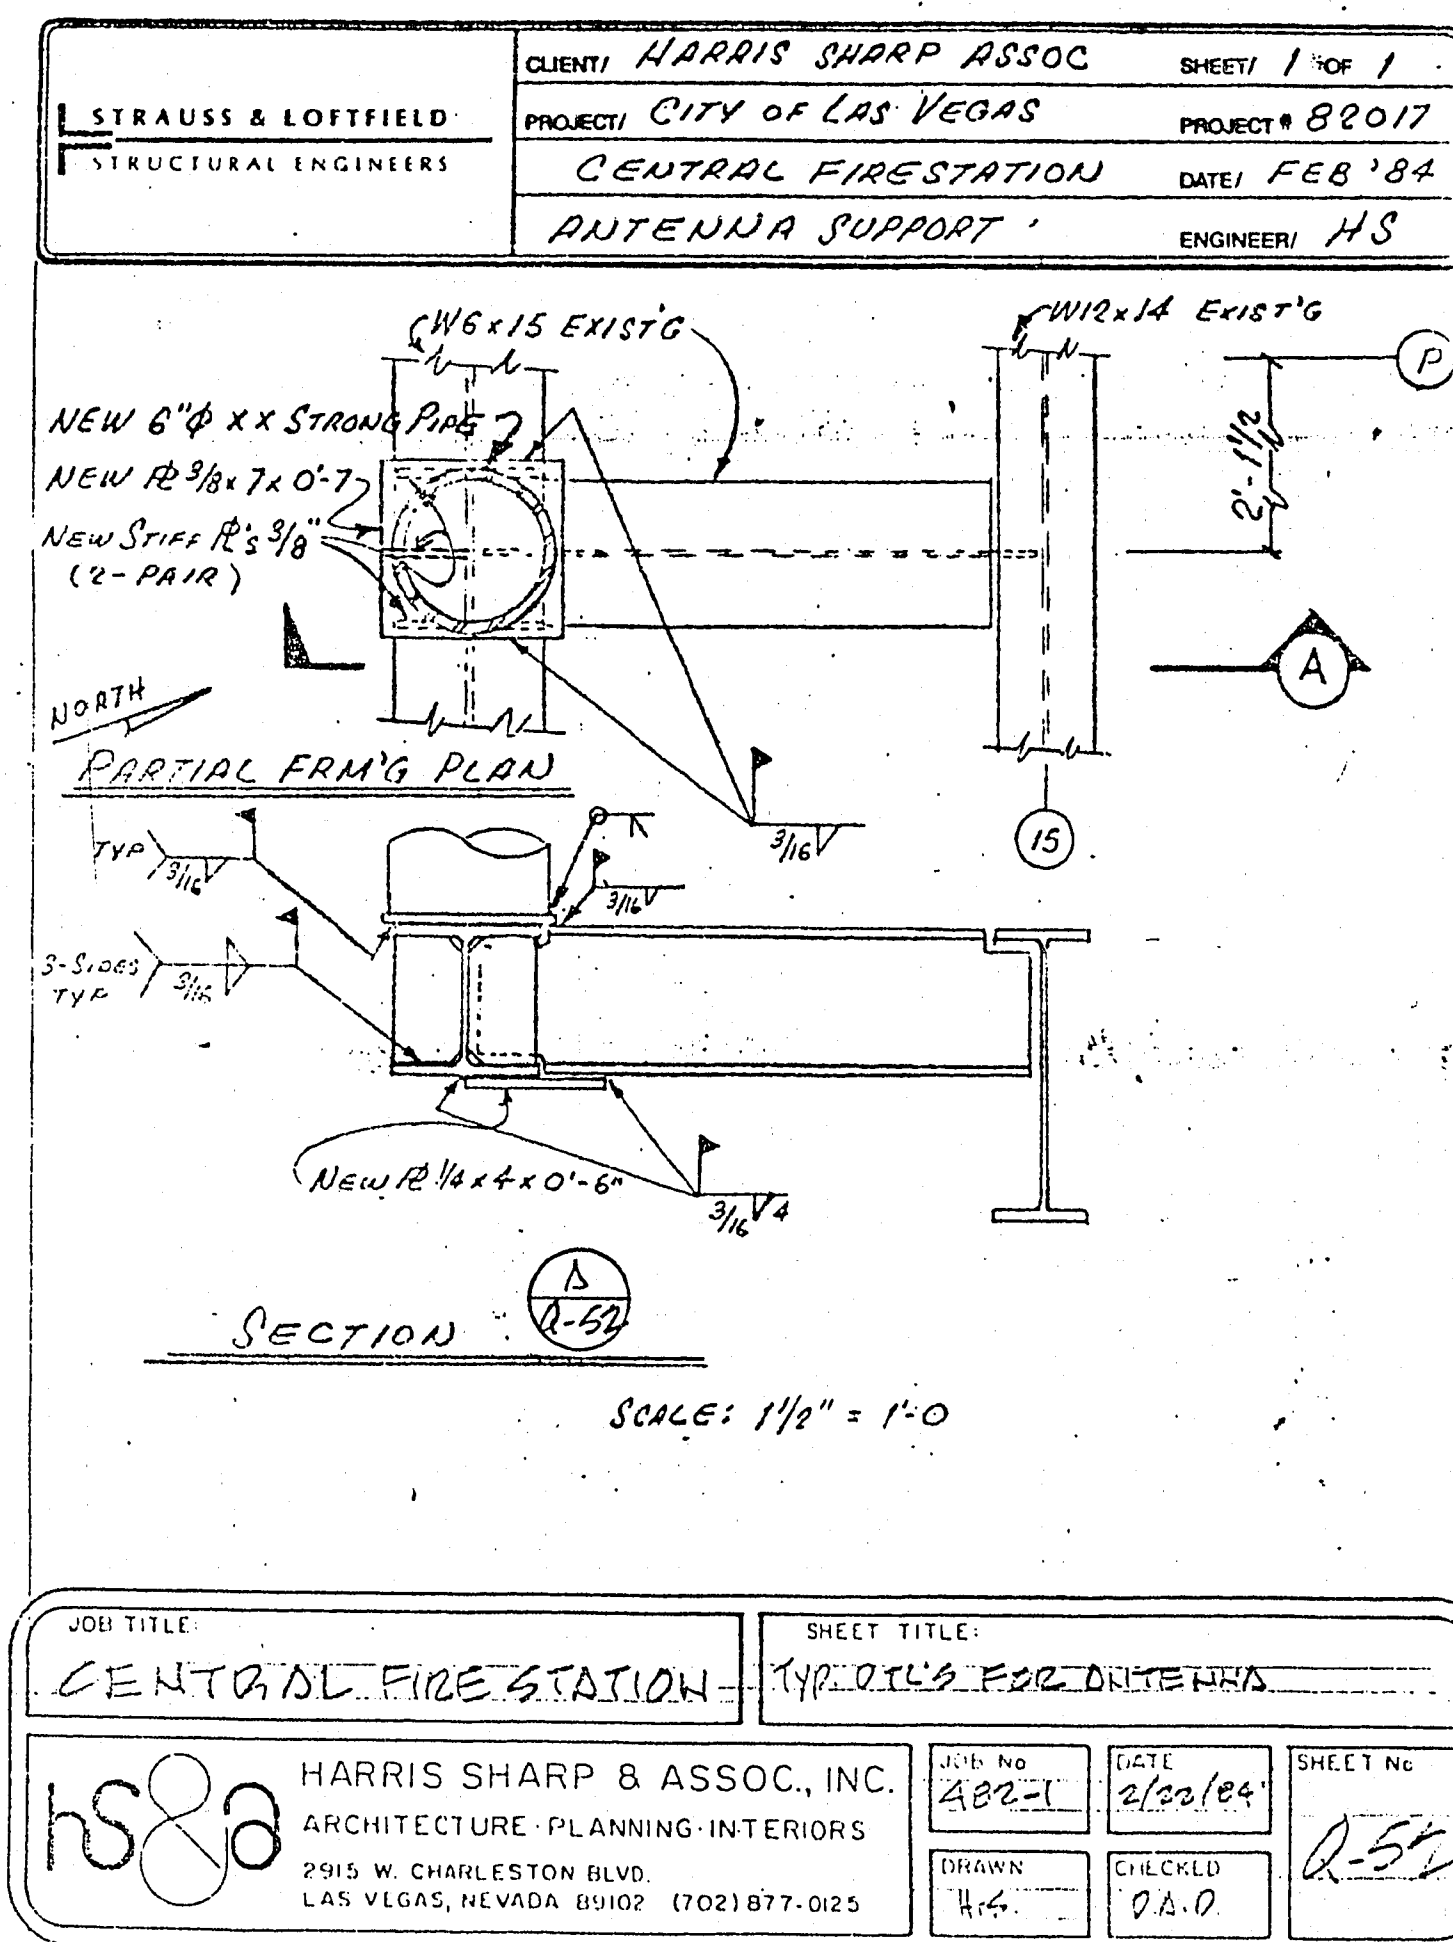