




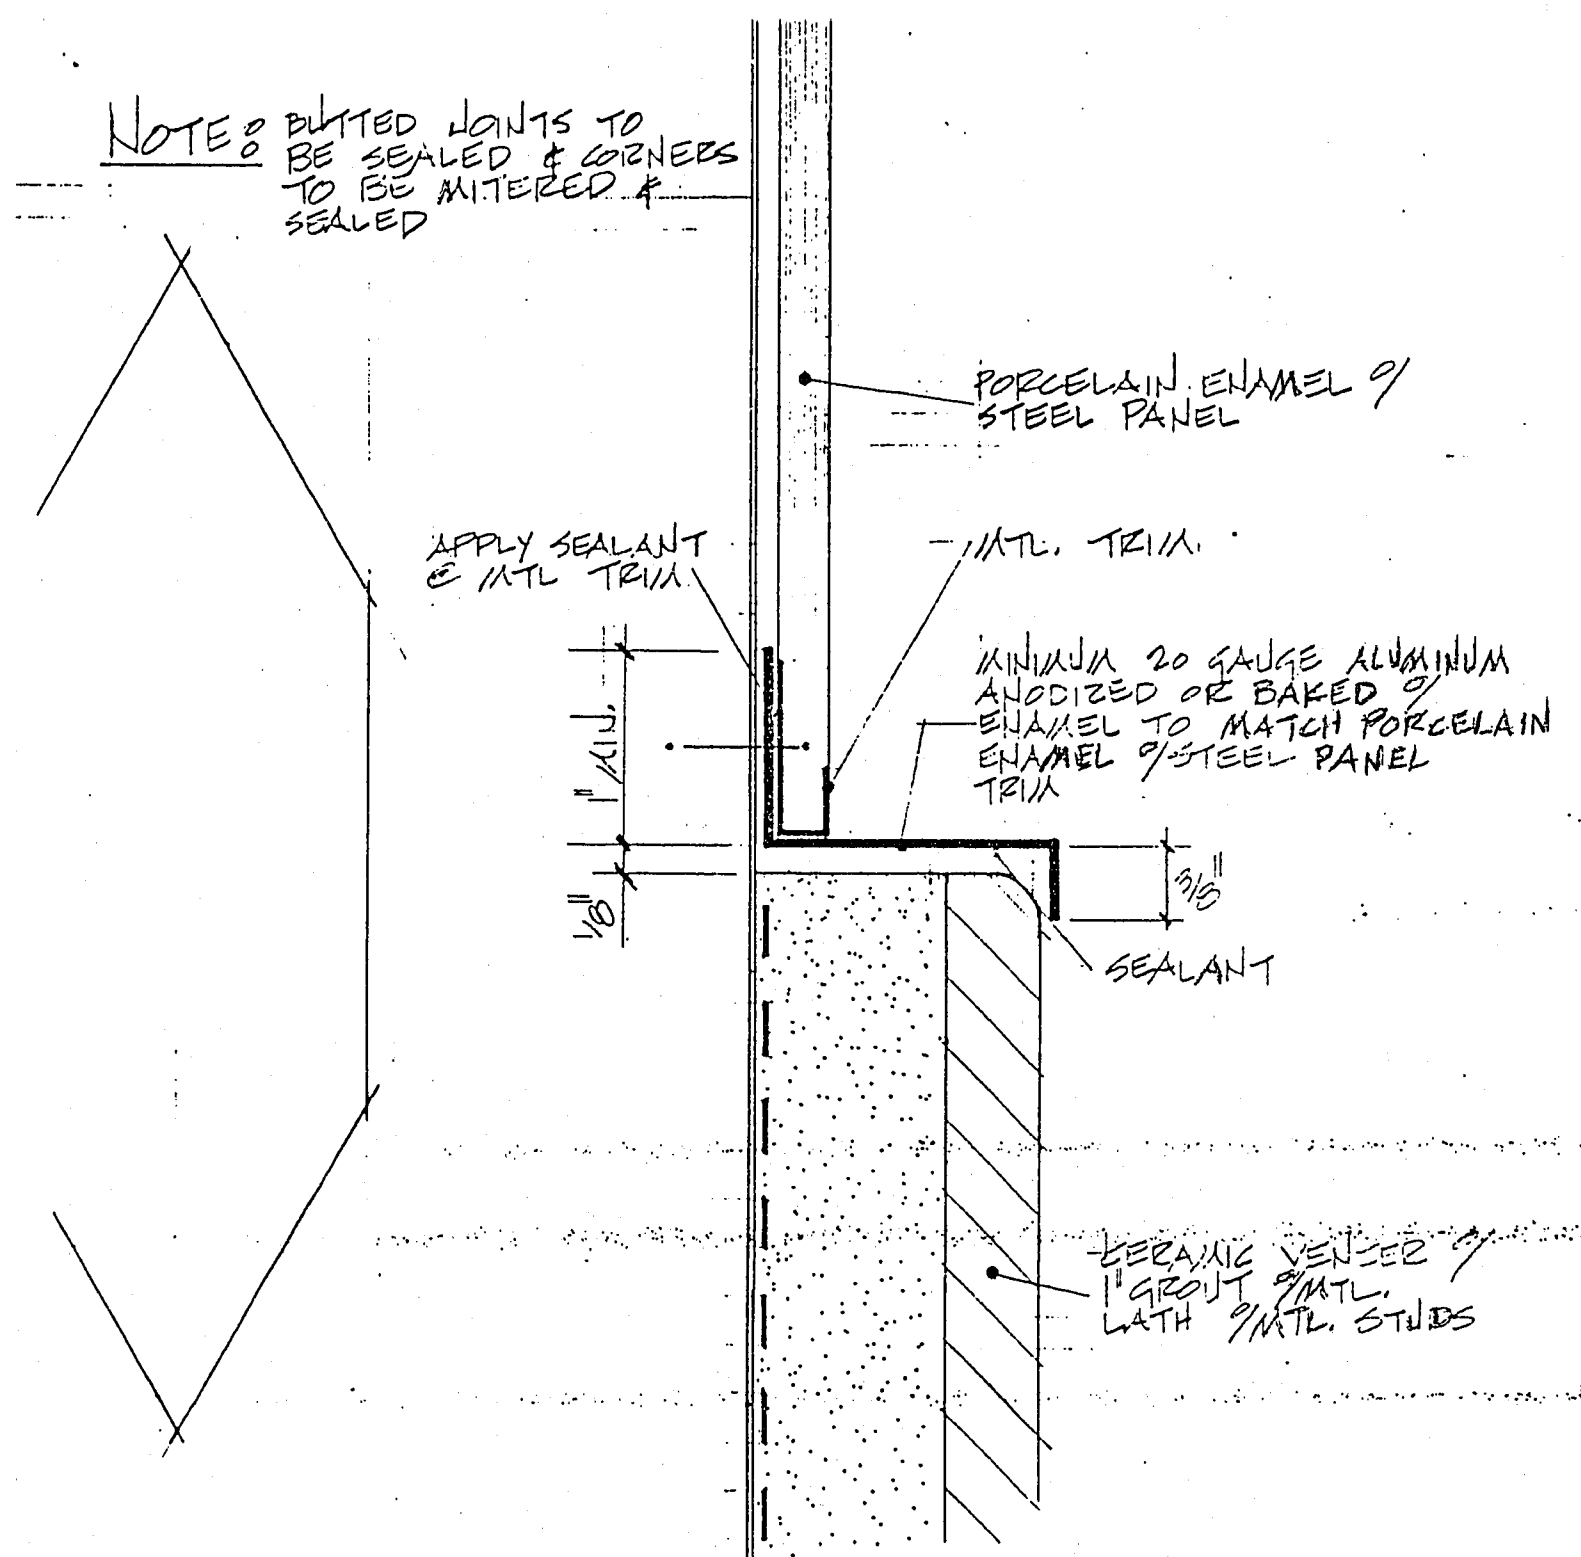

JOB TITLE: CENTRAL FIRE STATION		SHEET TITLE: INTERSECTION OF STL. FACED PANEL W/ CERAMIC VENEER	
 HARRIS SHARP & ASSOC., INC. ARCHITECTURE-PLANNING-INTERIORS 2915 W. CHARLESTON BLVD. LAS VEGAS, NEVADA 89102 (702) 877-0125	JOB No. 482-1	DATE 8-2-83	SHEET No. Q-31
DRAWN SAC	CHECKED NC		

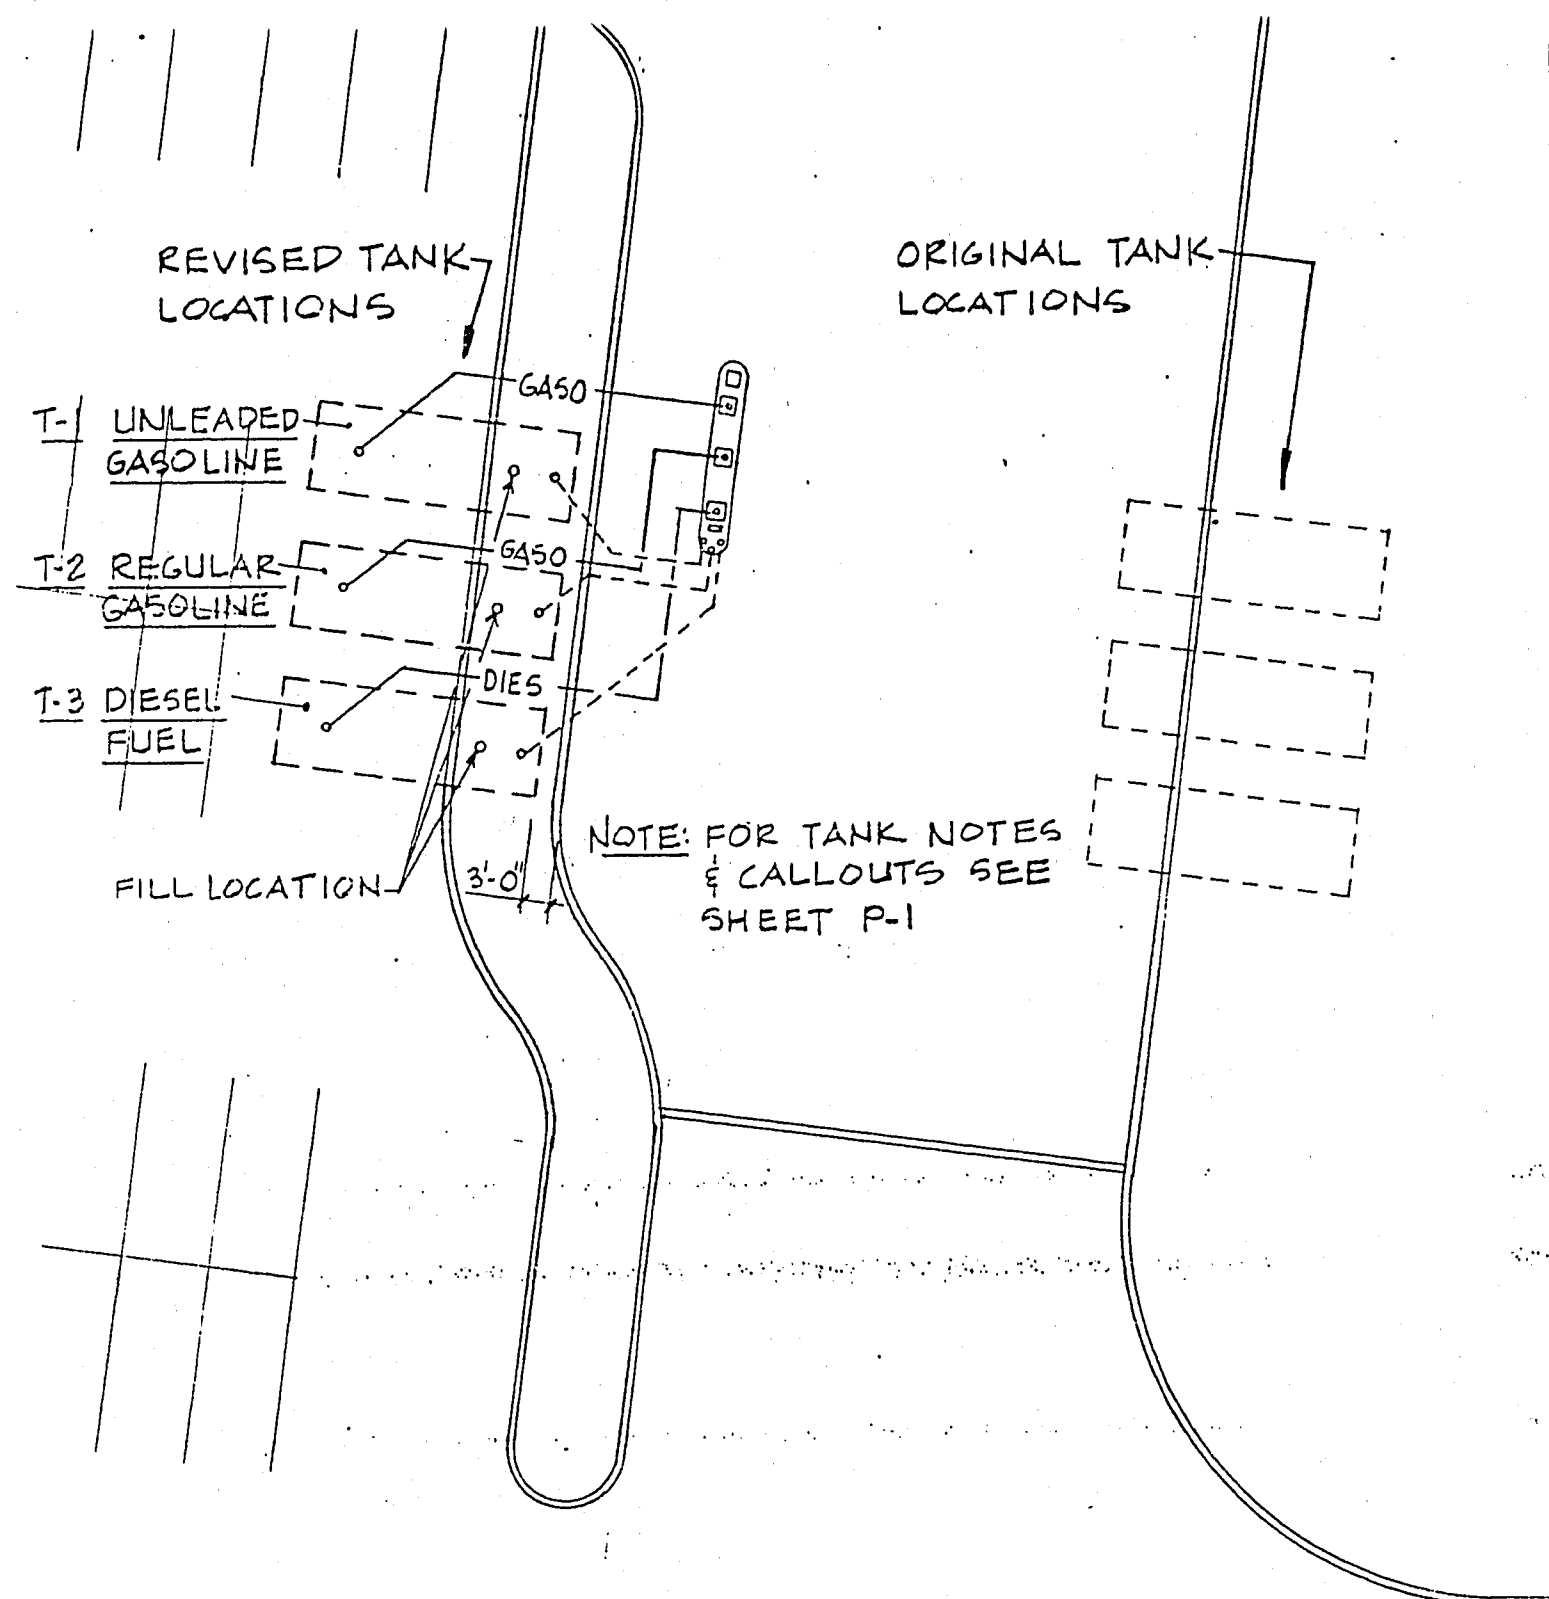

JOB TITLE: CENTRAL FIRE STATION		SHEET TITLE: REVISED FUEL TANK LOCATION	
 HARRIS SHARP & ASSOC., INC. ARCHITECTURE-PLANNING-INTERIORS 2915 W. CHARLESTON BLVD. LAS VEGAS, NEVADA 89102 (702) 877-0125	JOB No. 482-1	DATE 8-29-83	SHEET No. Q-32
DRAWN SAC	CHECKED NC		

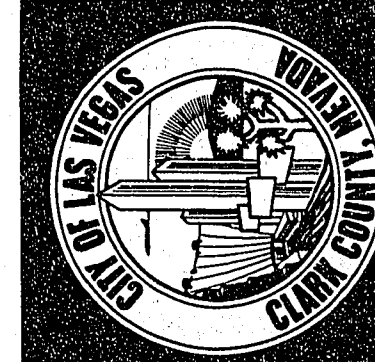

Drawing no.
630-74

Department of Public Works Engineering Design Division

REVISIONS AND/OR
CLARIFICATION

CENTRAL FIRE STATION

Scale (h)	Scale (v)	W.A.
Fid. bk. no.	Date	Drawn by
Design by		

Revisions

Date