STRAUSS & LOFTFIELD
STRUCTURAL ENGINEERS

CLIENT/ HARRIS SHARP & ASSOC. SHEET/ 1 OF 2
PROJECT/ CITY OF LAS VEGAS PROJECT # 8207
CENTRAL FIRE STATION DATE/ OCT-'83
STAIR Nº5 MODIFICATION #2 ENGINEER/ HS

NOTE: FIELD VERIFY ALL DIMENSIONS

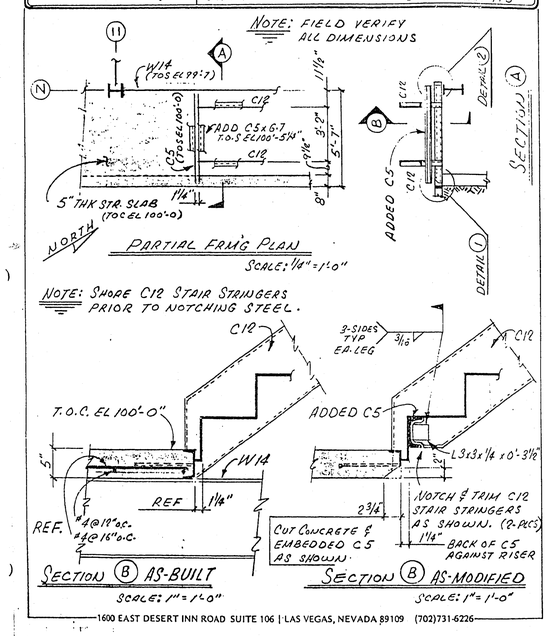

1600 EAST DESERT INN ROAD SUITE 106 | LAS VEGAS, NEVADA 89109 (702)731-6226

JOB TITLE: CENTRAL FIRE STATION
SHEET TITLE: STAIR Nº 5 MODIFICATION #2
HARRIS SHARP & ASSOC., INC.
ARCHITECTURE·PLANNING·INTERIORS
2915 W. CHARLESTON BLVD.
LAS VEGAS, NEVADA 89102 (702) 877-0125
JOB No. 479-5 | DATE 10/17/83 | SHEET No. Q-36

STRAUSS & LOFTFIELD
STRUCTURAL ENGINEERS

CLIENT/ HARRIS SHARP & ASSOC SHEET/ 2 OF 2
PROJECT/ CITY OF LAS VEGAS PROJECT # 82017
CENTRAL FIRE STATION DATE/ 7 OCT-'83
STAIR Nº5 MODIFICATION #2 ENGINEER/ HS

CONNECTION DETAILS

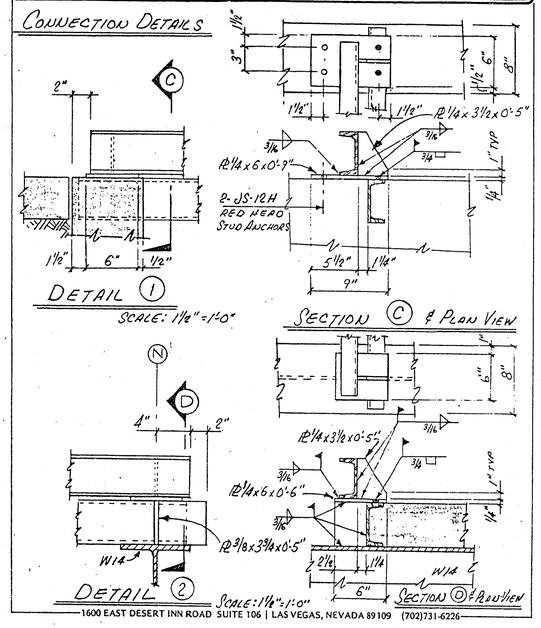

1600 EAST DESERT INN ROAD SUITE 106 | LAS VEGAS, NEVADA 89109 (702)731-6226

JOB TITLE: CENTRAL FIRE STATION
SHEET TITLE: STAIR Nº5 MODIFICATION
HARRIS SHARP & ASSOC., INC.
ARCHITECTURE·PLANNING·INTERIORS
2915 W. CHARLESTON BLVD.
LAS VEGAS, NEVADA 89102 (702) 877-0125
JOB No. 487-1 | DATE 10/17/83 | SHEET No. Q-37
DRAWN | CHECKED

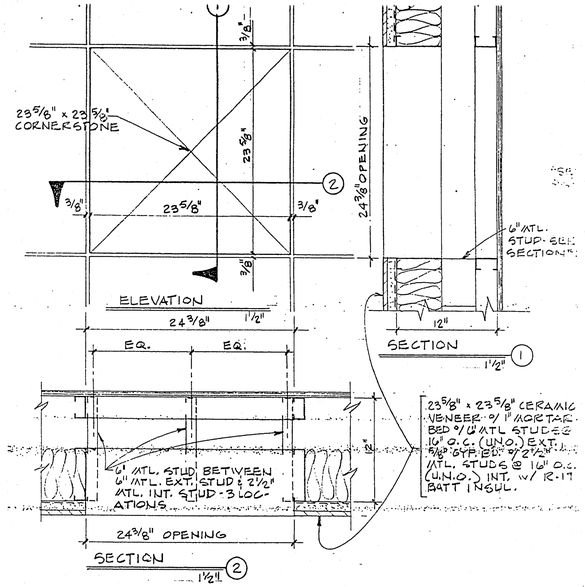

JOB TITLE: CENTRAL FIRE STATION
SHEET TITLE: CORNERSTONE OPENING DETAILS
HARRIS SHARP & ASSOC., INC.
ARCHITECTURE·PLANNING·INTERIORS
2915 W. CHARLESTON BLVD.
LAS VEGAS, NEVADA 89102 (702) 877-0125
JOB No. 482-1 | DATE 10-11-83 | SHEET No. Q-38
DRAWN SAC | CHECKED NC

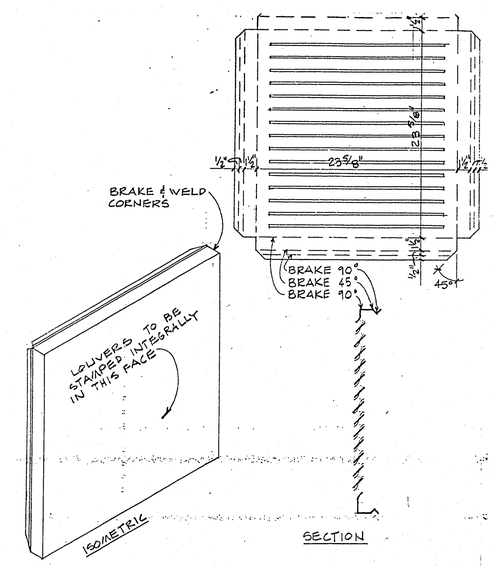

JOB TITLE: CENTRAL FIRE STATION
SHEET TITLE: DETAILS OF SPEAKER COVER
HARRIS SHARP & ASSOC., INC.
ARCHITECTURE·PLANNING·INTERIORS
2915 W. CHARLESTON BLVD.
LAS VEGAS, NEVADA 89102 (702) 877-0125
JOB No. 482-1 | DATE 11/2/83 | SHEET No. Q-39
DRAWN SAC | CHECKED NC

Revisions	Date

Scale (h) | Scale (v) | W.A.
Fld. bk. no. | Date | Drawn by
Design by

Department of Public Works Engineering Design Division

REVISIONS AND/OR CLARIFICATION

CENTRAL FIRE STATION

Drawing no. 630-74