

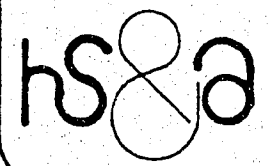


JOB TITLE: CENTRAL FIRE STATION		SHEET TITLE: CAMERA REVISION	
 HARRIS SHARP & ASSOC., INC. ARCHITECTURE · PLANNING · INTERIORS 2915 W. CHARLESTON BLVD LAS VEGAS, NEVADA 89102 (702) 877-0125	JOB No 982-1	DATE 11-10-83	SHEET No Q-40
	DRAWN MP	CHECKED NC	


108 of 119
Dwg. # 630-74

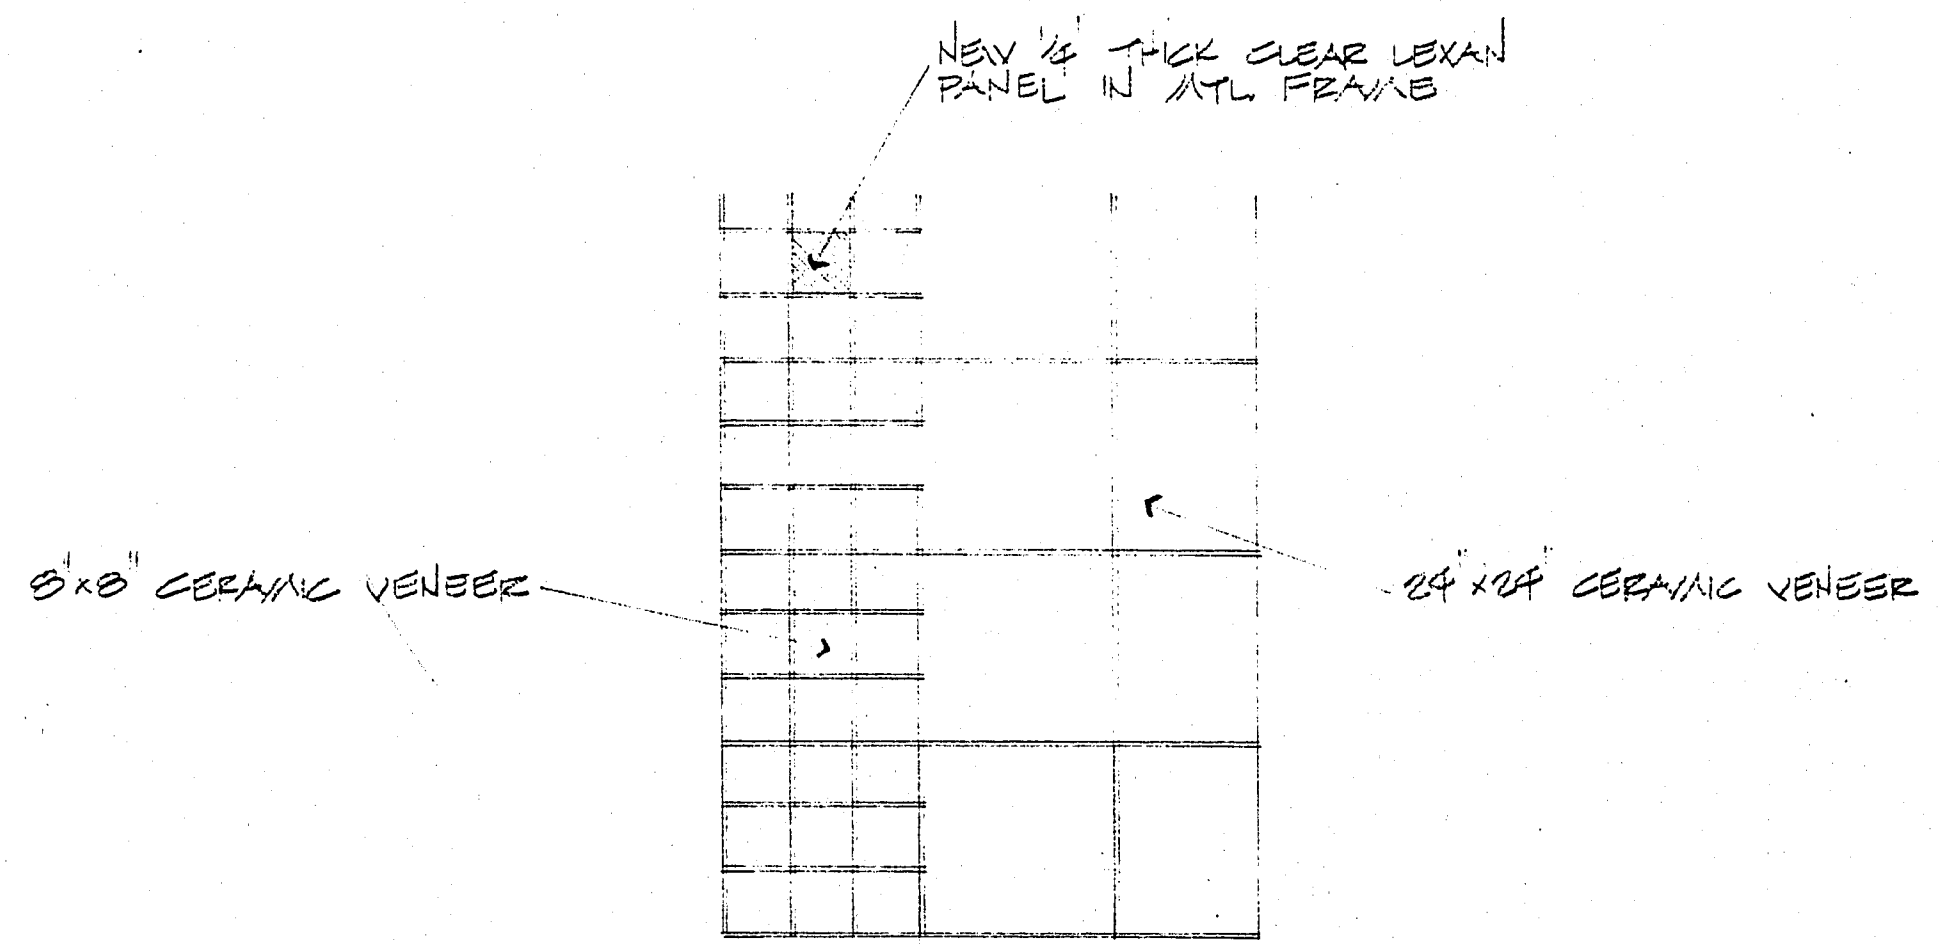

(A) ELEVATION
1/2"

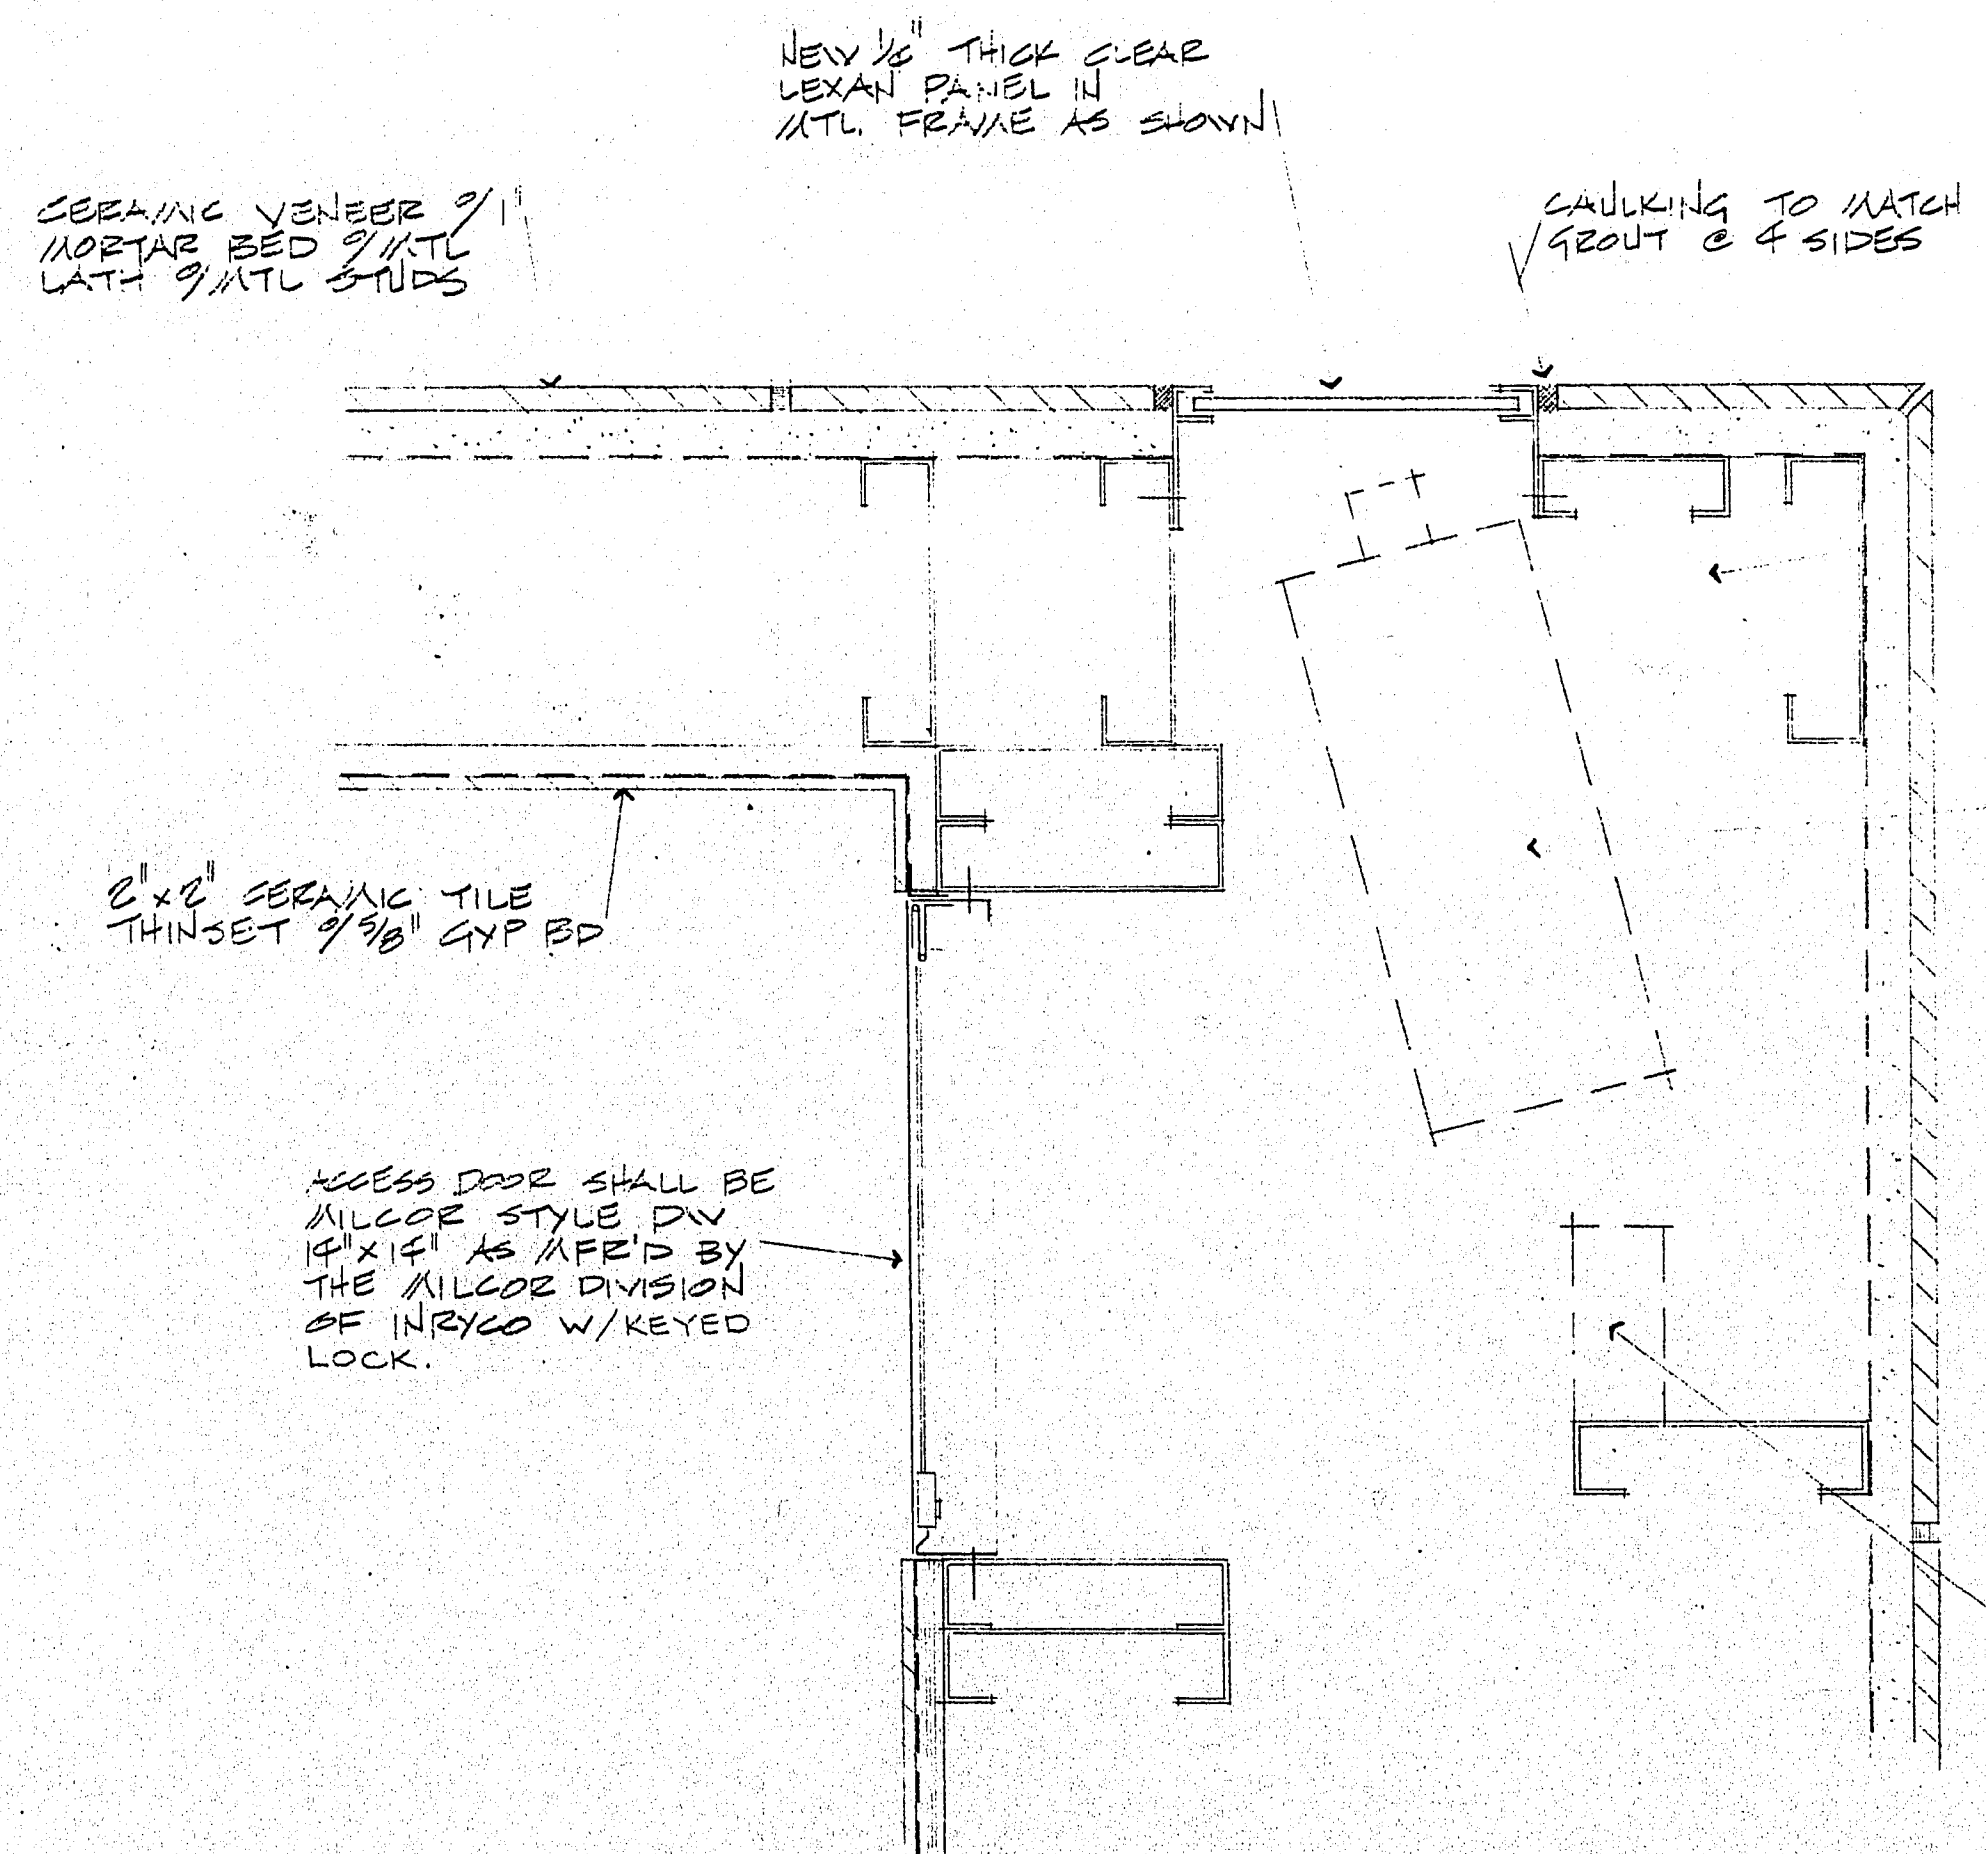

(1) DETAIL AT HIDDEN CAMERA AREA
3"

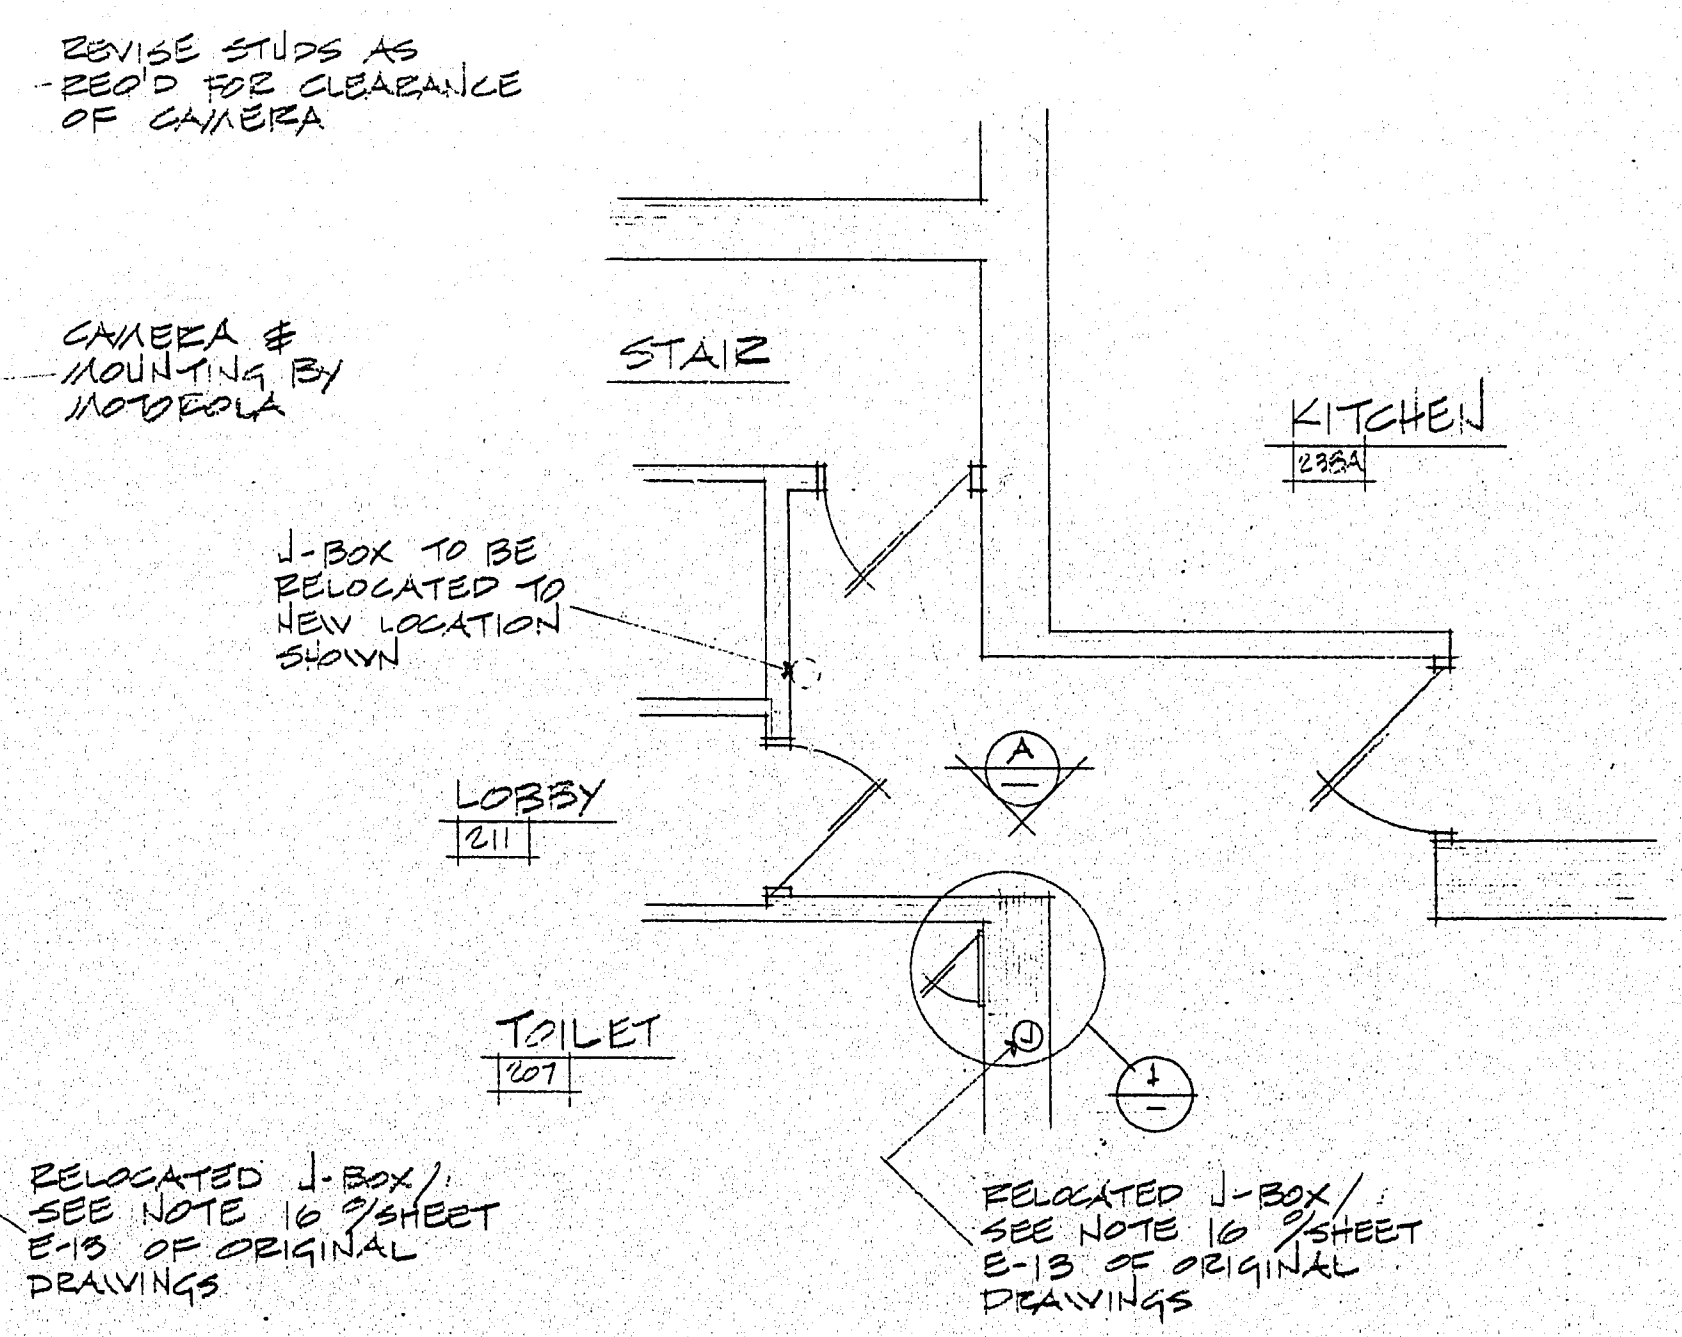

PLAN AT CAMERA LOCATION
1/4"