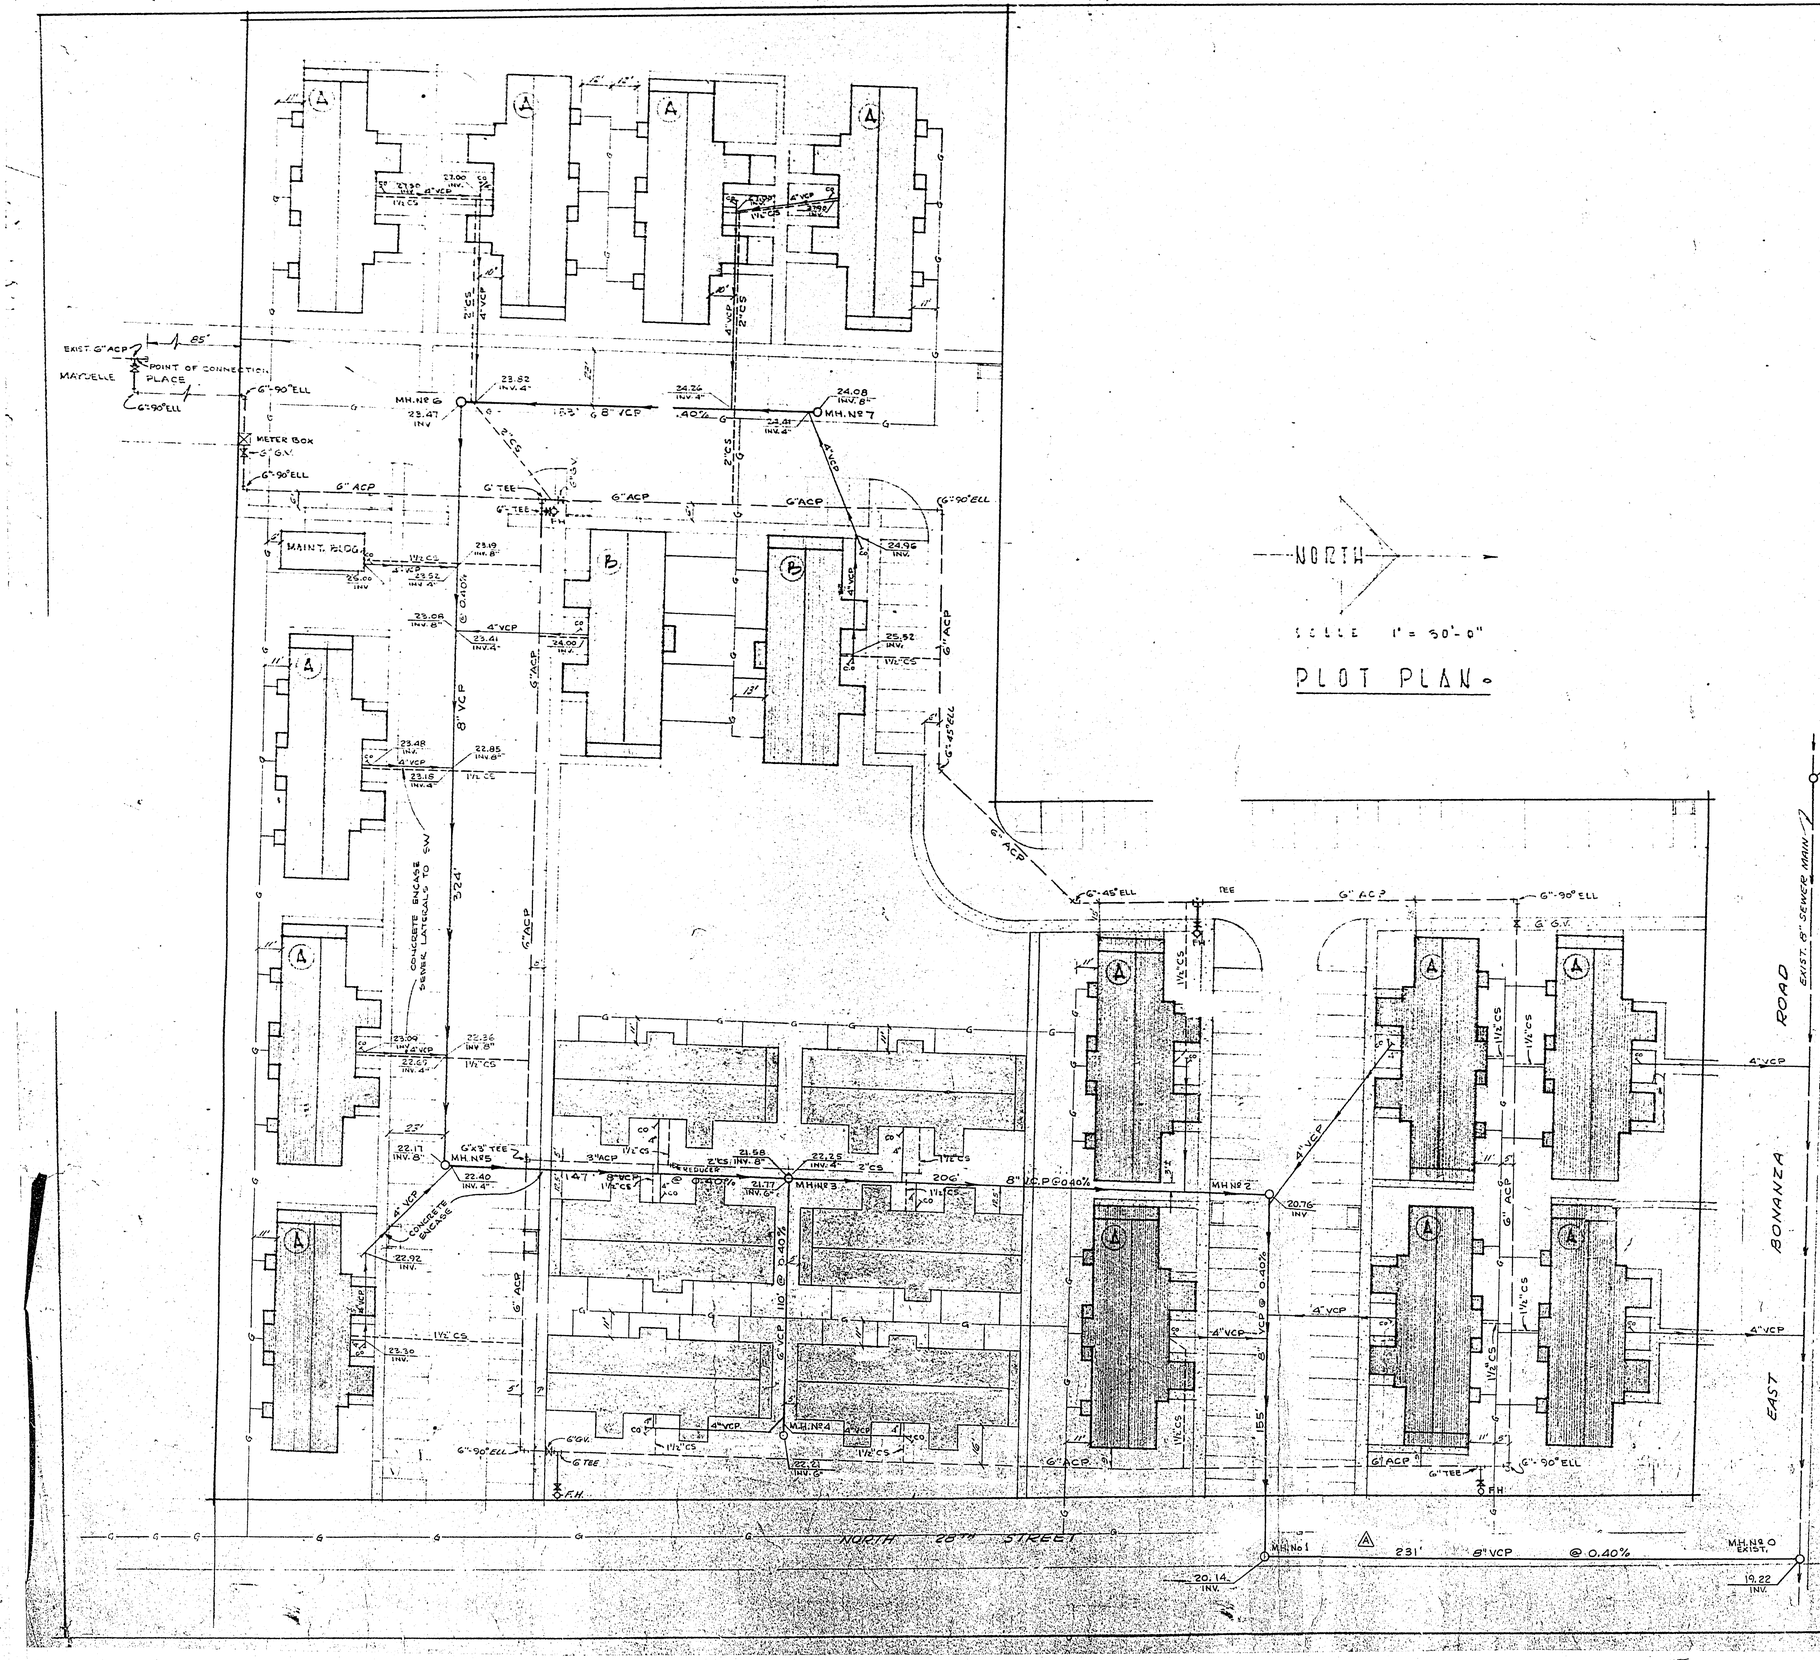

SIGNATURE BLOCK - DATE

V.B. Lehling	8/7/63
C.J. Williams	8/10/63

SEWER QUANTITIES

ON SITE		OFF SITE	
8" VCP	960 - Lin. ft.	8" VCP	241 - Lin. ft.
6" VCP	110 - Lin. ft.	MANHOLE	1 - Each
4" VCP	1185 Lin. ft.	4" VCP	91 - Lin. ft.
MANHOLE	6 - Each		
CLEANOUT	25 - Each		
CONC. ENCASEM'T	129 Lin. ft.		

WATER DISTRIBUTION QUANTITIES

ON SITE		OFF SITE	
6" ACP	1788 Lin. ft.	6" ACP	100 - Lin. ft.
3" ACP	65 Lin. ft.	6" TAP, TEE & VALVE	1 - Each
2" C.S.	370 Lin. ft.	6" L 90° ELL	1 - Each
1½" C.S.	689 Lin. ft.		
F.H. ASSEMBLY	4 Each		
6" Valve	4 Each		
Plus Misc. Fittings, etc.			
6" Meter & Box	1 Each		

NOTE - The above quantities were computed to building line.

LEGEND

- Sewer line
- Water line
- Clean out
- Manhole
- Fire Hydrant
- Copper Service (Size as shown)
- Sewer Invert
- Gate Valve
- Gas Distribution System to be installed by local utility company to meet applicable requirements. Each unit to be metered at bldg.

Note: Sewer services to have 90° cover @ 1% min. line except as shown.

△ REVISED - M.H. No. 1 - LOCATION - RJL:RK - 7/31/63

PLUMBING PLOT PLAN.

APPROVED: Rick Kramer
APPROVED: 8-5-63

JULIUS GABRIELE A.I.A. AND ASSOCIATES ARCHITECTS & ENGINEERS 1420 LAS VEGAS BOULEVARD SOUTH LAS VEGAS, NEVADA DU 4-2052	DRAWN:	JOB NUMBER: G2-63	SHEET NO. 26
	DO NOT SCALE DRAWINGS		
	CHECKED BY:	DATE: 15 DEC 62	OF 32

DRAWINGS AND SPECIFICATIONS — AS INSTRUMENTS OF SERVICE — ARE THE PROPERTY OF THE ARCHITECT WHETHER THE WORK FOR WHICH THEY ARE MADE BE EXECUTED OR NOT AND MAY NOT BE USED ON OTHER WORK EXCEPT BY AGREEMENT WITH THE ARCHITECT.