



KASPER PARK UNIT N° 3

BEING A PORTION OF THE N.E.1/4 OF THE SW.1/4 OF SEC. 22, T20S, R61E, M.D.B.&M.
CITY OF LAS VEGAS, COUNTY OF CLARK, STATE OF NEVADA

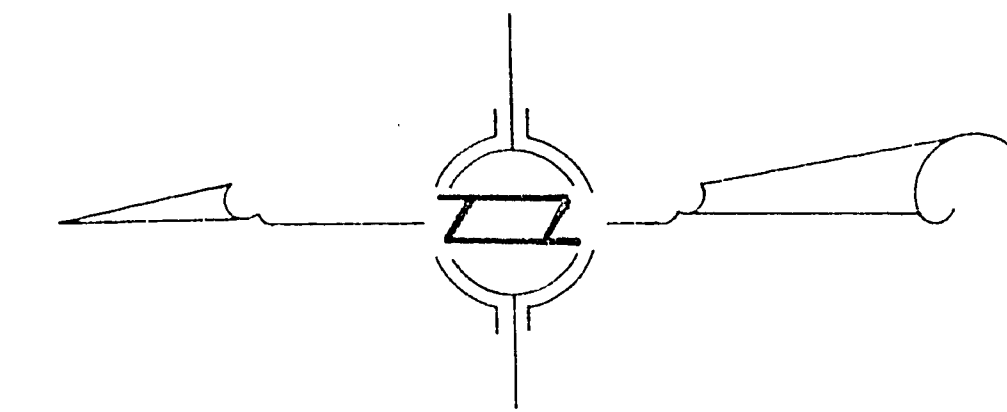

SCALE IN FEET
60 40 0 80 160 240

●..... SET CONCRETE MONUMENT TAGGED R.E. 560
REFERENCE TIES ARE MARKED BY (X) CUT IN TOP OF CURB.

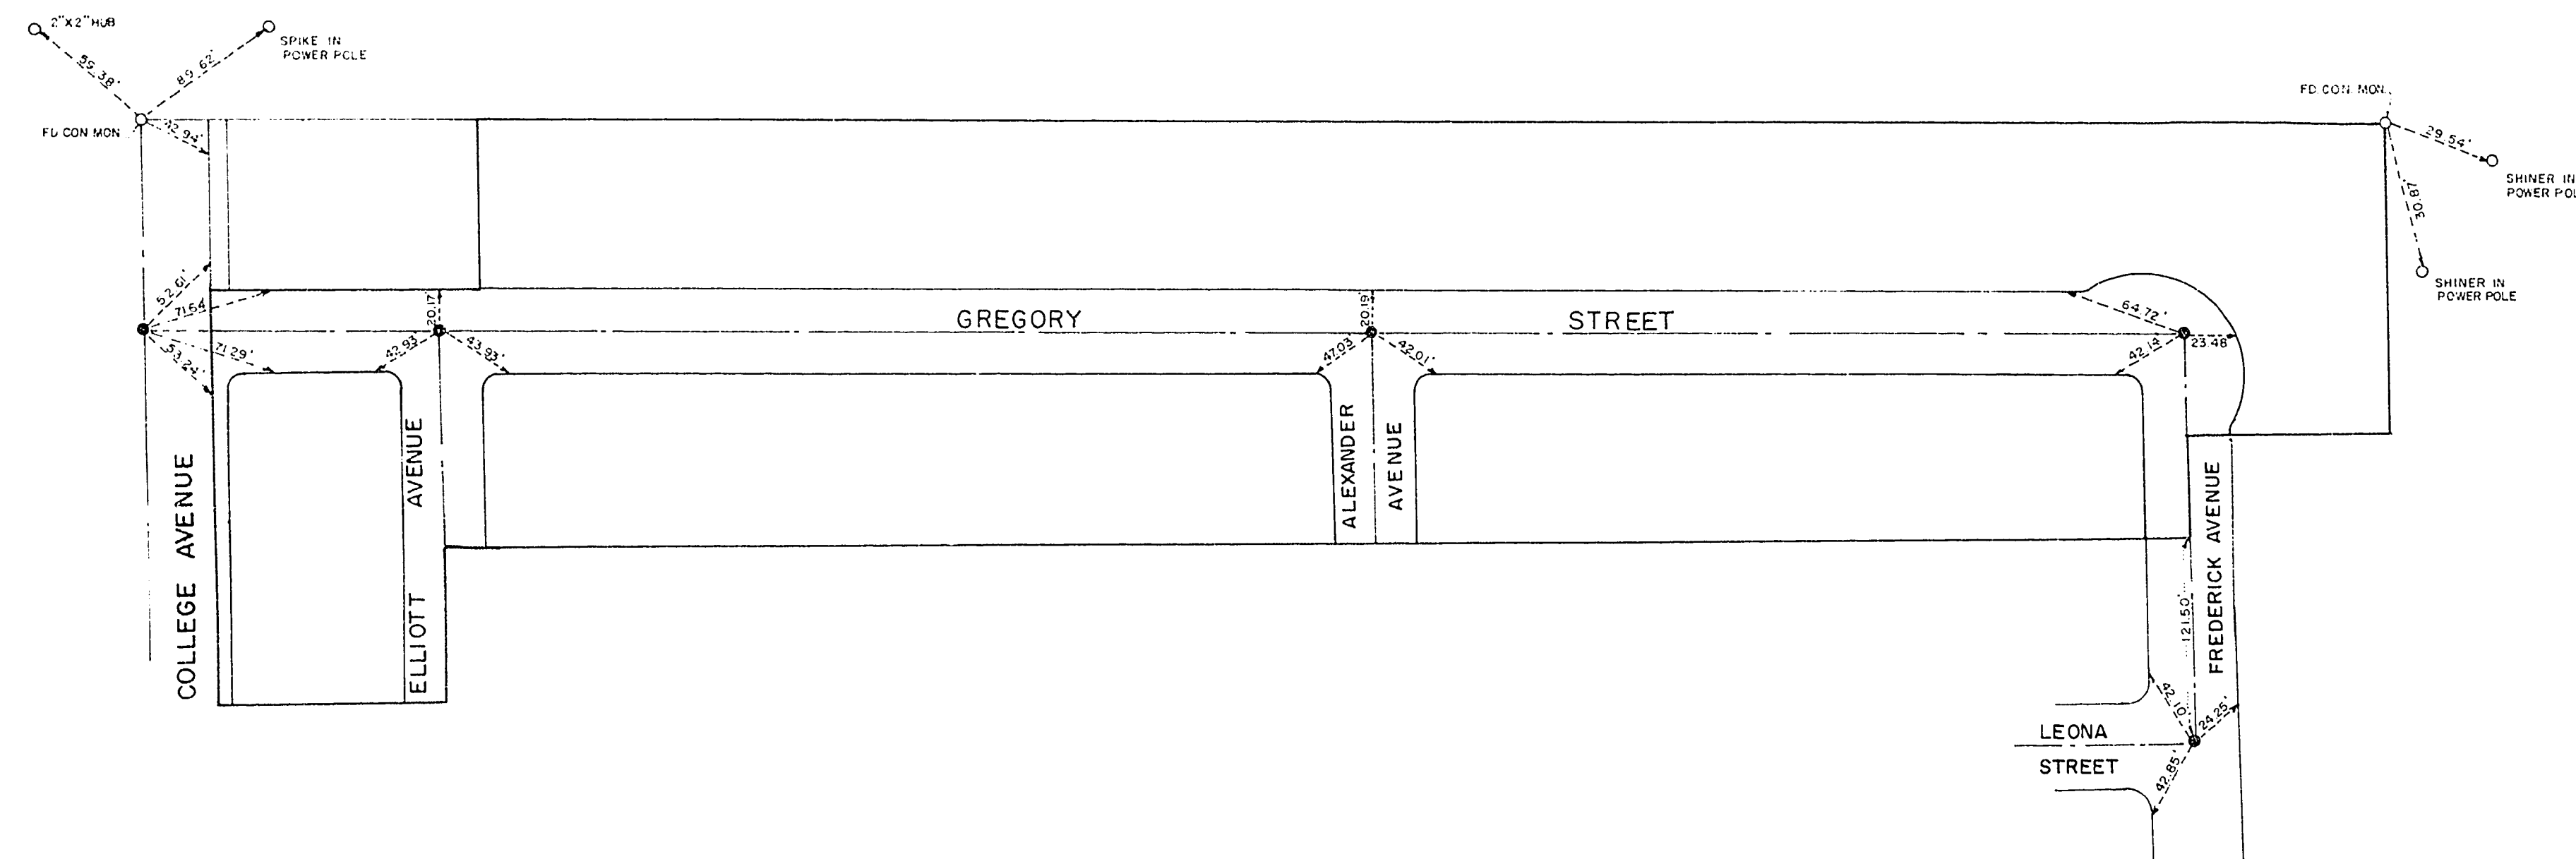


MONUMENT TIES KASPER PARK UNIT N° 3

DESIGNED BY	SCALE	DATE	18	19	63
DRAWN BY	AS SHOWN	TYSON ENGINEERING COMPANY			
CHECKED BY	B.J.V.	CONSULTING ENGINEERS			
		1209 COMMERCE STREET LAS VEGAS, NEV.			
		OF 1 SHEETS			

KASPER PARK UNIT N° 3

CITY OF LAS VEGAS, COUNTY OF CLARK, STATE OF NEVADA

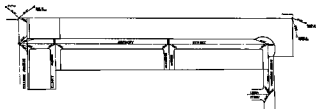

1" = 400' 0" HORIZONTAL SCALE
1" = 100' 0" VERTICAL SCALE

MONUMENT TIES
KASPER PARK
UNIT N° 3

